

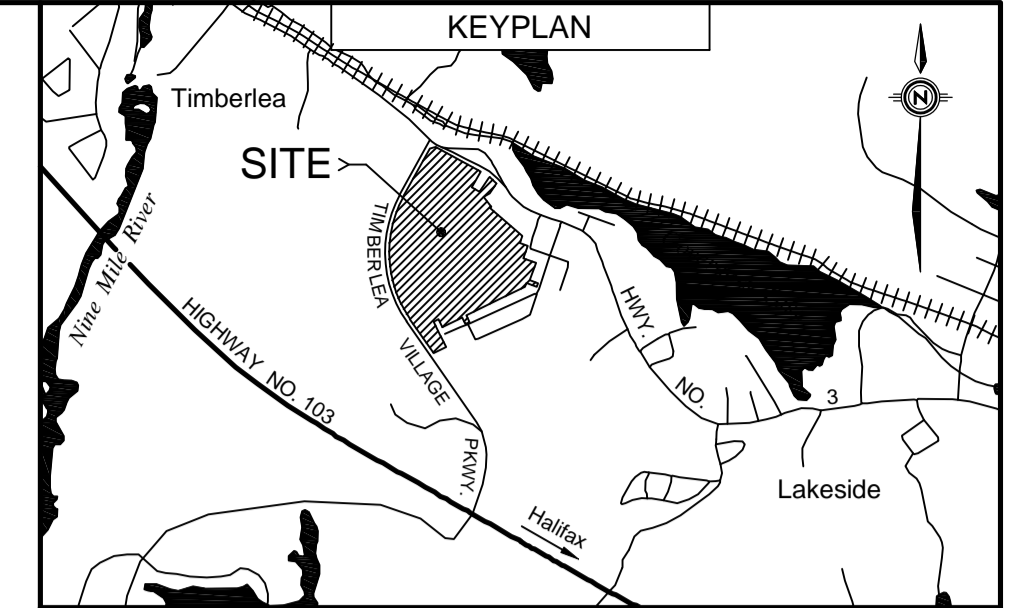



CATCHBASIN SCHEDULE					
LABEL	TOP OF GRATE ELEV.	INV. OUT	INV. @ MH	PIPE OUT SIZE / TYPE	ICD (mm)
CB106A	108.030	105.550	105.340 @ MAIN	200mm PVC DR35	101.2 (4")
CB106B	108.060	105.720	105.360 @ MAIN	200mm PVC DR35	64 (2.5")
CB110A	107.970	105.720	105.160 @ MAIN	300mm PVC DR35	114 (4.5")
CB110B	107.920	105.900	105.180 @ MAIN	200mm PVC DR35	76.2 (3")
CB114	108.290	106.960	104.840 @ MAIN	200mm PVC DR35	76.2 (3")
CB119C	104.390	102.800	100.540 @ MAIN	200mm PVC DR35	120.7 (4.75")
CB119D	104.470	102.950	101.530 @ MHT119	200mm PVC DR35	89 (3.5")

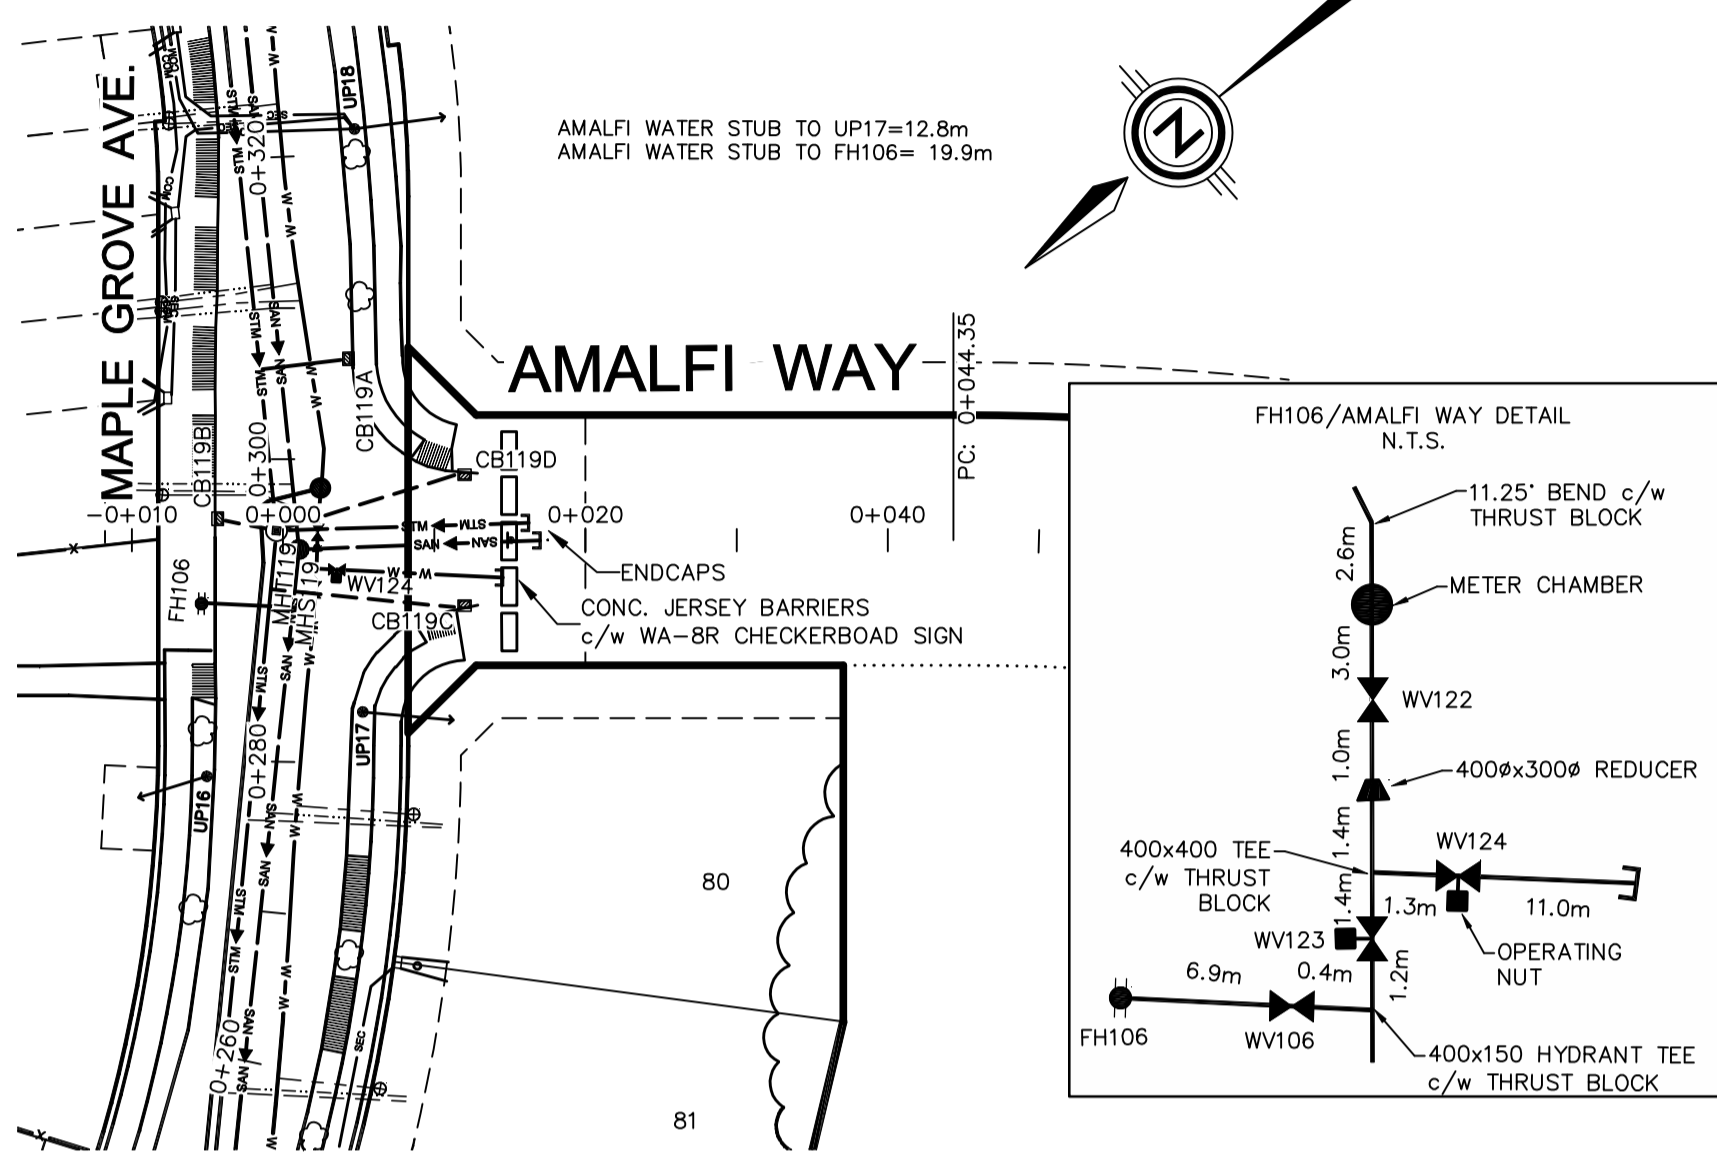


LEGEND	
CONSTRUCTED	PRE-EXISTING
WATERMAIN & GATE VALVE	EW - 60
SANITARY MANHOLE & PIPE	ESAN - 60 - 100
STORM MANHOLE & PIPE	ESTM - 60 - 100
POWER/COMMUNICATIONS	ECH - 100
EDGE OF PAVEMENT	ECB
LOTLINE	
PROFILE GRADE	
STREET BOUNDARY	SANITARY LATERAL
PROPERTY BOUNDARY	STORM LATERAL
FLOW DIRECTION ARROW	WATER LATERAL
DRIVEWAY CUT	CATCH BASIN LEAD
SWALE/DITCH	HEADWALL
CATCH BASIN	ENDCAP
ARV CHAMBER	LIGHT STANDARD
FIRE HYDRANT	ROAD SIGN
STREET TREE	ALIANT PEDESTAL
UTILITY POLE	NSP URD BOX
	CULVERT
	EASEMENT
	SHOULDER
	CURB
	SIDEWALK
	FENCE

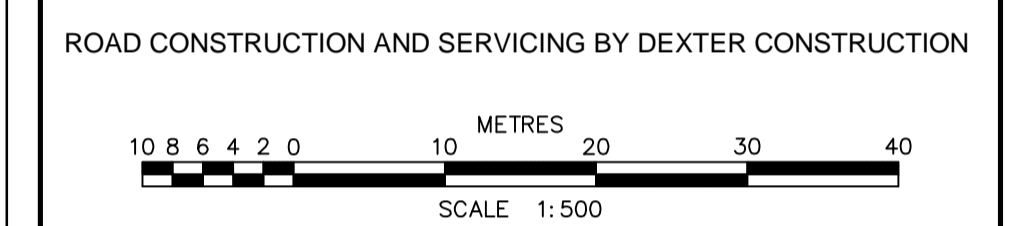

NO.	DESCRIPTION	CHK'D	DATE
6	FINAL RECORD DRAWING		25-NOV-2011
5	RECORD DRAWING		08-SEP-2011
4	ISSUED FOR CONSTRUCTION		08-FEB-2011
3	ISSUED FOR CONSTRUCTION		07-JAN-2011
2	REVISED AS PER HRM & HW COMMENTS		04-NOV-2010
1A	ISSUED TO CONTRACTOR		02-NOV-2010
1	REVISED AS PER HRM & HW COMMENTS		18-AUG-2010
0	ISSUED FOR REVIEW		30-APR-2010

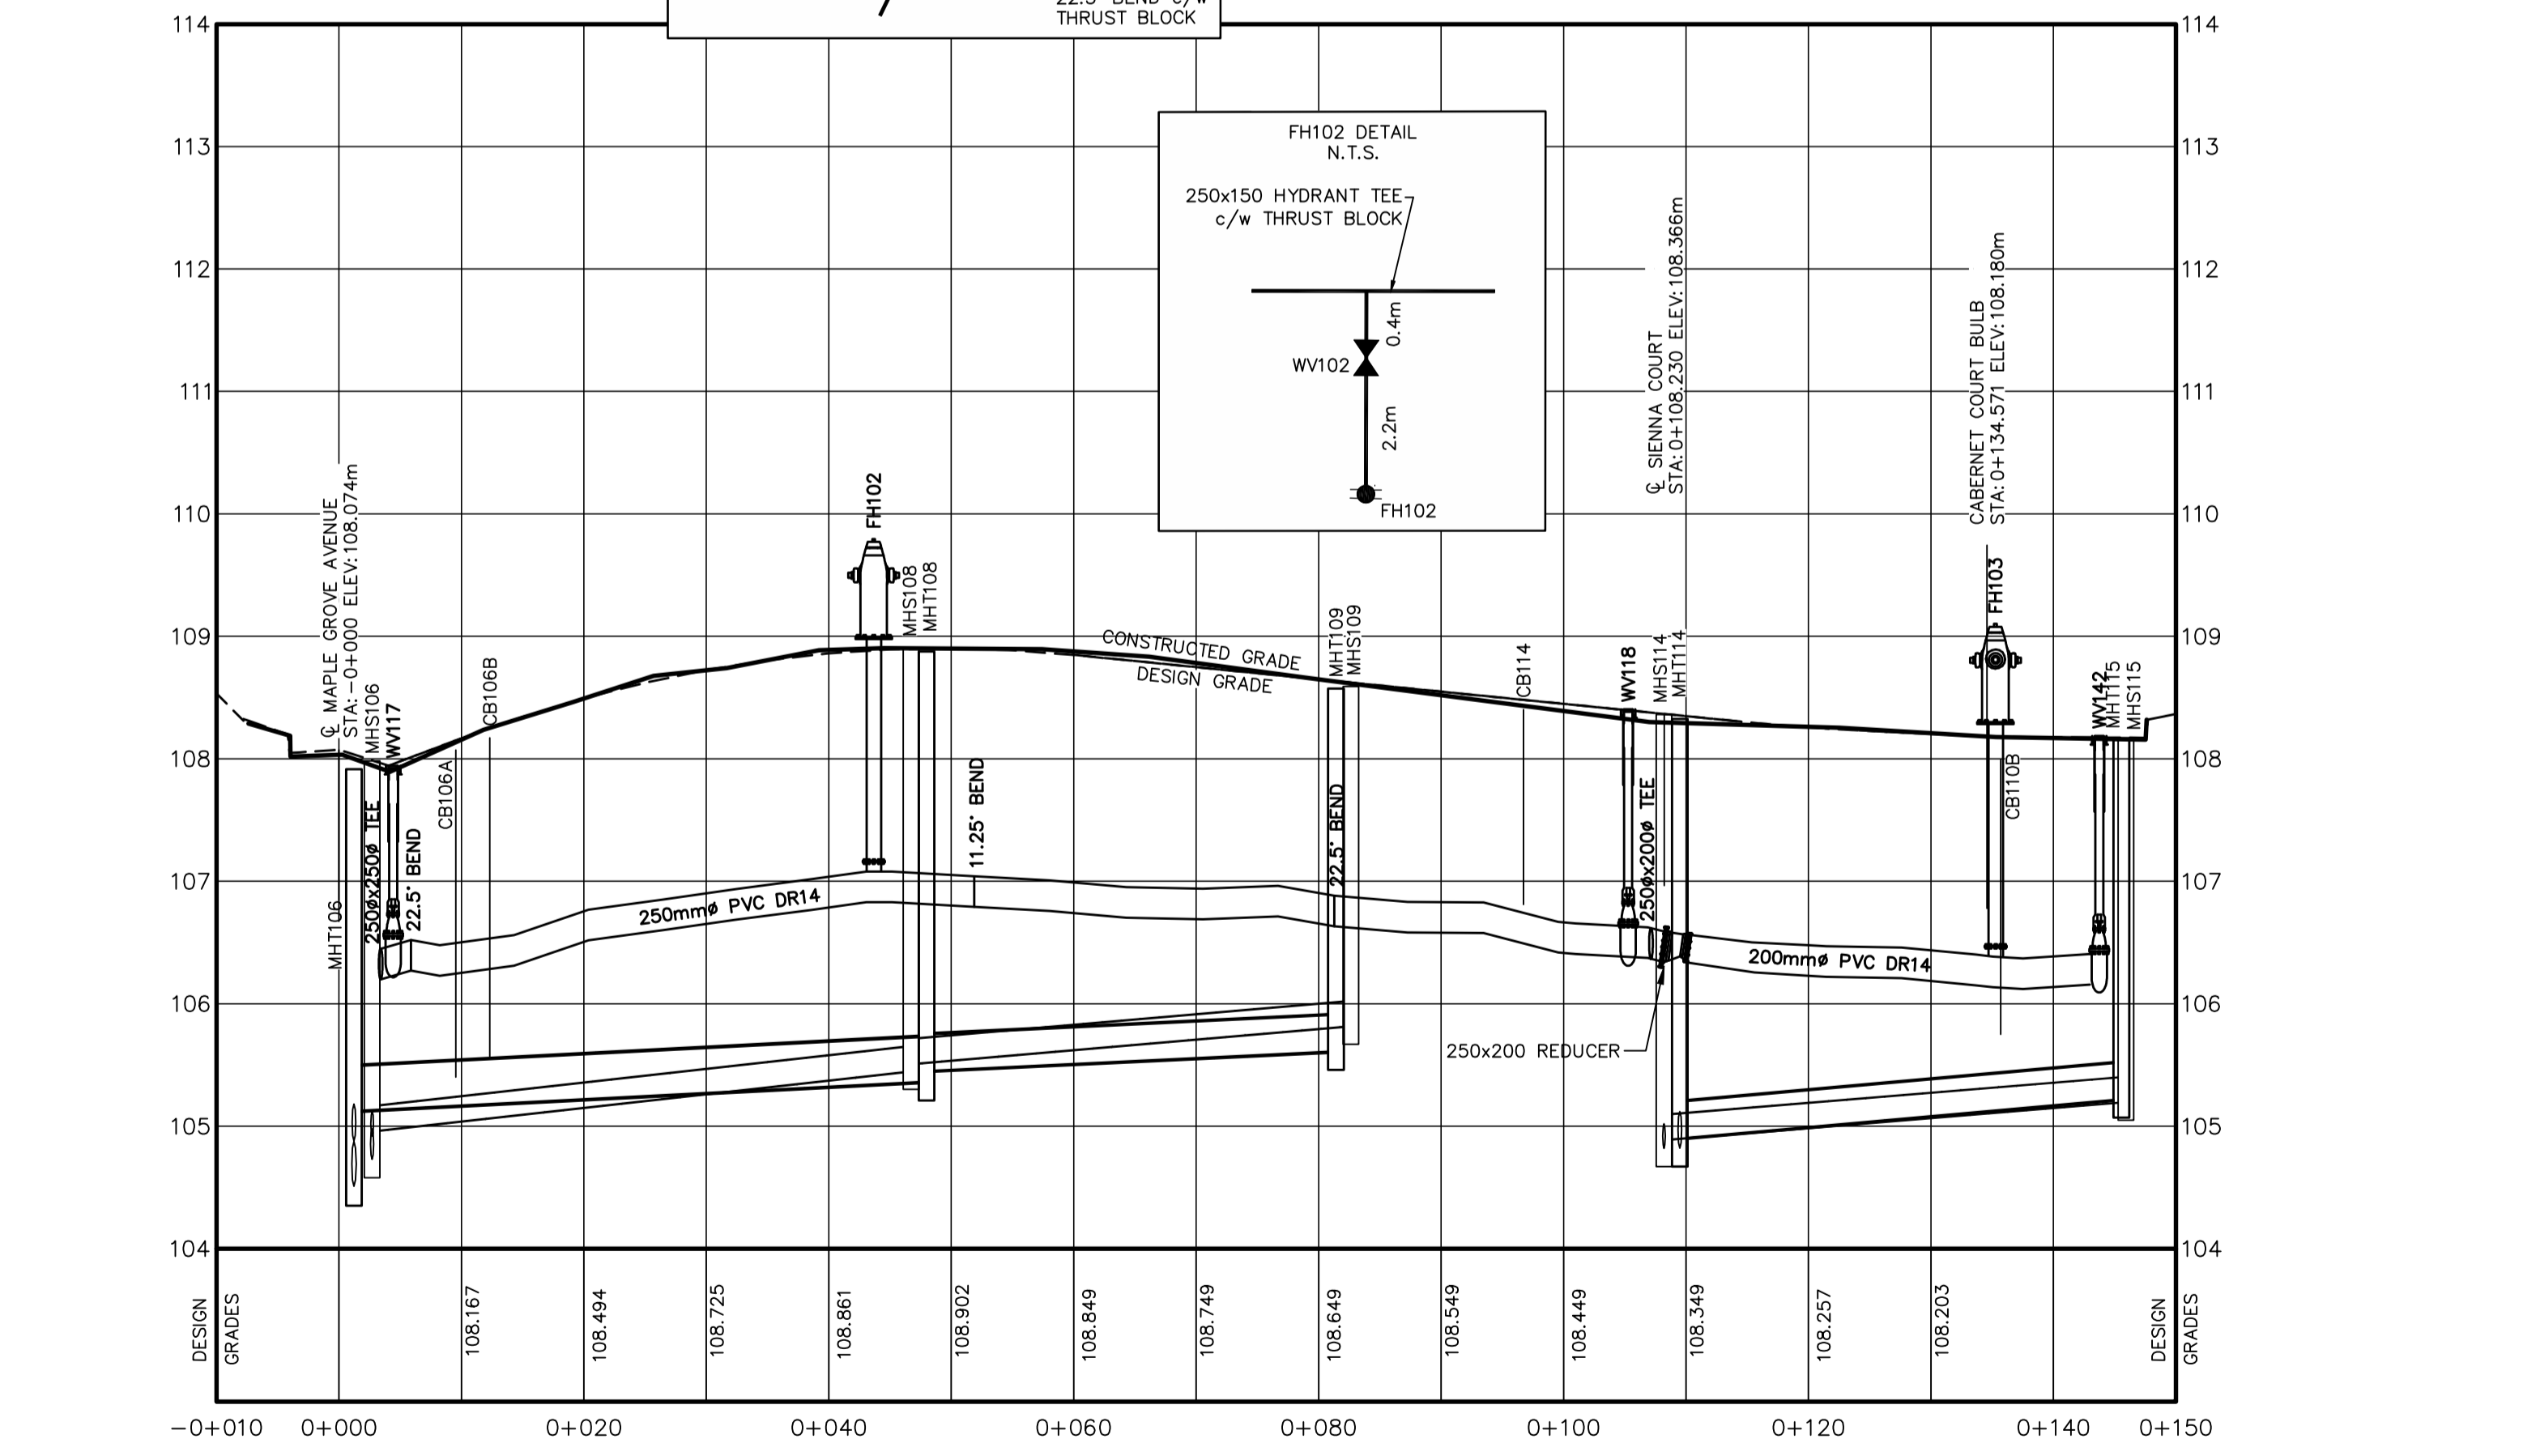

SANITARY INVERT	104.960	105.450	105.920	105.200
SANITARY GRADE	44.018m ± 200mm @ PVC DR35 @ 1.11%	35.982m ± 200mm @ PVC DR35 @ 0.86%	37.721m ± 200mm @ PVC DR35 @ 0.82%	
STORM GRADE	46.796m ± 375mm @ PVC DR35 @ 0.51%	34.086m ± 300mm @ PVC DR35 @ 0.47%	36.050m ± 300mm @ PVC DR35 @ 0.89%	
STORM INVERT	105.120	105.360	105.610	105.220

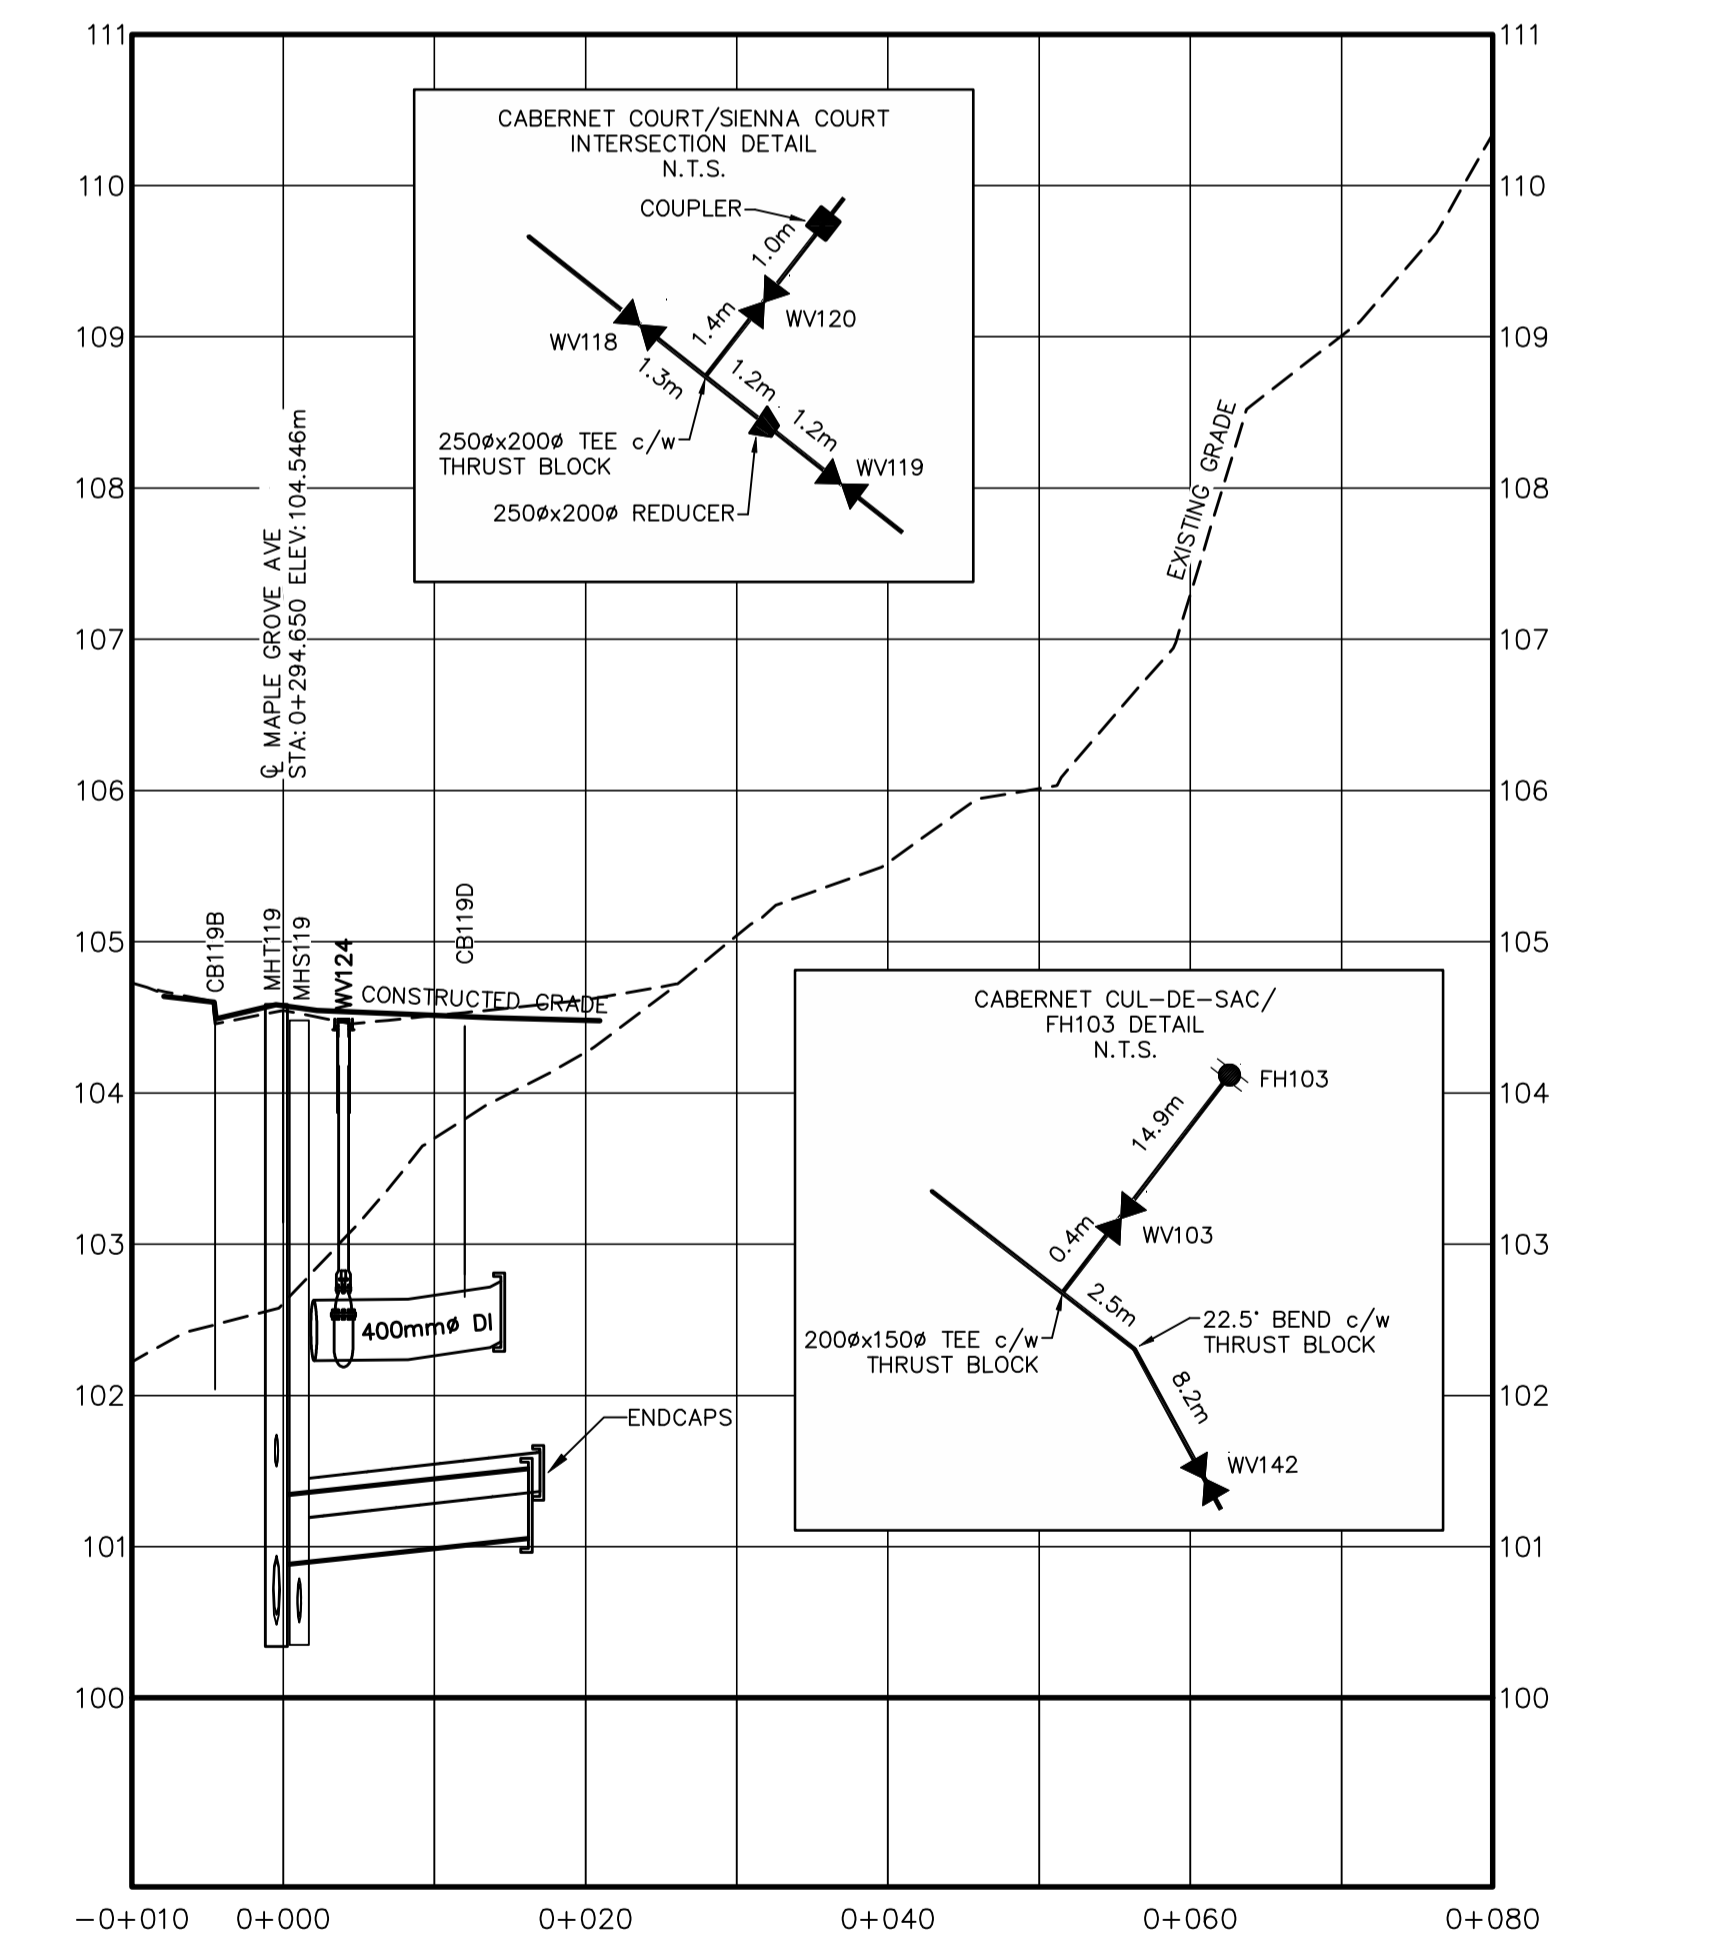

SANITARY INVERT	101.190	101.370
SANITARY GRADE	15.941m ± 250mm @ PVC DR35 @ 1.13%	
STORM GRADE	16.688m ± 450mm @ PVC DR35 @ 1.08%	
STORM INVERT	100.880	101.060

GENIVAR

1 SPECTACLE LAKE DRIVE
DARTMOUTH, NOVA SCOTIA
CANADA, B3B 1X7
PHONE: 902 835-9955 - FAX: 902 835-1645
WWW.GENIVAR.COM

REGISTERED PROFESSIONAL ENGINEER
L. H. Weimer
8823
PROVINCE OF NOVA SCOTIA

CLIENT
NINE MILE RIVER INVESTMENTS LTD.
HALIFAX, NOVA SCOTIA

PROJECT
BRUNELLO ESTATES PHASE 1
TIMBERLEA, NOVA SCOTIA

SHEET DESCRIPTION
PLAN AND PROFILE
CABERNET COURT / AMALFI WAY
STA -0+010 TO 0+150 / -0+010 TO 0+080

DATE: 30-APR-2010
HORIZ. SCALE: 1:500
VERT. SCALE: 1:50
DRAWN: CHLUTZ
CHECKED: LMACDONALD
DWG. NO.: 09109-006_001

SHEET
8
OF
26