
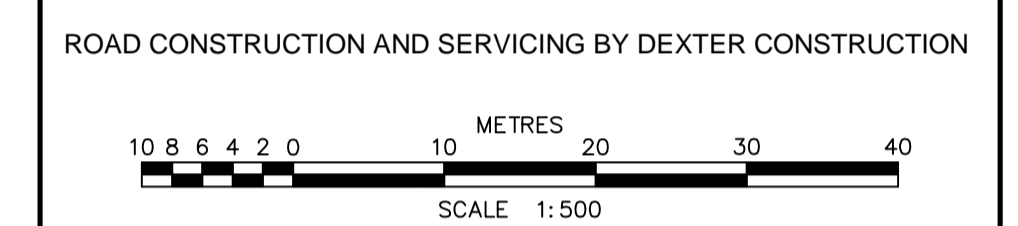
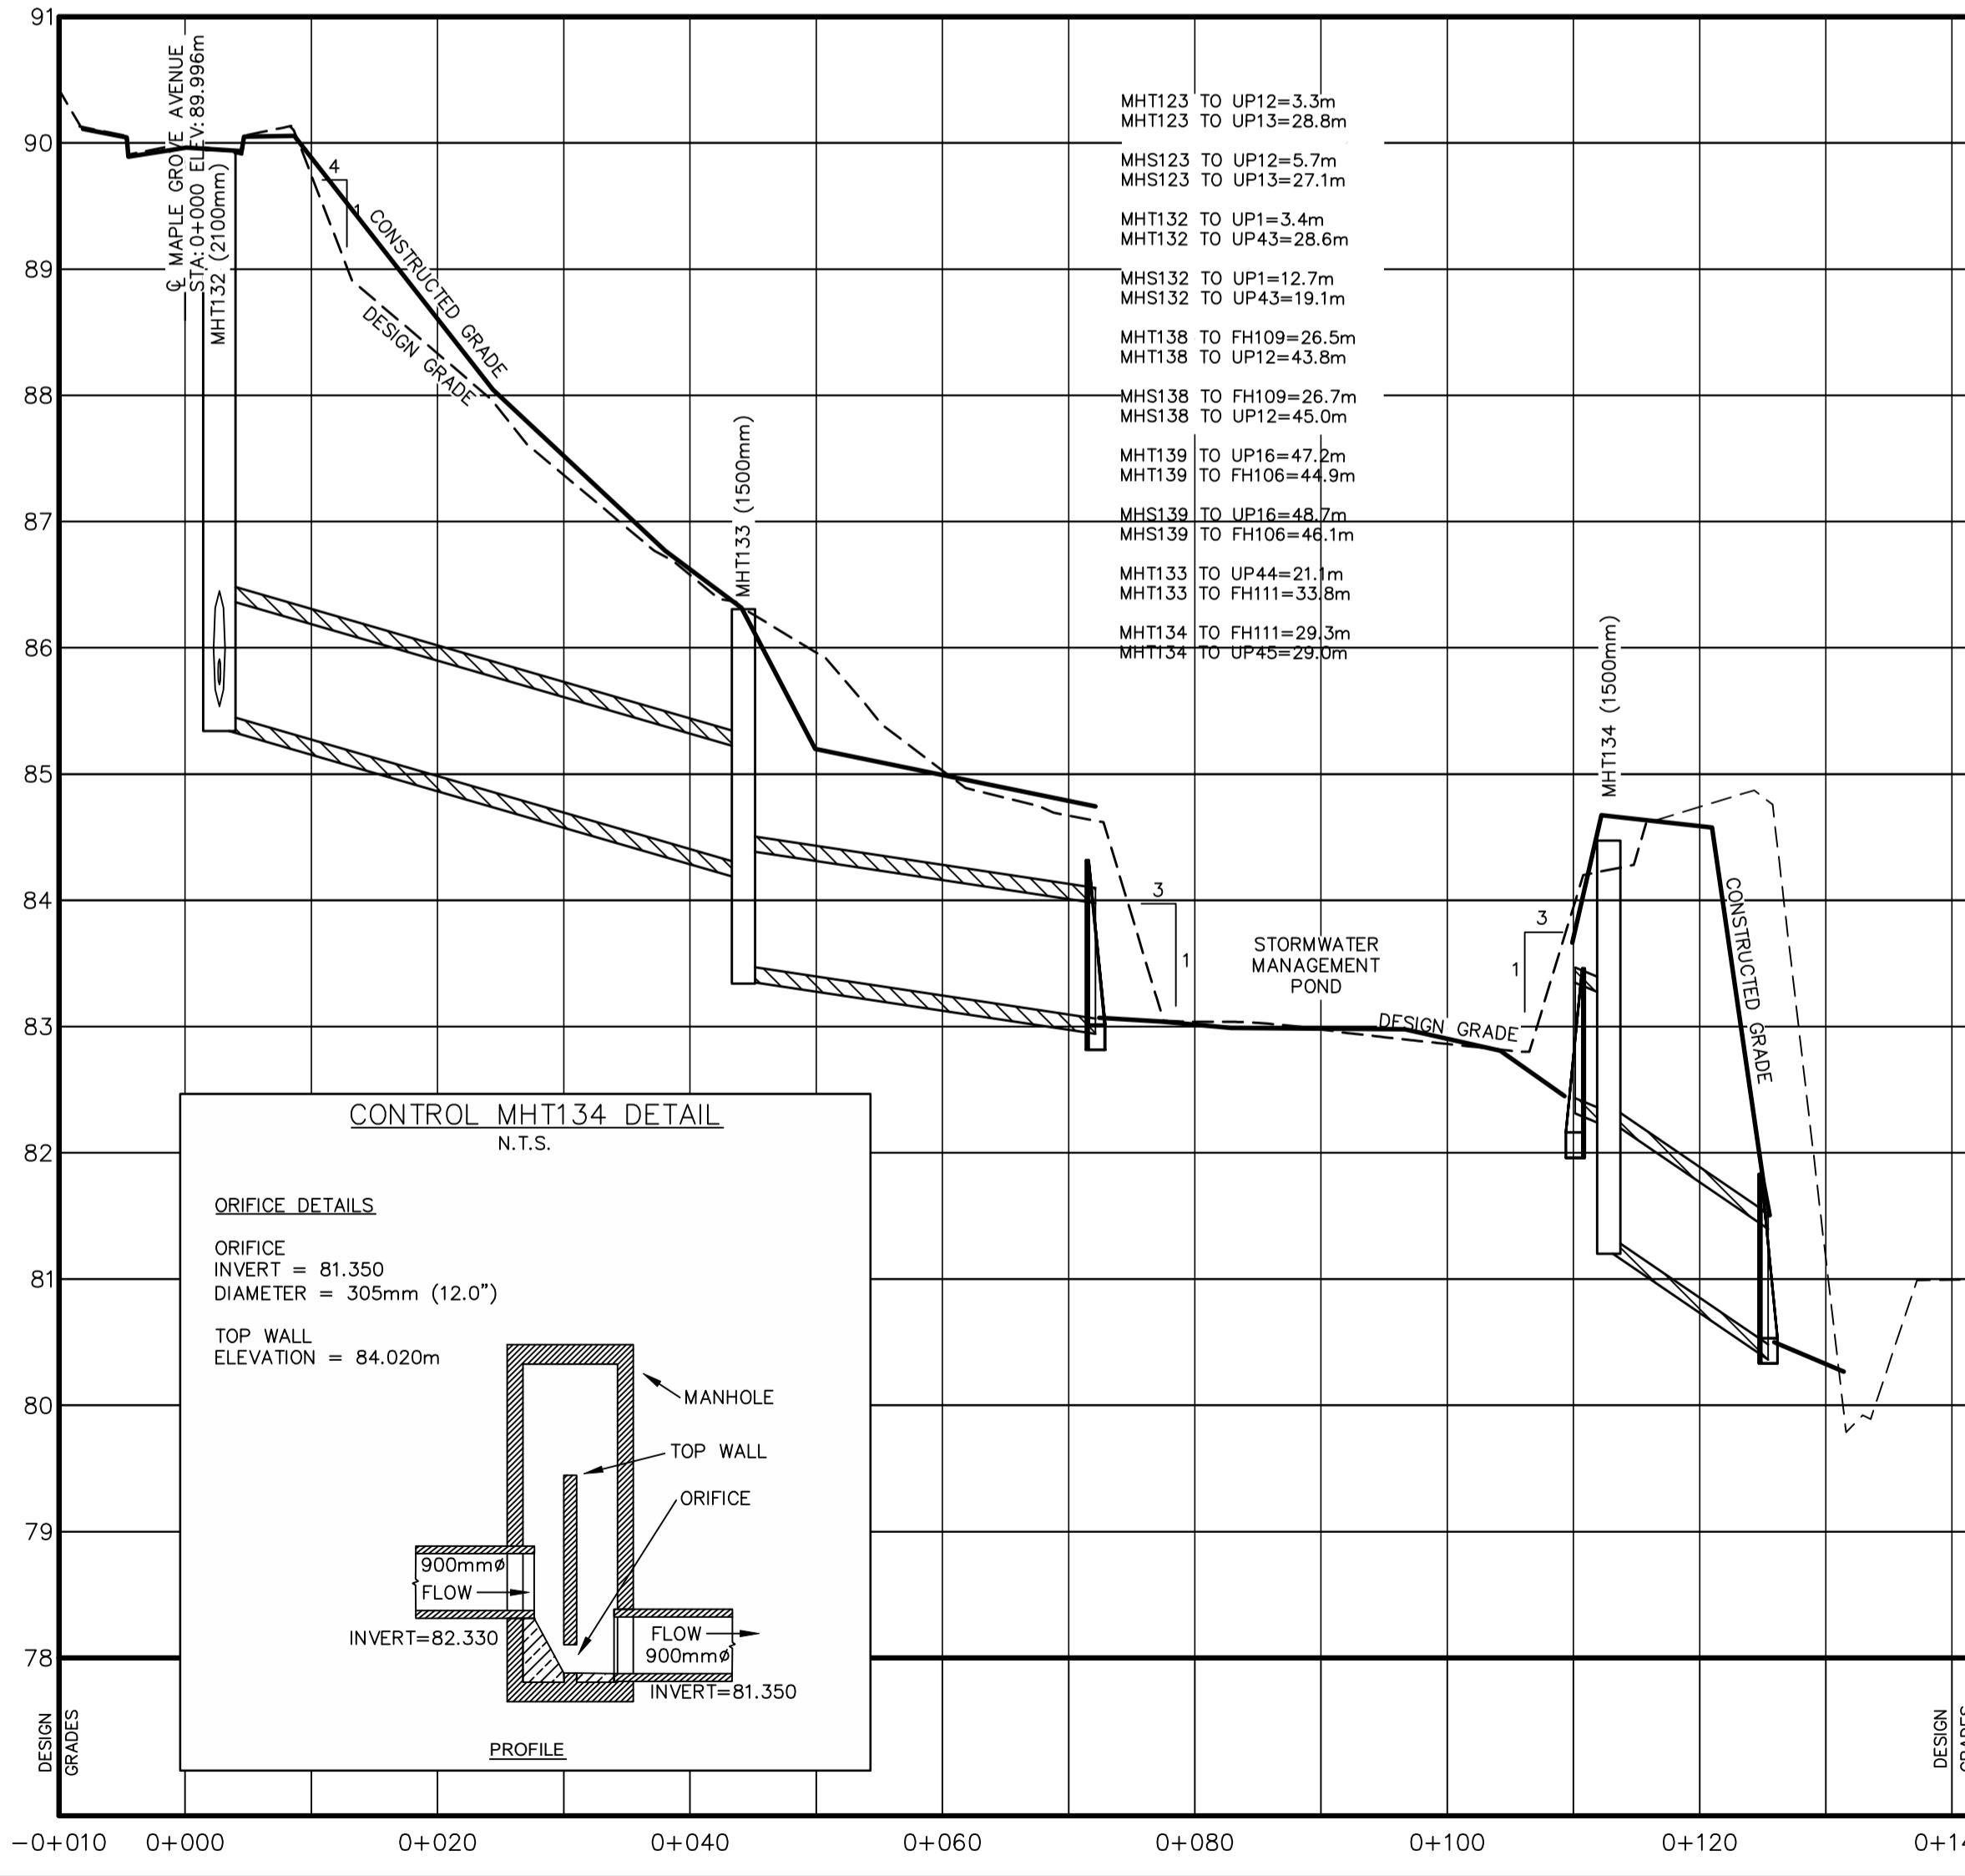


LEGEND

CONSTRUCTED		PRE-EXISTING	
WATERMAIN & GATE VALVE	—●—	EW - 103	—●—
SANITARY MANHOLE & PIPE	—○—	ESAN - 103	—○—
STORM MANHOLE & PIPE	—●—	ESTM - 103	—●—
POWER/COMMUNICATIONS	—○—	ECOM - 103	—○—
EDGE OF PAVEMENT	—	EL - 103	—
LOTLINE	—	EL - 103	—
PROFILE GRADE	—	EL - 103	—
STREET BOUNDARY	—	SANITARY LATERAL	—
PROPERTY BOUNDARY	—	STORM LATERAL	—
FLOW DIRECTION ARROW	→	WATER LATERAL	—
DRIVEWAY CUT	—	CATCH BASIN LEAD	—
SWALE/DITCH	—	HEADWALL	—
CATCH BASIN	—	ENDCAP	—
ARV CHAMBER	—	LIGHT STANDARD	—
FIRE HYDRANT	—	ROAD SIGN	—
STREET TREE	—	ALIANT PEDESTAL	—
UTILITY POLE	—	NSP URD BOX	—
		FENCE	—

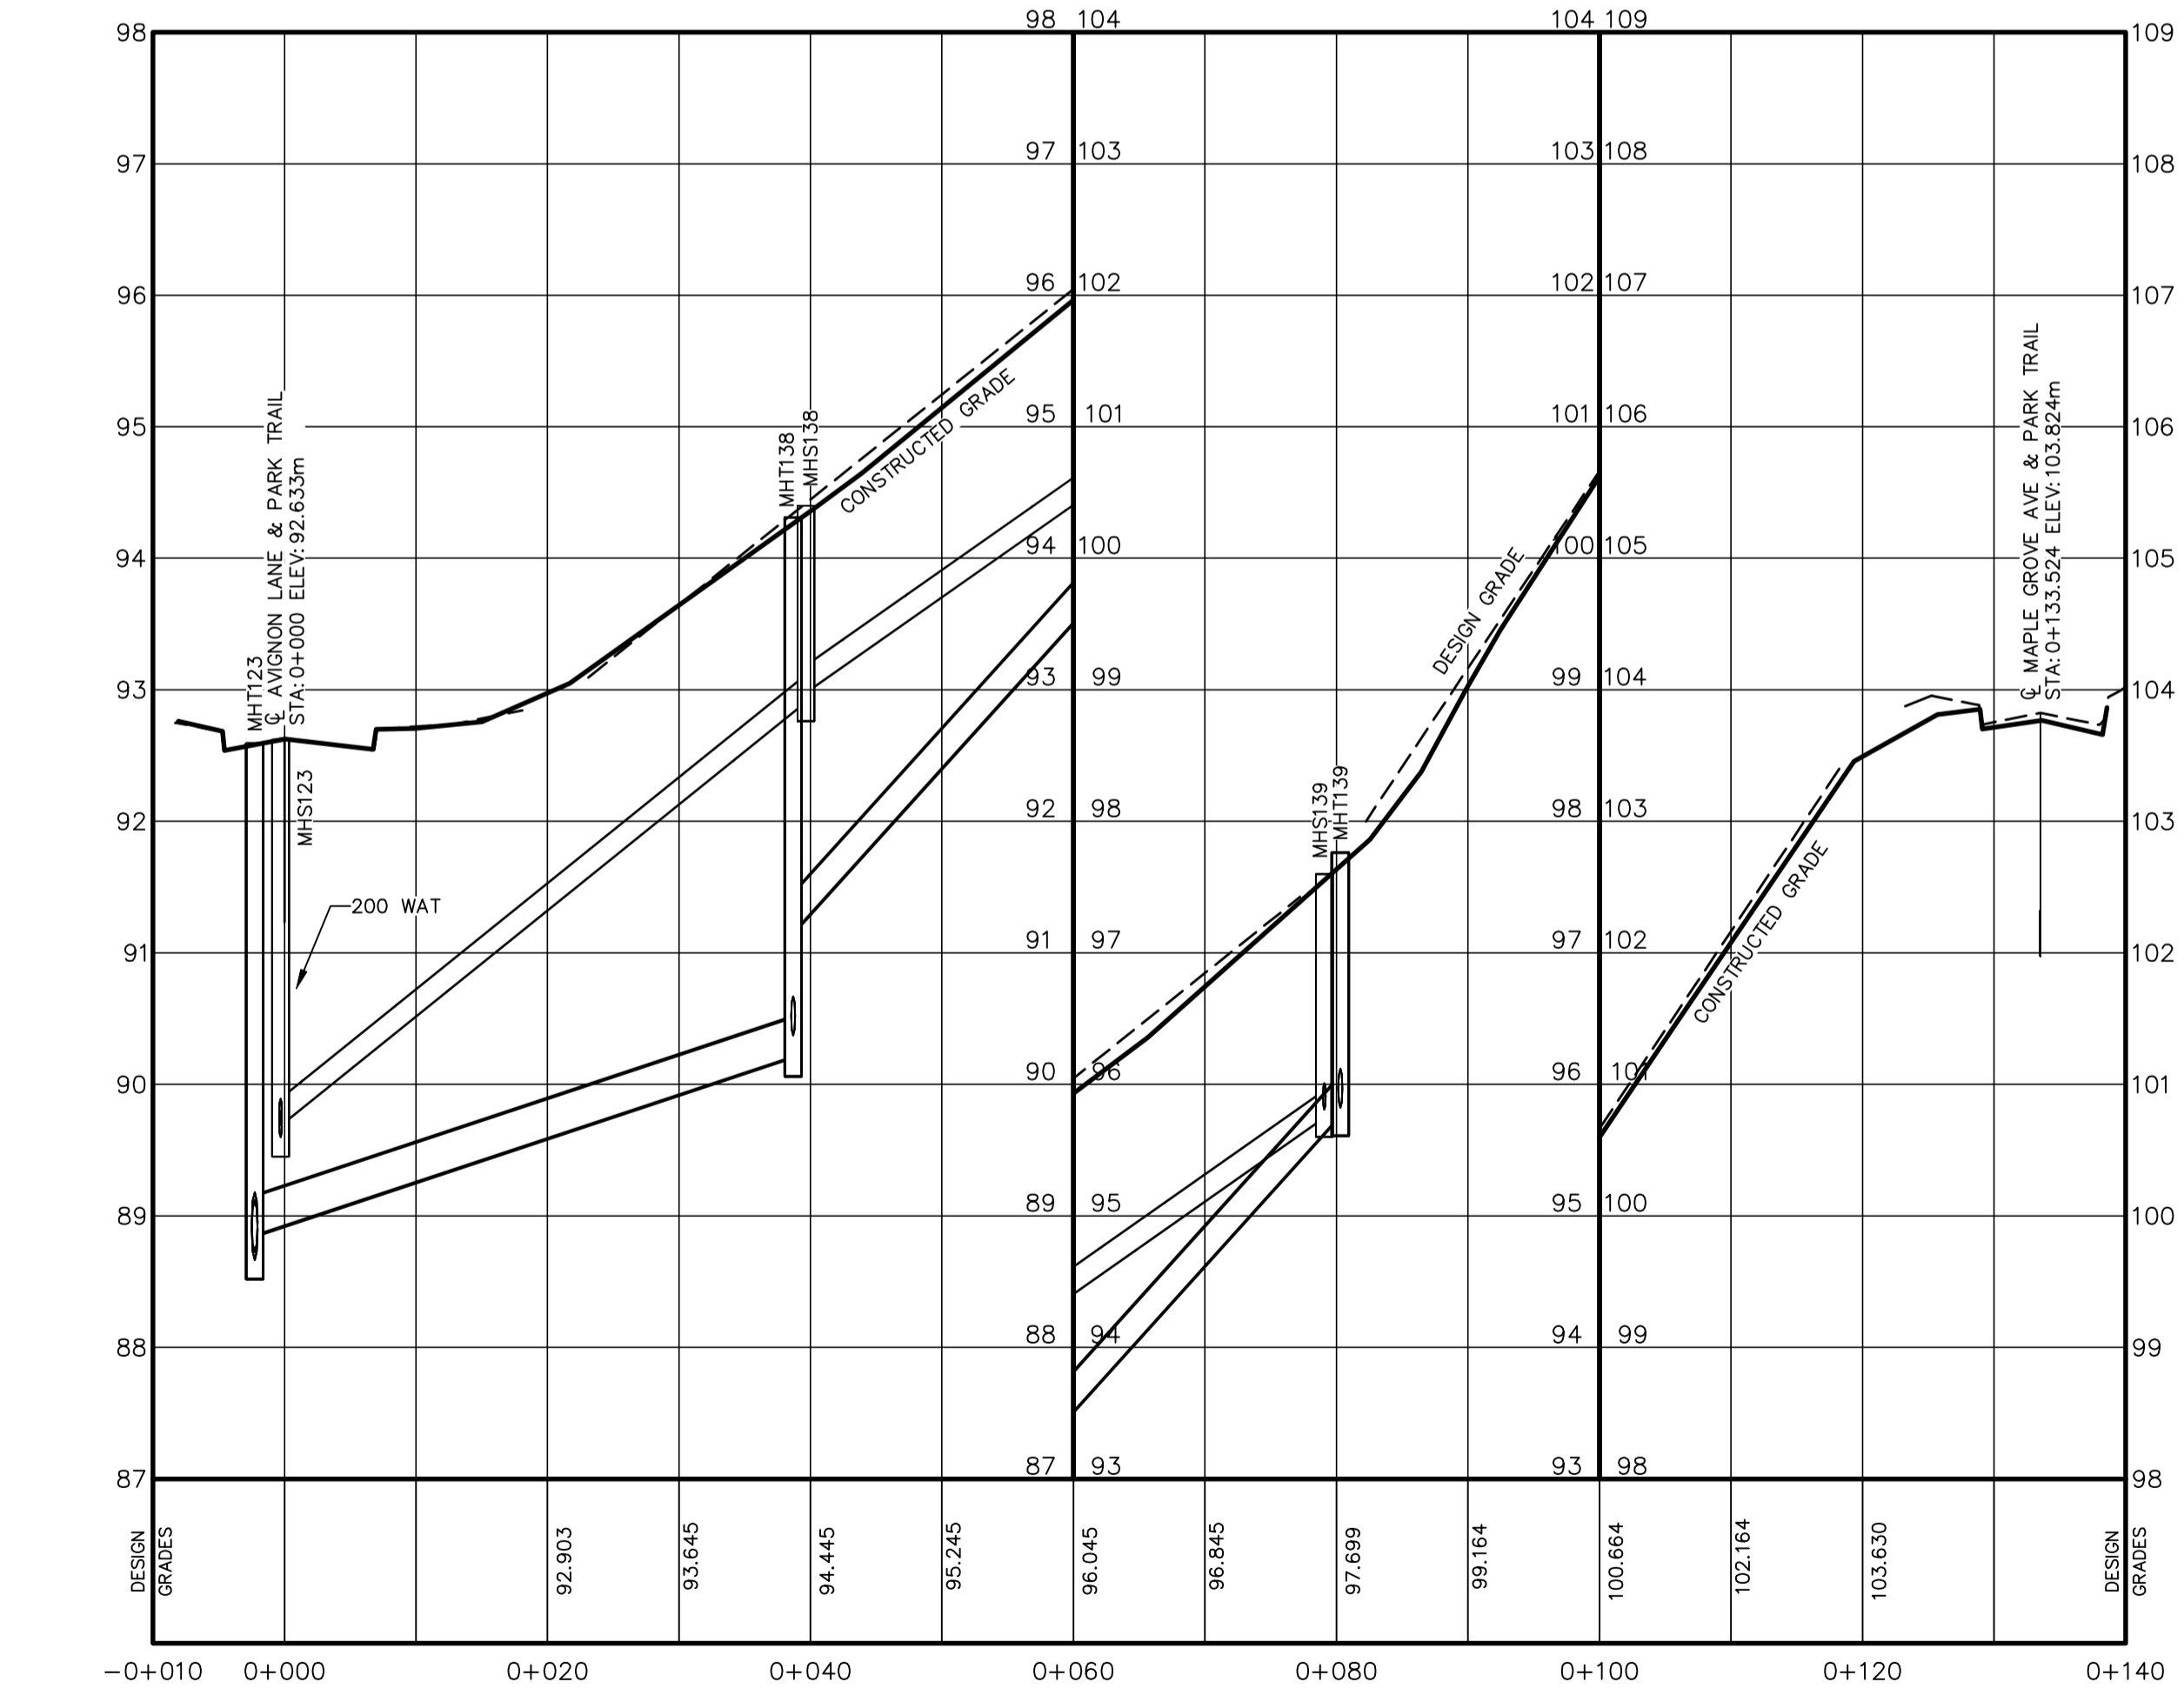

ROAD CONSTRUCTION AND SERVICING BY DEXTER CONSTRUCTION

NO.	DESCRIPTION	CHK'D	DATE
6	FINAL RECORD DRAWING		22-NOV-2011
5	RECORD DRAWING		INCOMPLETE
4	REISSUED FOR CONSTRUCTION		08-FEB-2011
3	ISSUED FOR CONSTRUCTION		07-JAN-2011
2	REVISED AS PER HRM & HW COMMENTS		04-NOV-2010
1A	ISSUED TO CONTRACTOR		02-NOV-2010
1	REVISED AS PER HRM & HW COMMENTS		18-AUG-2010
0	ISSUED FOR REVIEW		30-APR-2010

SANITARY INVERT	88.690	92.910	92.990	95.790
SANITARY GRADE	40.145m ± 200mm ² PVC DR35 @ 8.02%		39.476m ± 200mm ² PVC DR35 @ 7.02%	
STORM GRADE	40.961m ± 300mm ² PVC DR35 @ 3.32%		41.299m ± 300mm ² PVC DR35 @ 11.16%	
STORM INVERT	88.850	90.210	91.150	95.760

STORM GRADE	41.520m ± 900mm ² CSA A257.2 65D @ 2.89%	27.884m ± 900mm ² CSA A257.2 65D @ 1.51%	2.659m 900mm ² CSA A257.2 65D @ 4.14%	12.623m 900mm ² CSA A257.2 65D @ 6.81%
STORM INVERT	85.490	84.290	83.990	82.410

GENIVAR
1 SPECTACLE LAKE DRIVE
DARTMOUTH, NOVA SCOTIA
CANADA, B3B 1X7
PHONE: 902 835-9955 - FAX: 902 835-1645
WWW.GENIVAR.COM

REGISTERED PROFESSIONAL ENGINEER
L. H. Weimer
8823
PROVINCE OF NOVA SCOTIA

CLIENT
NINE MILE RIVER INVESTMENTS LTD.
HALIFAX, NOVA SCOTIA

PROJECT
BRUNELLO ESTATES PHASE 1
TIMBERLEA, NOVA SCOTIA

SHEET DESCRIPTION
PLAN AND PROFILE
PARK TRAIL / EASEMENT 101
STA -0+010 TO 0+140 / STA -0+010 TO 0+140

DATE: 30-APR-2010
HORIZ. SCALE: 1:500
VERT. SCALE: 1:50
DRAWN: CMLUTZ
CHECKED: LMACDONALD
DWG. NO.: D09109-005_001

SHEET
7
OF
26