


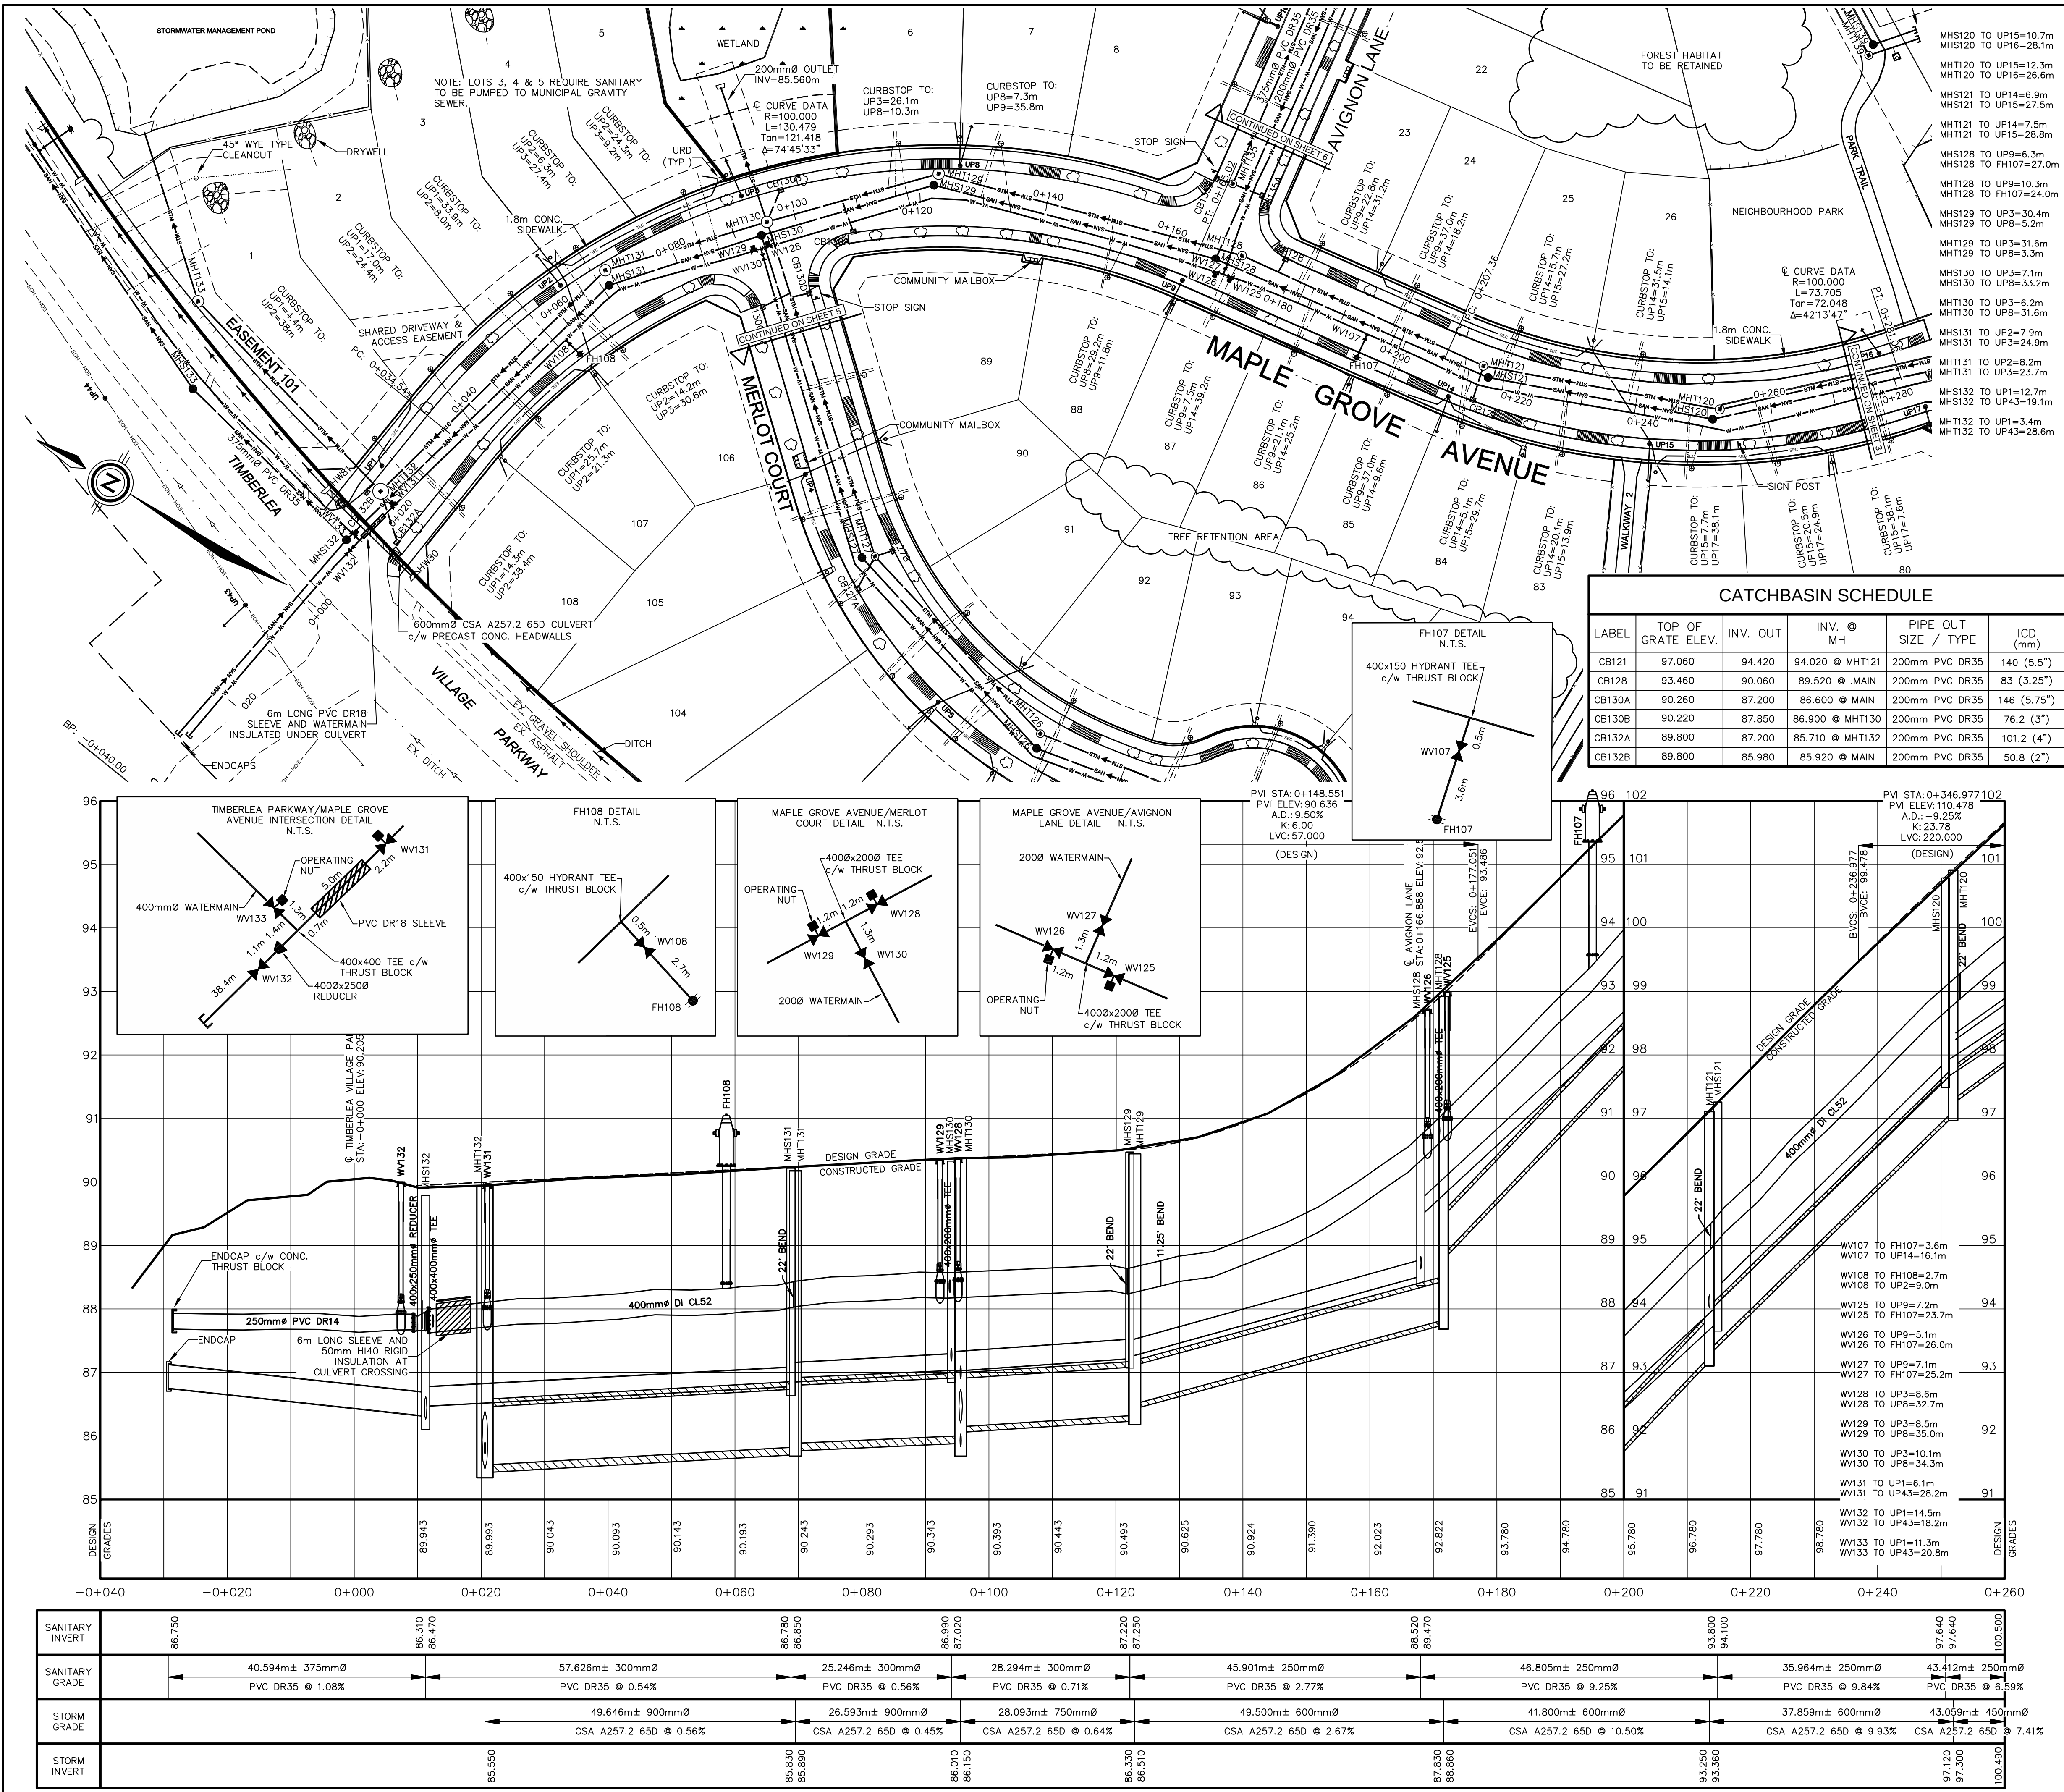

KEYPLAN

LEGEND

CONSTRUCTED	PRE-EXISTING
WATERMAIN & GATE VALVE	ESW - W3
SANITARY MANHOLE & PIPE	ESW - W3
STORM MANHOLE & PIPE	ESW - W3
POWER/COMMUNICATIONS	ESW - W3
EDGE OF PAVEMENT	ESW - W3
LOTLINE	ESW - W3
PROFILE GRADE	ESW - W3
STREET BOUNDARY	ESW - W3
PROPERTY BOUNDARY	ESW - W3
FLOW DIRECTION ARROW	ESW - W3
DRIVEWAY CUT	ESW - W3
SWALE/DITCH	ESW - W3
CATCH BASIN	ESW - W3
ARV CHAMBER	ESW - W3
FIRE HYDRANT	ESW - W3
STREET TREE	ESW - W3
UTILITY POLE	ESW - W3

ROAD CONSTRUCTION AND SERVICING BY DEXTER CONSTRUCTION

NO.	DESCRIPTION	CHK'D	DATE
6	FINAL RECORD DRAWING		25-NOV-2011
5	RECORD DRAWING		08-SEP-2011
4	REISSUED FOR CONSTRUCTION		04-FEB-2011
3	ISSUED FOR CONSTRUCTION		07-JAN-2011
2	REVISED AS PER HRM & HW COMMENTS		04-NOV-2010
1A	ISSUED TO CONTRACTOR		02-NOV-2010
1	REVISED AS PER HRM & HW COMMENTS		18-AUG-2010
0	ISSUED FOR REVIEW		30-APR-2010

CLIENT

NINE MILE RIVER INVESTMENTS LTD.

HALIFAX, NOVA SCOTIA

PROJECT

BRUNELLO ESTATES PHASE 1

TIMBERLEA, NOVA SCOTIA

SHEET DESCRIPTION

PLAN AND PROFILE

MAPLE GROVE AVENUE

STA -0+040 TO 0+260

DATE: 30-APR-2010

HORIZ. SCALE: 1:500

VERT. SCALE: 1:50

DRAWN: CMLUTZ

CHECKED: LMACDONALD

DWG. NO.: 09109-002

SHEET

2

OF

26