



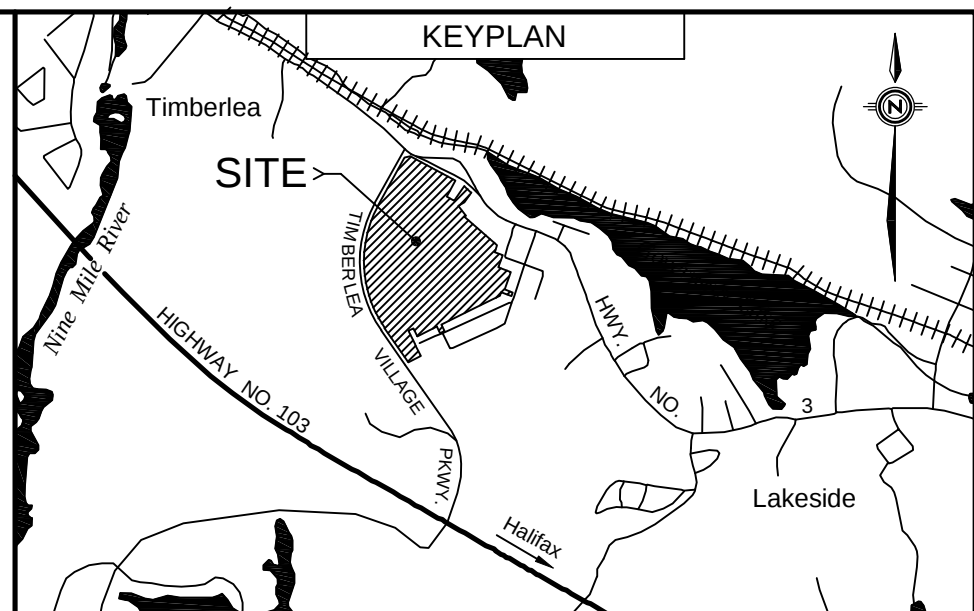


WV142 TO UP37=2.3m
WV142 TO FH103=20.6m
WMD TO UPA=7.9m
WMD TO UPB=36.0m

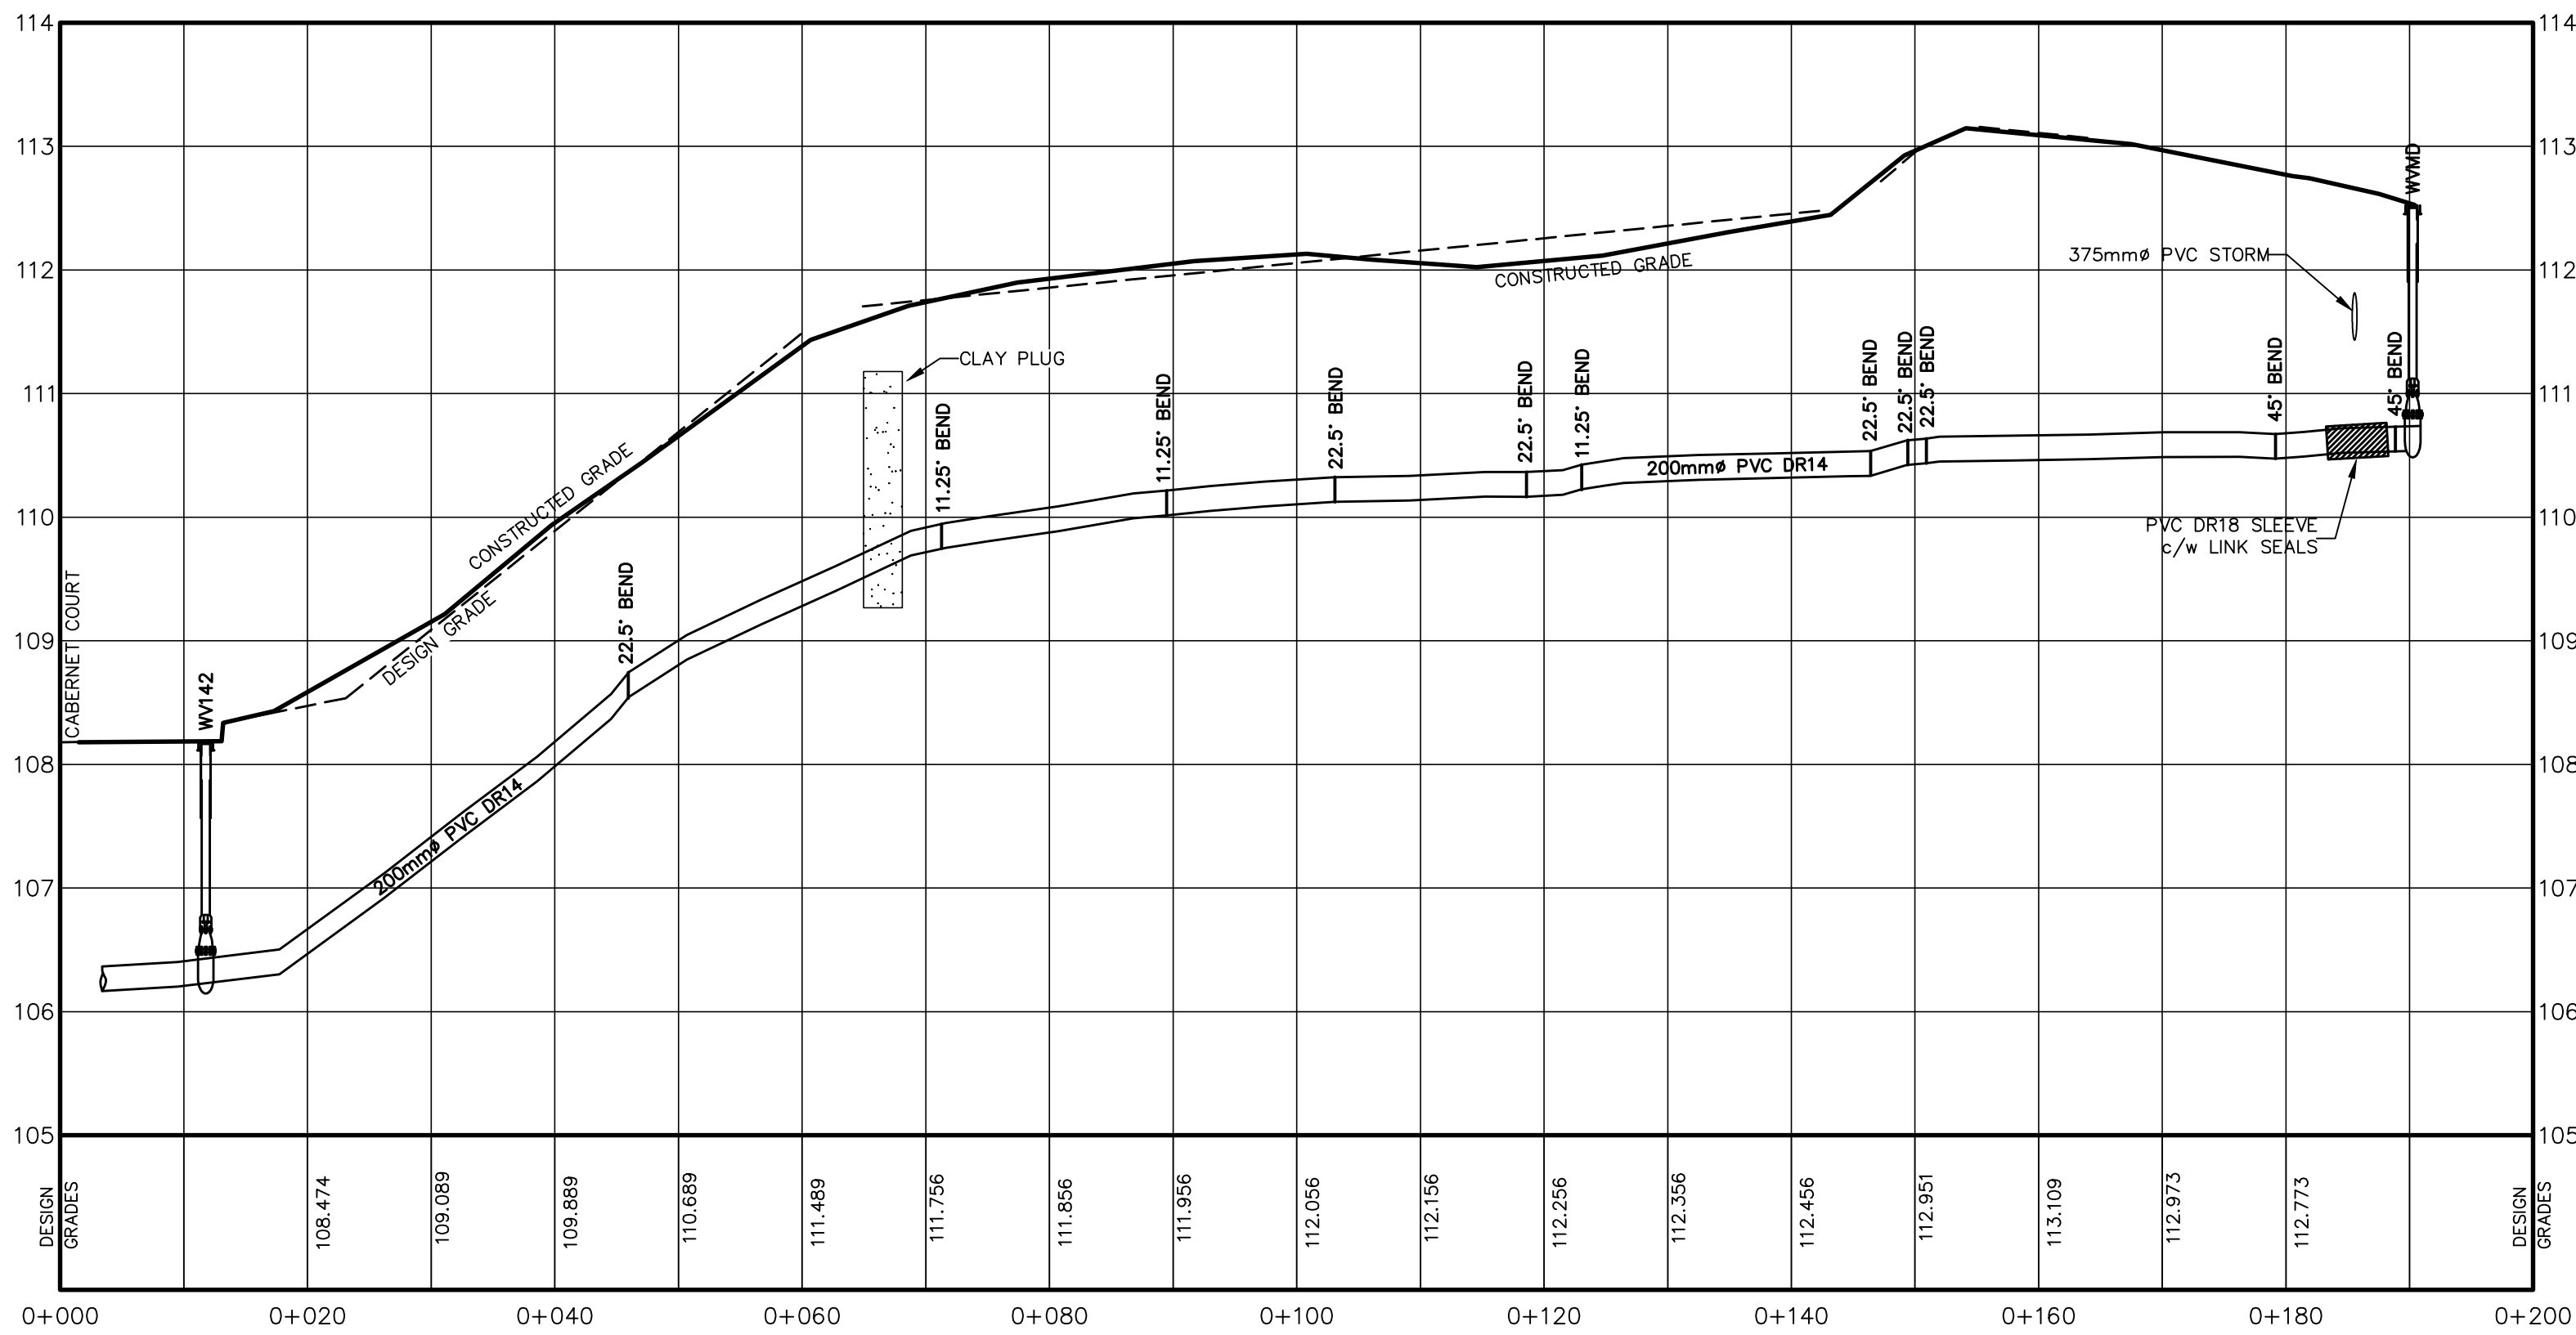

LEGEND	
CONSTRUCTED	PRE-EXISTING
WATERMAIN & GATE VALVE	W - W
SANITARY MANHOLE & PIPE	SM - SM
STORM MANHOLE & PIPE	STM - STM
POWER/COMMUNICATIONS	PC - PC
EDGE OF PAVEMENT	EO - EO
LOTLINE	LO - LO
PROFILE GRADE	PG - PG
STREET BOUNDARY	SB - SB
PROPERTY BOUNDARY	PB - PB
FLOW DIRECTION ARROW	FA - FA
DRIVEWAY CUT	DC - DC
SWALE/DITCH	SD - SD
CATCH BASIN	CB - CB
ARV CHAMBER	AC - AC
FIRE HYDRANT	FH - FH
STREET TREE	ST - ST
UTILITY POLE	UP - UP
SANITARY LATERAL	SL - SL
STORM LATERAL	STL - STL
WATER LATERAL	WL - WL
CATCH BASIN LEAD	CBL - CBL
HEADWALL	HW - HW
ENDCAP	EC - EC
LIGHT STANDARD	LS - LS
ROAD SIGN	RS - RS
ALIANT PEDESTAL	AP - AP
NSP URD BOX	NB - NB
EASEMENT	E - E
SHOULDER	S - S
CURB	C - C
SIDEWALK	SW - SW
FENCE	F - F

ROAD CONSTRUCTION AND SERVICING BY DEXTER CONSTRUCTION

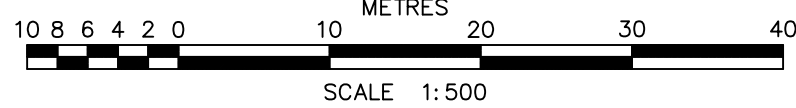

NO.	DESCRIPTION	CHK'D	DATE
6	FINAL RECORD DRAWING		25-NOV-2011
5	RECORD DRAWING		08-SEP-2011
4	REISSUED FOR CONSTRUCTION		08-FEB-2011
3	ISSUED FOR CONSTRUCTION		07-JAN-2011
2	REVISED AS PER HRM & HW COMMENTS		04-NOV-2010
1A	ISSUED TO CONTRACTOR		02-NOV-2010
1	REVISED AS PER HRM & HW COMMENTS		18-AUG-2010
0	ISSUED FOR REVIEW		30-APR-2010



1 SPECTACLE LAKE DRIVE
DARTMOUTH, NOVA SCOTIA
CANADA, B3B 1X7
PHONE: 902 835-9955 - FAX: 902 835-1645
WWW.GENIVAR.COM



CLIENT

NINE MILE RIVER
INVESTMENTS LTD.

HALIFAX, NOVA SCOTIA

PROJECT



BRUNELLO ESTATES
PHASE 1
TIMBERLEA, NOVA SCOTIA

SHEET DESCRIPTION

PLAN AND PROFILE
WALKWAY 1
STA 0+000 TO 0+200

DATE 30-APR-2010
HORIZ. SCALE 1:500
VERT. SCALE 1:50
DRAWN CMLUTZ
CHECKED LMACDONALD
DWG. NO. D09109-009_003

SHEET
13
OF
26