

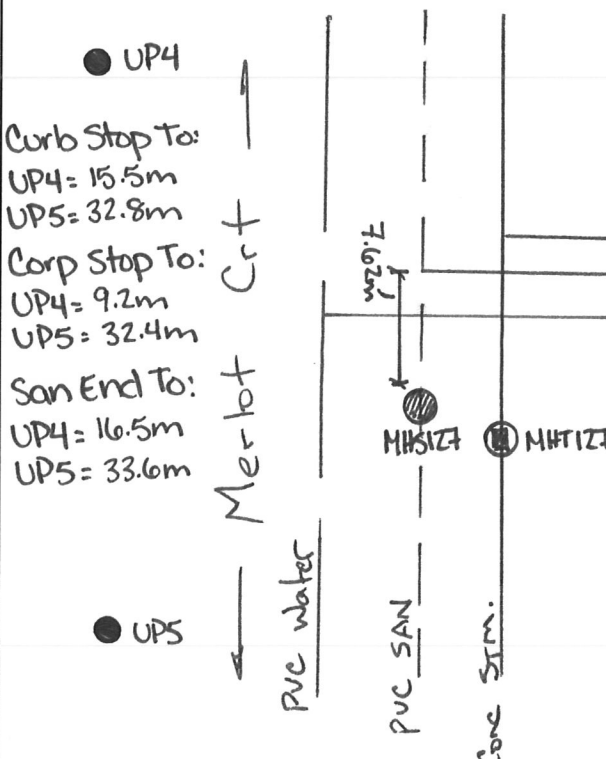

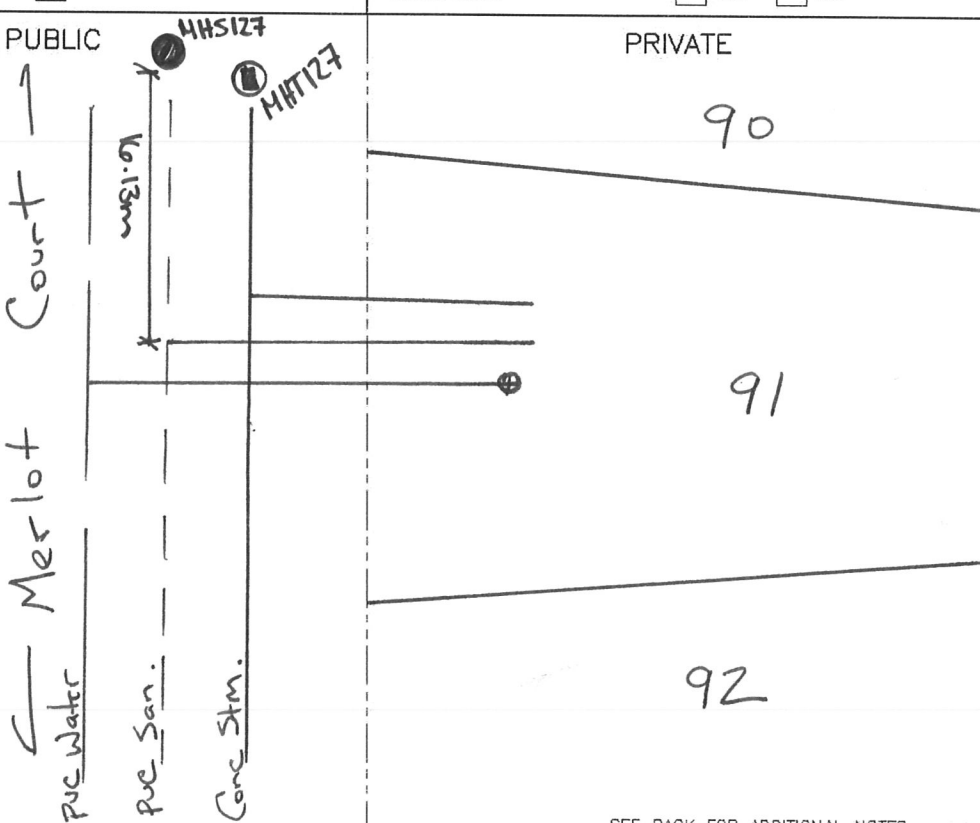




|  | HALIFAX WATER SERVICE LATERAL INFORMATION SHEET | Street <u>Merlot Court</u> Lot <u>89</u> Civic _____ | SLID# _____ | |
|---|
| <table border="1" style="width:100%; border-collapse: collapse;"> <thead> <tr> <th></th> <th style="text-align: center;">Water</th> <th style="text-align: center;">Sanitary</th> <th style="text-align: center;">Storm</th> </tr> </thead> <tbody> <tr> <td>LENGTH</td> <td style="text-align: center;">9.7m</td> <td style="text-align: center;">10.1m</td> <td style="text-align: center;">8.7m</td> </tr> <tr> <td>MATERIAL</td> <td style="text-align: center;">Polyethylene</td> <td style="text-align: center;">PVC DR28</td> <td style="text-align: center;">PVC DR35</td> </tr> <tr> <td>SIZE</td> <td style="text-align: center;">25mm</td> <td style="text-align: center;">125mm</td> <td style="text-align: center;">125mm</td> </tr> <tr> <td>COLOUR</td> <td style="text-align: center;">Blue</td> <td style="text-align: center;">White</td> <td style="text-align: center;">Green</td> </tr> <tr> <td>DEPTH @ MAIN</td> <td style="text-align: center;">1.81m</td> <td style="text-align: center;">2.48m</td> <td style="text-align: center;">2.75m</td> </tr> <tr> <td>DEPTH @ ST. LINE</td> <td style="text-align: center;">1.90m</td> <td style="text-align: center;">2.37m</td> <td style="text-align: center;">2.38m</td> </tr> <tr> <td>ELEV @ MAIN</td> <td style="text-align: center;">88.85</td> <td style="text-align: center;">88.18</td> <td style="text-align: center;">87.91</td> </tr> <tr> <td>ELEV @ ST. LINE</td> <td style="text-align: center;">89.09</td> <td style="text-align: center;">88.62</td> <td style="text-align: center;">88.61</td> </tr> <tr> <td>MAIN SIZE</td> <td style="text-align: center;">200 mm</td> <td style="text-align: center;">200 mm</td> <td style="text-align: center;">525mm</td> </tr> </tbody> </table> <p>Contractor <u>Dexter Construction</u> Inspected By <u>Trevor Carter - GENIVAR inc.</u> Date <u>March 2011</u> Record Dwg. # <u>D09109-003 001</u></p> <table style="width:100%;"> <tr> <td>Insulation</td> <td><input checked="" type="checkbox"/> Yes</td> <td><input type="checkbox"/> No</td> </tr> <tr> <td>Rock</td> <td><input type="checkbox"/> Yes</td> <td><input type="checkbox"/> No</td> </tr> <tr> <td>Clay Plug</td> <td><input checked="" type="checkbox"/> Yes</td> <td><input type="checkbox"/> No</td> </tr> <tr> <td>Trace Wire</td> <td><input checked="" type="checkbox"/> Yes</td> <td><input type="checkbox"/> No</td> </tr> <tr> <td>Anode</td> <td><input type="checkbox"/> Yes</td> <td><input checked="" type="checkbox"/> No</td> </tr> </table> | | Water | Sanitary | Storm | LENGTH | 9.7m | 10.1m | 8.7m | MATERIAL | Polyethylene | PVC DR28 | PVC DR35 | SIZE | 25mm | 125mm | 125mm | COLOUR | Blue | White | Green | DEPTH @ MAIN | 1.81m | 2.48m | 2.75m | DEPTH @ ST. LINE | 1.90m | 2.37m | 2.38m | ELEV @ MAIN | 88.85 | 88.18 | 87.91 | ELEV @ ST. LINE | 89.09 | 88.62 | 88.61 | MAIN SIZE | 200 mm | 200 mm | 525mm | Insulation | <input checked="" type="checkbox"/> Yes | <input type="checkbox"/> No | Rock | <input type="checkbox"/> Yes | <input type="checkbox"/> No | Clay Plug | <input checked="" type="checkbox"/> Yes | <input type="checkbox"/> No | Trace Wire | <input checked="" type="checkbox"/> Yes | <input type="checkbox"/> No | Anode | <input type="checkbox"/> Yes | <input checked="" type="checkbox"/> No | <table border="1" style="width:100%; border-collapse: collapse;"> <thead> <tr> <th></th> <th style="text-align: center;">Water</th> <th style="text-align: center;">Sanitary</th> <th style="text-align: center;">Storm</th> </tr> </thead> <tbody> <tr> <td>LENGTH</td> <td></td> <td></td> <td></td> </tr> <tr> <td>MATERIAL</td> <td></td> <td></td> <td></td> </tr> <tr> <td>SIZE</td> <td></td> <td></td> <td></td> </tr> <tr> <td>COLOUR</td> <td></td> <td></td> <td></td> </tr> <tr> <td>DEPTH @ ST. LINE</td> <td></td> <td></td> <td></td> </tr> <tr> <td>DEPTH @ BLDG</td> <td></td> <td></td> <td></td> </tr> </tbody> </table> <p>Contractor _____ Inspected By _____ Date _____</p> <p>Sanitary Type. Pressurized <input type="checkbox"/> Gravity <input type="checkbox"/> Private Lift Station Info. Lift: <input type="checkbox"/> Distance <input type="checkbox"/></p> <table style="width:100%;"> <tr> <td>Insulation</td> <td><input type="checkbox"/> Yes</td> <td><input type="checkbox"/> No</td> </tr> <tr> <td>Rock</td> <td><input type="checkbox"/> Yes</td> <td><input type="checkbox"/> No</td> </tr> <tr> <td>Clay Plug</td> <td><input type="checkbox"/> Yes</td> <td><input type="checkbox"/> No</td> </tr> <tr> <td>Foundation Drain Connected</td> <td><input type="checkbox"/> Yes</td> <td><input type="checkbox"/> No</td> </tr> <tr> <td>Rain Leaders Connected</td> <td><input type="checkbox"/> Yes</td> <td><input type="checkbox"/> No</td> </tr> <tr> <td>Trace Wire</td> <td><input type="checkbox"/> Yes</td> <td><input type="checkbox"/> No</td> </tr> <tr> <td>Sound Check</td> <td><input type="checkbox"/> Yes</td> <td><input type="checkbox"/> No</td> </tr> </table> | | Water | Sanitary | Storm | LENGTH | | | | MATERIAL | | | | SIZE | | | | COLOUR | | | | DEPTH @ ST. LINE | | | | DEPTH @ BLDG | | | | Insulation | <input type="checkbox"/> Yes | <input type="checkbox"/> No | Rock | <input type="checkbox"/> Yes | <input type="checkbox"/> No | Clay Plug | <input type="checkbox"/> Yes | <input type="checkbox"/> No | Foundation Drain Connected | <input type="checkbox"/> Yes | <input type="checkbox"/> No | Rain Leaders Connected | <input type="checkbox"/> Yes | <input type="checkbox"/> No | Trace Wire | <input type="checkbox"/> Yes | <input type="checkbox"/> No | Sound Check | <input type="checkbox"/> Yes | <input type="checkbox"/> No |
| | Water | Sanitary | Storm | |
| LENGTH | 9.7m | 10.1m | 8.7m | |
| MATERIAL | Polyethylene | PVC DR28 | PVC DR35 | |
| SIZE | 25mm | 125mm | 125mm | |
| COLOUR | Blue | White | Green | |
| DEPTH @ MAIN | 1.81m | 2.48m | 2.75m | |
| DEPTH @ ST. LINE | 1.90m | 2.37m | 2.38m | |
| ELEV @ MAIN | 88.85 | 88.18 | 87.91 | |
| ELEV @ ST. LINE | 89.09 | 88.62 | 88.61 | |
| MAIN SIZE | 200 mm | 200 mm | 525mm | |
| Insulation | <input checked="" type="checkbox"/> Yes | <input type="checkbox"/> No | |
| Rock | <input type="checkbox"/> Yes | <input type="checkbox"/> No | |
| Clay Plug | <input checked="" type="checkbox"/> Yes | <input type="checkbox"/> No | |
| Trace Wire | <input checked="" type="checkbox"/> Yes | <input type="checkbox"/> No | |
| Anode | <input type="checkbox"/> Yes | <input checked="" type="checkbox"/> No | |
| | Water | Sanitary | Storm | |
| LENGTH | |
| MATERIAL | |
| SIZE | |
| COLOUR | |
| DEPTH @ ST. LINE | |
| DEPTH @ BLDG | |
| Insulation | <input type="checkbox"/> Yes | <input type="checkbox"/> No | |
| Rock | <input type="checkbox"/> Yes | <input type="checkbox"/> No | |
| Clay Plug | <input type="checkbox"/> Yes | <input type="checkbox"/> No | |
| Foundation Drain Connected | <input type="checkbox"/> Yes | <input type="checkbox"/> No | |
| Rain Leaders Connected | <input type="checkbox"/> Yes | <input type="checkbox"/> No | |
| Trace Wire | <input type="checkbox"/> Yes | <input type="checkbox"/> No | |
| Sound Check | <input type="checkbox"/> Yes | <input type="checkbox"/> No | |
| <p style="text-align: center;">● UP3 PUBLIC</p> <div style="display: flex; justify-content: space-between;"> <div style="width: 30%;"> <p>Curb Stop to: UP3 = 34.2m UP4 = 18.2m</p> <p>Carp Stop to: UP3 = 32.2m UP4 = 13.2m</p> <p>San End to: UP3 = 34.5m UP4 = 19.5m</p> <p style="text-align: center;">● UP4</p> </div> <div style="width: 30%; border-left: 1px dashed black; padding-left: 10px;"> <p style="text-align: center;">Merlot Court</p> <p style="text-align: center;">PVC water</p> <p style="text-align: center;">Pvc SAN.</p> <p style="text-align: center;">Conc STM.</p> </div> <div style="width: 30%; text-align: center;"> <p>MHS130</p> <p>MHT130</p> <p style="font-size: 2em;">21.17m</p> </div> </div> | <p style="text-align: center;">PRIVATE</p> <div style="display: flex; justify-content: space-around; align-items: center; height: 100px;"> <div style="width: 40%; border-bottom: 1px solid black; margin-bottom: 10px;"></div> <div style="width: 40%; border-bottom: 1px solid black; margin-bottom: 10px;"></div> </div> <p style="text-align: center; font-size: 2em;">89</p> <p style="text-align: center; font-size: 2em;">90</p> <p style="text-align: right;">SEE BACK FOR ADDITIONAL NOTES →</p> | |


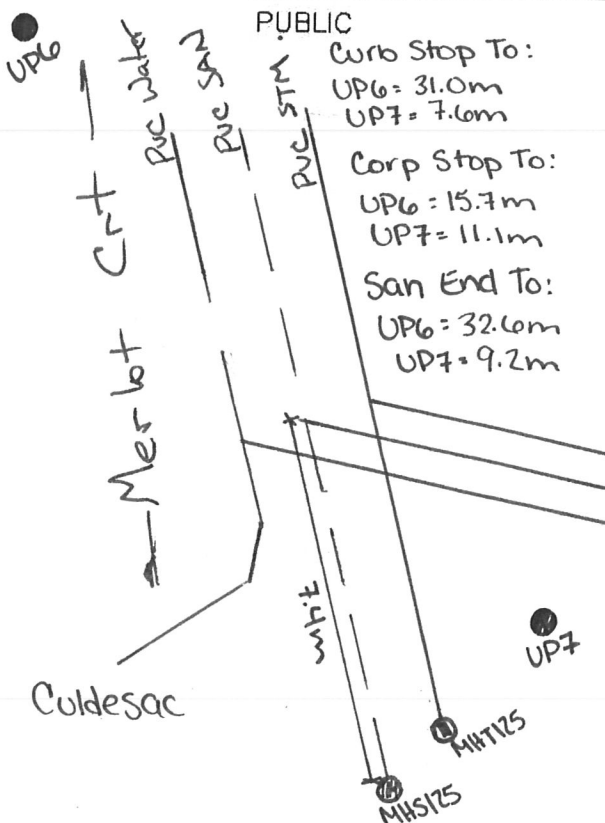
|  | HALIFAX WATER SERVICE LATERAL INFORMATION SHEET | Street <u>Merlot Court</u> Lot <u>90</u> Civic _____ | |
|---|
| <p style="text-align: center;">PUBLIC</p> <table border="1" style="width:100%; border-collapse: collapse;"> <thead> <tr> <th></th> <th>Water</th> <th>Sanitary</th> <th>Storm</th> </tr> </thead> <tbody> <tr> <td>LENGTH</td> <td>9.8m</td> <td>9.9m</td> <td>7.3m</td> </tr> <tr> <td>MATERIAL</td> <td>Polyethylene</td> <td>PVC DR28</td> <td>PVC DR35</td> </tr> <tr> <td>SIZE</td> <td>25mm</td> <td>125mm</td> <td>125mm</td> </tr> <tr> <td>COLOUR</td> <td>Blue</td> <td>White</td> <td>Green</td> </tr> <tr> <td>DEPTH @ MAIN</td> <td>1.74m</td> <td>2.94m</td> <td>3.01m</td> </tr> <tr> <td>DEPTH @ ST. LINE</td> <td>2.0m</td> <td>2.60m</td> <td>2.60m</td> </tr> <tr> <td>ELEV @ MAIN</td> <td>89.91</td> <td>88.71</td> <td>88.64.</td> </tr> <tr> <td>ELEV @ ST. LINE</td> <td>90.14</td> <td>89.48</td> <td>89.48</td> </tr> <tr> <td>MAIN SIZE</td> <td>200mm</td> <td>200mm</td> <td>525mm.</td> </tr> </tbody> </table> <p>Contractor <u>Dexter Construction</u> Inspected By <u>Trevor Carter - GENIVAR inc.</u> Date <u>March 2011</u> Record Dwg. # <u>D09109-003.001</u></p> <p>Insulation <input checked="" type="checkbox"/> Yes <input type="checkbox"/> No Rock <input type="checkbox"/> Yes <input type="checkbox"/> No Clay Plug <input type="checkbox"/> Yes <input type="checkbox"/> No Trace Wire <input checked="" type="checkbox"/> Yes <input type="checkbox"/> No Anode <input type="checkbox"/> Yes <input checked="" type="checkbox"/> No</p> | | | Water | Sanitary | Storm | LENGTH | 9.8m | 9.9m | 7.3m | MATERIAL | Polyethylene | PVC DR28 | PVC DR35 | SIZE | 25mm | 125mm | 125mm | COLOUR | Blue | White | Green | DEPTH @ MAIN | 1.74m | 2.94m | 3.01m | DEPTH @ ST. LINE | 2.0m | 2.60m | 2.60m | ELEV @ MAIN | 89.91 | 88.71 | 88.64. | ELEV @ ST. LINE | 90.14 | 89.48 | 89.48 | MAIN SIZE | 200mm | 200mm | 525mm. | <p style="text-align: center;">PRIVATE</p> <table border="1" style="width:100%; border-collapse: collapse;"> <thead> <tr> <th></th> <th>Water</th> <th>Sanitary</th> <th>Storm</th> </tr> </thead> <tbody> <tr><td>LENGTH</td><td></td><td></td><td></td></tr> <tr><td>MATERIAL</td><td></td><td></td><td></td></tr> <tr><td>SIZE</td><td></td><td></td><td></td></tr> <tr><td>COLOUR</td><td></td><td></td><td></td></tr> <tr><td>DEPTH @ ST. LINE</td><td></td><td></td><td></td></tr> <tr><td>DEPTH @ BLDG</td><td></td><td></td><td></td></tr> </tbody> </table> <p>Contractor _____ Inspected By _____ Date _____</p> <p>Sanitary Type Pressurized <input type="checkbox"/> Gravity <input type="checkbox"/> Private Lift Station Info. Lift: <input type="checkbox"/> Distance <input type="checkbox"/></p> <p>Insulation <input type="checkbox"/> Yes <input type="checkbox"/> No Rock <input type="checkbox"/> Yes <input type="checkbox"/> No Clay Plug <input type="checkbox"/> Yes <input type="checkbox"/> No Foundation Drain Connected <input type="checkbox"/> Yes <input type="checkbox"/> No Rain Leaders Connected <input type="checkbox"/> Yes <input type="checkbox"/> No Trace Wire <input type="checkbox"/> Yes <input type="checkbox"/> No Sound Check <input type="checkbox"/> Yes <input type="checkbox"/> No</p> | | Water | Sanitary | Storm | LENGTH | | | | MATERIAL | | | | SIZE | | | | COLOUR | | | | DEPTH @ ST. LINE | | | | DEPTH @ BLDG | | | |
| | Water | Sanitary | Storm | | | | | | | | | | | | | | | | | | | | | | | | | | | | | | | | | | | | | | | | | | | | | | | | | | | | | | | | | | | | | | | | | | | |
| LENGTH | 9.8m | 9.9m | 7.3m | | | | | | | | | | | | | | | | | | | | | | | | | | | | | | | | | | | | | | | | | | | | | | | | | | | | | | | | | | | | | | | | | | | |
| MATERIAL | Polyethylene | PVC DR28 | PVC DR35 | | | | | | | | | | | | | | | | | | | | | | | | | | | | | | | | | | | | | | | | | | | | | | | | | | | | | | | | | | | | | | | | | | | |
| SIZE | 25mm | 125mm | 125mm | | | | | | | | | | | | | | | | | | | | | | | | | | | | | | | | | | | | | | | | | | | | | | | | | | | | | | | | | | | | | | | | | | | |
| COLOUR | Blue | White | Green | | | | | | | | | | | | | | | | | | | | | | | | | | | | | | | | | | | | | | | | | | | | | | | | | | | | | | | | | | | | | | | | | | | |
| DEPTH @ MAIN | 1.74m | 2.94m | 3.01m | | | | | | | | | | | | | | | | | | | | | | | | | | | | | | | | | | | | | | | | | | | | | | | | | | | | | | | | | | | | | | | | | | | |
| DEPTH @ ST. LINE | 2.0m | 2.60m | 2.60m | | | | | | | | | | | | | | | | | | | | | | | | | | | | | | | | | | | | | | | | | | | | | | | | | | | | | | | | | | | | | | | | | | | |
| ELEV @ MAIN | 89.91 | 88.71 | 88.64. | | | | | | | | | | | | | | | | | | | | | | | | | | | | | | | | | | | | | | | | | | | | | | | | | | | | | | | | | | | | | | | | | | | |
| ELEV @ ST. LINE | 90.14 | 89.48 | 89.48 | | | | | | | | | | | | | | | | | | | | | | | | | | | | | | | | | | | | | | | | | | | | | | | | | | | | | | | | | | | | | | | | | | | |
| MAIN SIZE | 200mm | 200mm | 525mm. | | | | | | | | | | | | | | | | | | | | | | | | | | | | | | | | | | | | | | | | | | | | | | | | | | | | | | | | | | | | | | | | | | | |
| | Water | Sanitary | Storm | | | | | | | | | | | | | | | | | | | | | | | | | | | | | | | | | | | | | | | | | | | | | | | | | | | | | | | | | | | | | | | | | | | |
| LENGTH | | | | | | | | | | | | | | | | | | | | | | | | | | | | | | | | | | | | | | | | | | | | | | | | | | | | | | | | | | | | | | | | | | | | | | |
| MATERIAL | | | | | | | | | | | | | | | | | | | | | | | | | | | | | | | | | | | | | | | | | | | | | | | | | | | | | | | | | | | | | | | | | | | | | | |
| SIZE | | | | | | | | | | | | | | | | | | | | | | | | | | | | | | | | | | | | | | | | | | | | | | | | | | | | | | | | | | | | | | | | | | | | | | |
| COLOUR | | | | | | | | | | | | | | | | | | | | | | | | | | | | | | | | | | | | | | | | | | | | | | | | | | | | | | | | | | | | | | | | | | | | | | |
| DEPTH @ ST. LINE | | | | | | | | | | | | | | | | | | | | | | | | | | | | | | | | | | | | | | | | | | | | | | | | | | | | | | | | | | | | | | | | | | | | | | |
| DEPTH @ BLDG | | | | | | | | | | | | | | | | | | | | | | | | | | | | | | | | | | | | | | | | | | | | | | | | | | | | | | | | | | | | | | | | | | | | | | |
| <p style="text-align: center;">PUBLIC</p>  <p> ● UP4 Curb Stop To: UP4 = 15.5m UP5 = 32.8m Corp Stop To: UP4 = 9.2m UP5 = 32.4m San End To: UP4 = 16.5m UP5 = 33.6m </p> <p>Merlot Cr PVC water PVC SAN Core STM MHSIZI MHTIZI 7.62m</p> | | <p style="text-align: center;">PRIVATE</p> <p style="text-align: center; font-size: 2em;">89</p> <p style="text-align: center; font-size: 2em;">90</p> <p style="text-align: center; font-size: 2em;">91</p> <p style="text-align: right;">SEE BACK FOR ADDITIONAL NOTES →</p> | |


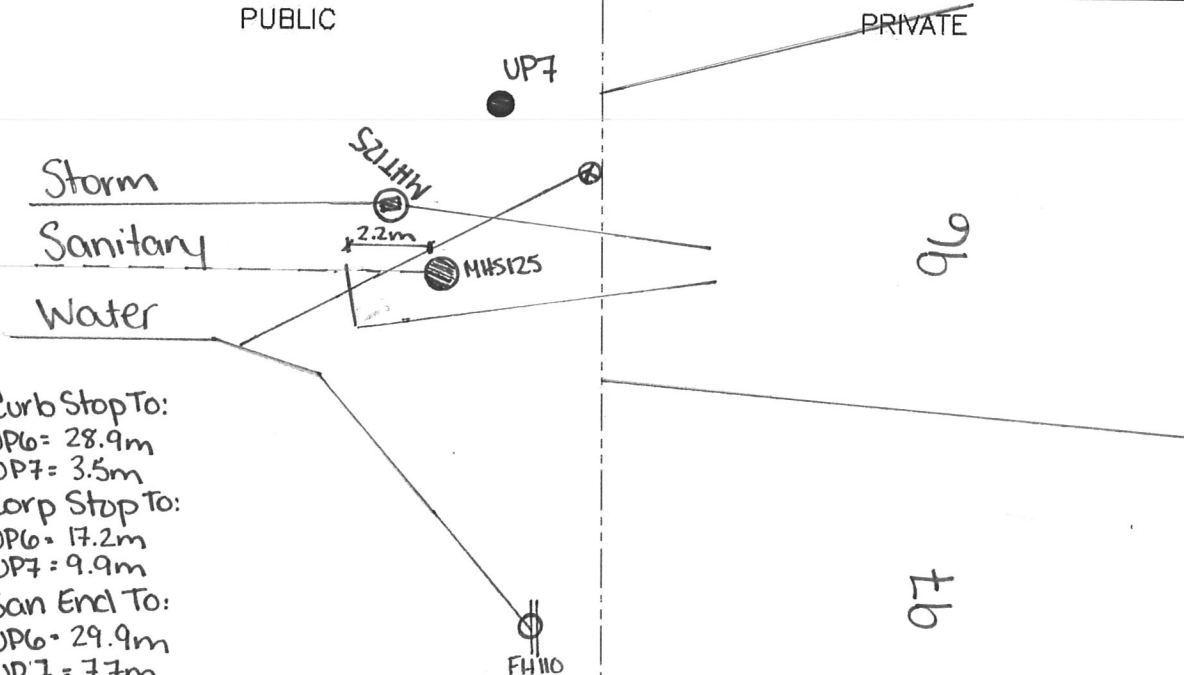
|  | HALIFAX WATER SERVICE LATERAL INFORMATION SHEET | Street <u>Merlot Court</u> Lot <u>91</u> Civic _____ | SLID# _____ | |
|---|
| <p>PUBLIC</p> <table border="1" style="width:100%; border-collapse: collapse;"> <thead> <tr> <th></th> <th>Water</th> <th>Sanitary</th> <th>Storm</th> </tr> </thead> <tbody> <tr> <td>LENGTH</td> <td>7.9m</td> <td>8.2m</td> <td>5.6m</td> </tr> <tr> <td>MATERIAL</td> <td>Polyethylene</td> <td>PVC DR28</td> <td>PVC DR35</td> </tr> <tr> <td>SIZE</td> <td>25mm</td> <td>125mm</td> <td>125mm</td> </tr> <tr> <td>COLOUR</td> <td>Blue</td> <td>White</td> <td>Green</td> </tr> <tr> <td>DEPTH @ MAIN</td> <td>1.57m</td> <td>2.76m</td> <td>2.80m</td> </tr> <tr> <td>DEPTH @ ST. LINE</td> <td>1.82m</td> <td>2.4m</td> <td>2.43m</td> </tr> <tr> <td>ELEV @ MAIN</td> <td>92.22</td> <td>91.03</td> <td>90.99</td> </tr> <tr> <td>ELEV @ ST. LINE</td> <td>92.26</td> <td>91.68</td> <td>91.65</td> </tr> <tr> <td>MAIN SIZE</td> <td>200mm.</td> <td>200mm</td> <td>450mm</td> </tr> </tbody> </table> <p>Contractor <u>Dexter Construction</u> Inspected By <u>Trevor Carter - GENIVAR inc.</u> Date <u>March 2011</u> Record Dwg. # <u>D09109-003 001</u></p> <p> Insulation <input checked="" type="checkbox"/> Yes <input type="checkbox"/> No Rock <input type="checkbox"/> Yes <input type="checkbox"/> No Clay Plug <input type="checkbox"/> Yes <input type="checkbox"/> No Trace Wire <input checked="" type="checkbox"/> Yes <input type="checkbox"/> No Anode <input type="checkbox"/> Yes <input checked="" type="checkbox"/> No </p> | | Water | Sanitary | Storm | LENGTH | 7.9m | 8.2m | 5.6m | MATERIAL | Polyethylene | PVC DR28 | PVC DR35 | SIZE | 25mm | 125mm | 125mm | COLOUR | Blue | White | Green | DEPTH @ MAIN | 1.57m | 2.76m | 2.80m | DEPTH @ ST. LINE | 1.82m | 2.4m | 2.43m | ELEV @ MAIN | 92.22 | 91.03 | 90.99 | ELEV @ ST. LINE | 92.26 | 91.68 | 91.65 | MAIN SIZE | 200mm. | 200mm | 450mm | <p>PRIVATE</p> <table border="1" style="width:100%; border-collapse: collapse;"> <thead> <tr> <th></th> <th>Water</th> <th>Sanitary</th> <th>Storm</th> </tr> </thead> <tbody> <tr> <td>LENGTH</td> <td></td> <td></td> <td></td> </tr> <tr> <td>MATERIAL</td> <td></td> <td></td> <td></td> </tr> <tr> <td>SIZE</td> <td></td> <td></td> <td></td> </tr> <tr> <td>COLOUR</td> <td></td> <td></td> <td></td> </tr> <tr> <td>DEPTH @ ST. LINE</td> <td></td> <td></td> <td></td> </tr> <tr> <td>DEPTH @ BLDG</td> <td></td> <td></td> <td></td> </tr> </tbody> </table> <p>Contractor _____ Inspected By _____ Date _____</p> <p>Sanitary Type Pressurized <input type="checkbox"/> Gravity <input type="checkbox"/> Private Lift Lift: <input type="checkbox"/> Distance <input type="checkbox"/> Station Info.</p> <p> Insulation <input type="checkbox"/> Yes <input type="checkbox"/> No Rock <input type="checkbox"/> Yes <input type="checkbox"/> No Clay Plug <input type="checkbox"/> Yes <input type="checkbox"/> No Foundation Drain Connected <input type="checkbox"/> Yes <input type="checkbox"/> No Rain Leaders Connected <input type="checkbox"/> Yes <input type="checkbox"/> No Trace Wire <input type="checkbox"/> Yes <input type="checkbox"/> No Sound Check <input type="checkbox"/> Yes <input type="checkbox"/> No </p> | | Water | Sanitary | Storm | LENGTH | | | | MATERIAL | | | | SIZE | | | | COLOUR | | | | DEPTH @ ST. LINE | | | | DEPTH @ BLDG | | | |
| | Water | Sanitary | Storm | | | | | | | | | | | | | | | | | | | | | | | | | | | | | | | | | | | | | | | | | | | | | | | | | | | | | | | | | | | | | | | | | | |
| LENGTH | 7.9m | 8.2m | 5.6m | | | | | | | | | | | | | | | | | | | | | | | | | | | | | | | | | | | | | | | | | | | | | | | | | | | | | | | | | | | | | | | | | | |
| MATERIAL | Polyethylene | PVC DR28 | PVC DR35 | | | | | | | | | | | | | | | | | | | | | | | | | | | | | | | | | | | | | | | | | | | | | | | | | | | | | | | | | | | | | | | | | | |
| SIZE | 25mm | 125mm | 125mm | | | | | | | | | | | | | | | | | | | | | | | | | | | | | | | | | | | | | | | | | | | | | | | | | | | | | | | | | | | | | | | | | | |
| COLOUR | Blue | White | Green | | | | | | | | | | | | | | | | | | | | | | | | | | | | | | | | | | | | | | | | | | | | | | | | | | | | | | | | | | | | | | | | | | |
| DEPTH @ MAIN | 1.57m | 2.76m | 2.80m | | | | | | | | | | | | | | | | | | | | | | | | | | | | | | | | | | | | | | | | | | | | | | | | | | | | | | | | | | | | | | | | | | |
| DEPTH @ ST. LINE | 1.82m | 2.4m | 2.43m | | | | | | | | | | | | | | | | | | | | | | | | | | | | | | | | | | | | | | | | | | | | | | | | | | | | | | | | | | | | | | | | | | |
| ELEV @ MAIN | 92.22 | 91.03 | 90.99 | | | | | | | | | | | | | | | | | | | | | | | | | | | | | | | | | | | | | | | | | | | | | | | | | | | | | | | | | | | | | | | | | | |
| ELEV @ ST. LINE | 92.26 | 91.68 | 91.65 | | | | | | | | | | | | | | | | | | | | | | | | | | | | | | | | | | | | | | | | | | | | | | | | | | | | | | | | | | | | | | | | | | |
| MAIN SIZE | 200mm. | 200mm | 450mm | | | | | | | | | | | | | | | | | | | | | | | | | | | | | | | | | | | | | | | | | | | | | | | | | | | | | | | | | | | | | | | | | | |
| | Water | Sanitary | Storm | | | | | | | | | | | | | | | | | | | | | | | | | | | | | | | | | | | | | | | | | | | | | | | | | | | | | | | | | | | | | | | | | | |
| LENGTH | | | | | | | | | | | | | | | | | | | | | | | | | | | | | | | | | | | | | | | | | | | | | | | | | | | | | | | | | | | | | | | | | | | | | |
| MATERIAL | | | | | | | | | | | | | | | | | | | | | | | | | | | | | | | | | | | | | | | | | | | | | | | | | | | | | | | | | | | | | | | | | | | | | |
| SIZE | | | | | | | | | | | | | | | | | | | | | | | | | | | | | | | | | | | | | | | | | | | | | | | | | | | | | | | | | | | | | | | | | | | | | |
| COLOUR | | | | | | | | | | | | | | | | | | | | | | | | | | | | | | | | | | | | | | | | | | | | | | | | | | | | | | | | | | | | | | | | | | | | | |
| DEPTH @ ST. LINE | | | | | | | | | | | | | | | | | | | | | | | | | | | | | | | | | | | | | | | | | | | | | | | | | | | | | | | | | | | | | | | | | | | | | |
| DEPTH @ BLDG | | | | | | | | | | | | | | | | | | | | | | | | | | | | | | | | | | | | | | | | | | | | | | | | | | | | | | | | | | | | | | | | | | | | | |
| <p> ● UP4 PUBLIC Curb Stop To: UP4 = 33.6m UP5 = 14.8m Corp Stop To: UP4 = 35.1m UP5 = 7.7m ● UP5 San End To: UP4 = 33.5m UP5 = 16.5m </p> <p style="text-align: center;"> Merlot Court PVC Water PVC San. Conc. Stm. </p> | <p style="text-align: center;">PRIVATE</p>  <p style="text-align: right;">SEE BACK FOR ADDITIONAL NOTES →</p> | |


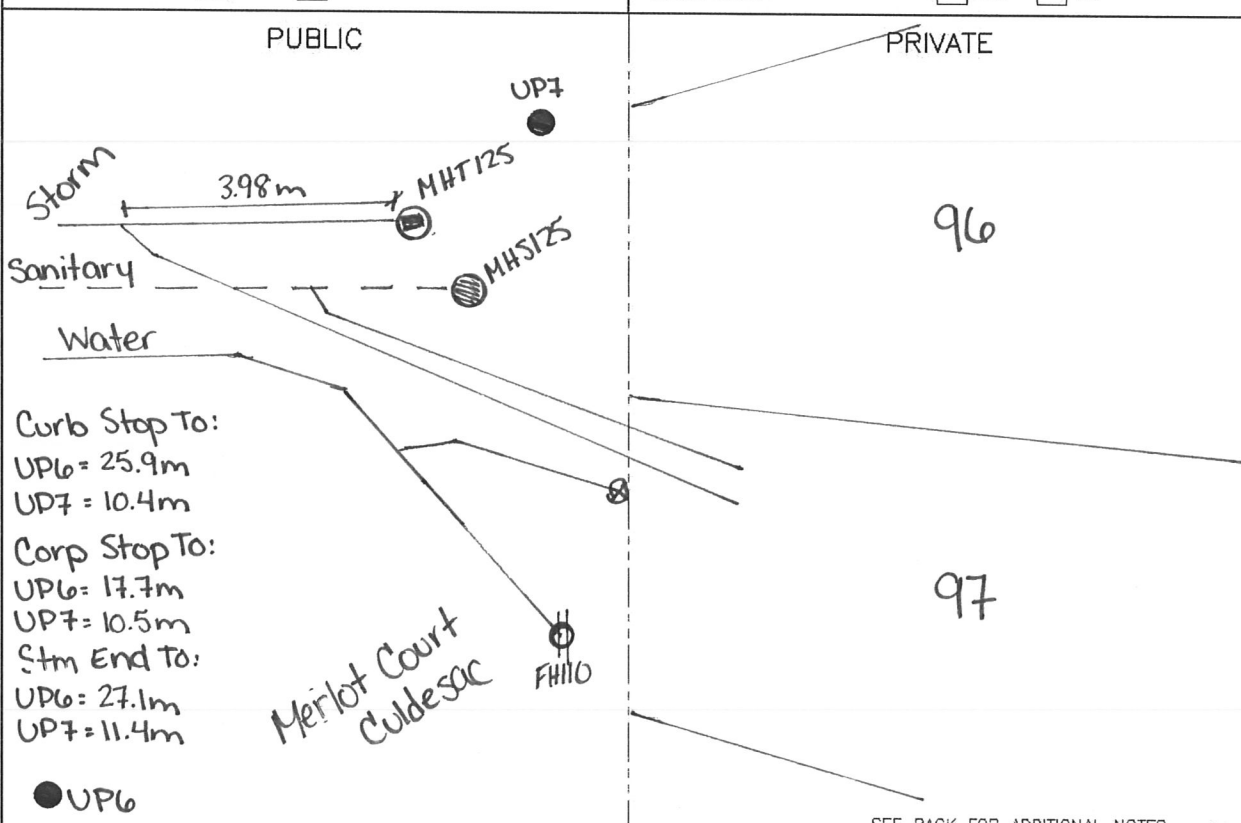
|  | HALIFAX WATER SERVICE LATERAL INFORMATION SHEET | Street <u>Merlot Court</u> Lot <u>92</u> Civic _____ | SLID# _____ | |
|---|
| <table border="1" style="width:100%; border-collapse: collapse;"> <thead> <tr> <th colspan="4" style="text-align: left;">PUBLIC</th> </tr> <tr> <th></th> <th>Water</th> <th>Sanitary</th> <th>Storm</th> </tr> </thead> <tbody> <tr> <td>LENGTH</td> <td>10.3m</td> <td>10.9m</td> <td>8.4m</td> </tr> <tr> <td>MATERIAL</td> <td>Polyethylene</td> <td>PVC DR28</td> <td>PVC DR35</td> </tr> <tr> <td>SIZE</td> <td>25mm</td> <td>125mm</td> <td>125mm</td> </tr> <tr> <td>COLOUR</td> <td>Blue</td> <td>White</td> <td>Green</td> </tr> <tr> <td>DEPTH @ MAIN</td> <td>1.97m</td> <td>2.83m</td> <td>2.92m</td> </tr> <tr> <td>DEPTH @ ST. LINE</td> <td>1.60m</td> <td>2.11m</td> <td>2.1m</td> </tr> <tr> <td>ELEV @ MAIN</td> <td>94.31</td> <td>93.45</td> <td>93.36</td> </tr> <tr> <td>ELEV @ ST. LINE</td> <td>94.68</td> <td>94.10</td> <td>94.11</td> </tr> <tr> <td>MAIN SIZE</td> <td>200mm</td> <td>200mm</td> <td>300mm</td> </tr> </tbody> </table> <p>Contractor <u>Dexter Construction</u> Inspected By <u>Trevor Carter - GENIVAR inc.</u> Date <u>March 2011</u> Record Dwg. # <u>D09109-003 001</u></p> <table style="width:100%;"> <tr> <td>Insulation <input checked="" type="checkbox"/> Yes <input type="checkbox"/> No</td> <td>Rock <input type="checkbox"/> Yes <input type="checkbox"/> No</td> </tr> <tr> <td>Clay Plug <input type="checkbox"/> Yes <input type="checkbox"/> No</td> <td>Trace Wire <input checked="" type="checkbox"/> Yes <input type="checkbox"/> No</td> </tr> <tr> <td>Anode <input type="checkbox"/> Yes <input checked="" type="checkbox"/> No</td> <td></td> </tr> </table> | PUBLIC | | | | | Water | Sanitary | Storm | LENGTH | 10.3m | 10.9m | 8.4m | MATERIAL | Polyethylene | PVC DR28 | PVC DR35 | SIZE | 25mm | 125mm | 125mm | COLOUR | Blue | White | Green | DEPTH @ MAIN | 1.97m | 2.83m | 2.92m | DEPTH @ ST. LINE | 1.60m | 2.11m | 2.1m | ELEV @ MAIN | 94.31 | 93.45 | 93.36 | ELEV @ ST. LINE | 94.68 | 94.10 | 94.11 | MAIN SIZE | 200mm | 200mm | 300mm | Insulation <input checked="" type="checkbox"/> Yes <input type="checkbox"/> No | Rock <input type="checkbox"/> Yes <input type="checkbox"/> No | Clay Plug <input type="checkbox"/> Yes <input type="checkbox"/> No | Trace Wire <input checked="" type="checkbox"/> Yes <input type="checkbox"/> No | Anode <input type="checkbox"/> Yes <input checked="" type="checkbox"/> No | | <table border="1" style="width:100%; border-collapse: collapse;"> <thead> <tr> <th colspan="4" style="text-align: left;">PRIVATE</th> </tr> <tr> <th></th> <th>Water</th> <th>Sanitary</th> <th>Storm</th> </tr> </thead> <tbody> <tr><td>LENGTH</td><td></td><td></td><td></td></tr> <tr><td>MATERIAL</td><td></td><td></td><td></td></tr> <tr><td>SIZE</td><td></td><td></td><td></td></tr> <tr><td>COLOUR</td><td></td><td></td><td></td></tr> <tr><td>DEPTH @ ST. LINE</td><td></td><td></td><td></td></tr> <tr><td>DEPTH @ BLDG</td><td></td><td></td><td></td></tr> </tbody> </table> <p>Contractor _____ Inspected By _____ Date _____</p> <p>Sanitary Type: Pressurized <input type="checkbox"/> Gravity <input type="checkbox"/> Private Lift Station Info: Lift: <input type="checkbox"/> Distance <input type="checkbox"/></p> <table style="width:100%;"> <tr> <td>Insulation <input type="checkbox"/> Yes <input type="checkbox"/> No</td> <td>Rock <input type="checkbox"/> Yes <input type="checkbox"/> No</td> </tr> <tr> <td>Clay Plug <input type="checkbox"/> Yes <input type="checkbox"/> No</td> <td>Foundation Drain Connected <input type="checkbox"/> Yes <input type="checkbox"/> No</td> </tr> <tr> <td>Rain Leaders Connected <input type="checkbox"/> Yes <input type="checkbox"/> No</td> <td>Trace Wire <input type="checkbox"/> Yes <input type="checkbox"/> No</td> </tr> <tr> <td>Sound Check <input type="checkbox"/> Yes <input type="checkbox"/> No</td> <td></td> </tr> </table> | PRIVATE | | | | | Water | Sanitary | Storm | LENGTH | | | | MATERIAL | | | | SIZE | | | | COLOUR | | | | DEPTH @ ST. LINE | | | | DEPTH @ BLDG | | | | Insulation <input type="checkbox"/> Yes <input type="checkbox"/> No | Rock <input type="checkbox"/> Yes <input type="checkbox"/> No | Clay Plug <input type="checkbox"/> Yes <input type="checkbox"/> No | Foundation Drain Connected <input type="checkbox"/> Yes <input type="checkbox"/> No | Rain Leaders Connected <input type="checkbox"/> Yes <input type="checkbox"/> No | Trace Wire <input type="checkbox"/> Yes <input type="checkbox"/> No | Sound Check <input type="checkbox"/> Yes <input type="checkbox"/> No | |
| PUBLIC | | | | | | | | | | | | | | | | | | | | | | | | | | | | | | | | | | | | | | | | | | | | | | | | | | | | | | | | | | | | | | | | | | | | | | | | | | | | | | | | | | | | | | | | | | | |
| | Water | Sanitary | Storm | |
| LENGTH | 10.3m | 10.9m | 8.4m | |
| MATERIAL | Polyethylene | PVC DR28 | PVC DR35 | |
| SIZE | 25mm | 125mm | 125mm | |
| COLOUR | Blue | White | Green | |
| DEPTH @ MAIN | 1.97m | 2.83m | 2.92m | |
| DEPTH @ ST. LINE | 1.60m | 2.11m | 2.1m | |
| ELEV @ MAIN | 94.31 | 93.45 | 93.36 | |
| ELEV @ ST. LINE | 94.68 | 94.10 | 94.11 | |
| MAIN SIZE | 200mm | 200mm | 300mm | |
| Insulation <input checked="" type="checkbox"/> Yes <input type="checkbox"/> No | Rock <input type="checkbox"/> Yes <input type="checkbox"/> No | |
| Clay Plug <input type="checkbox"/> Yes <input type="checkbox"/> No | Trace Wire <input checked="" type="checkbox"/> Yes <input type="checkbox"/> No | |
| Anode <input type="checkbox"/> Yes <input checked="" type="checkbox"/> No | |
| PRIVATE | | | | | | | | | | | | | | | | | | | | | | | | | | | | | | | | | | | | | | | | | | | | | | | | | | | | | | | | | | | | | | | | | | | | | | | | | | | | | | | | | | | | | | | | | | | |
| | Water | Sanitary | Storm | |
| LENGTH | | | | | | | | | | | | | | | | | | | | | | | | | | | | | | | | | | | | | | | | | | | | | | | | | | | | | | | | | | | | | | | | | | | | | | | | | | | | | | | | | | | | | | | | | | | |
| MATERIAL | | | | | | | | | | | | | | | | | | | | | | | | | | | | | | | | | | | | | | | | | | | | | | | | | | | | | | | | | | | | | | | | | | | | | | | | | | | | | | | | | | | | | | | | | | | |
| SIZE | | | | | | | | | | | | | | | | | | | | | | | | | | | | | | | | | | | | | | | | | | | | | | | | | | | | | | | | | | | | | | | | | | | | | | | | | | | | | | | | | | | | | | | | | | | |
| COLOUR | | | | | | | | | | | | | | | | | | | | | | | | | | | | | | | | | | | | | | | | | | | | | | | | | | | | | | | | | | | | | | | | | | | | | | | | | | | | | | | | | | | | | | | | | | | |
| DEPTH @ ST. LINE | |
| DEPTH @ BLDG | | | | | | | | | | | | | | | | | | | | | | | | | | | | | | | | | | | | | | | | | | | | | | | | | | | | | | | | | | | | | | | | | | | | | | | | | | | | | | | | | | | | | | | | | | | |
| Insulation <input type="checkbox"/> Yes <input type="checkbox"/> No | Rock <input type="checkbox"/> Yes <input type="checkbox"/> No | |
| Clay Plug <input type="checkbox"/> Yes <input type="checkbox"/> No | Foundation Drain Connected <input type="checkbox"/> Yes <input type="checkbox"/> No | |
| Rain Leaders Connected <input type="checkbox"/> Yes <input type="checkbox"/> No | Trace Wire <input type="checkbox"/> Yes <input type="checkbox"/> No | |
| Sound Check <input type="checkbox"/> Yes <input type="checkbox"/> No | |
| <p>PUBLIC</p> <p>● UPS</p> <p>Curb Stop To: UPS = 21.3m UP6 = 29.2m</p> <p>Corp Stop To: UPS = 18.5m UP6 = 25.8m</p> <p>San End To: UPS = 21.9m UP6 = 30.6m</p> <p>Merlot</p> <p>● UP6</p> <p>PVC WATER PVC SAN PVC STM</p> <p>MHS126 MHT126</p> <p>1.1m</p> | <p>PRIVATE</p> <p>91</p> <p>92</p> <p>93</p> <p style="text-align: right;">SEE BACK FOR ADDITIONAL NOTES →</p> | |

| HALIFAX WATER SERVICE LATERAL INFORMATION SHEET | | Street <u>Merlot Court</u> Lot <u>93</u> Civic _____ | |
|---|
| | | SLID# _____ | | | | | | | | | | | | | | | | | | | | | | | | | | | | | | | | | | | | | | | | | | | | | | | | | | | | | | | | | | | | | | | | | | | |
| <p>PUBLIC</p> <table border="1" style="width:100%; border-collapse: collapse;"> <thead> <tr> <th></th> <th>Water</th> <th>Sanitary</th> <th>Storm</th> </tr> </thead> <tbody> <tr> <td>LENGTH</td> <td><u>11.1m</u></td> <td><u>11.7m</u></td> <td><u>9.7m</u></td> </tr> <tr> <td>MATERIAL</td> <td><u>Polyethylene</u></td> <td><u>PVC DR28</u></td> <td><u>PVC DR35</u></td> </tr> <tr> <td>SIZE</td> <td><u>25mm</u></td> <td><u>125mm</u></td> <td><u>125mm</u></td> </tr> <tr> <td>COLOUR</td> <td><u>Blue</u></td> <td><u>White</u></td> <td><u>Green</u></td> </tr> <tr> <td>DEPTH @ MAIN</td> <td><u>1.88m</u></td> <td><u>3.02m</u></td> <td><u>3.08m</u></td> </tr> <tr> <td>DEPTH @ ST. LINE</td> <td><u>1.68m</u></td> <td><u>2.28m</u></td> <td><u>2.31m</u></td> </tr> <tr> <td>ELEV @ MAIN</td> <td><u>95.98</u></td> <td><u>94.84</u></td> <td><u>94.78</u></td> </tr> <tr> <td>ELEV @ ST. LINE</td> <td><u>96.33</u></td> <td><u>95.73</u></td> <td><u>95.70</u></td> </tr> <tr> <td>MAIN SIZE</td> <td><u>200mm</u></td> <td><u>200mm</u></td> <td><u>300mm</u></td> </tr> </tbody> </table> <p>Contractor <u>Dexter Construction</u> Inspected By <u>Trevor Carter - GENIVAR inc.</u> Date <u>March 2011</u> Record Dwg. # <u>D09109-003 001</u></p> <p> Insulation <input checked="" type="checkbox"/> Yes <input type="checkbox"/> No Rock <input type="checkbox"/> Yes <input type="checkbox"/> No Clay Plug <input type="checkbox"/> Yes <input type="checkbox"/> No Trace Wire <input checked="" type="checkbox"/> Yes <input type="checkbox"/> No Anode <input type="checkbox"/> Yes <input checked="" type="checkbox"/> No </p> | | Water | Sanitary | Storm | LENGTH | <u>11.1m</u> | <u>11.7m</u> | <u>9.7m</u> | MATERIAL | <u>Polyethylene</u> | <u>PVC DR28</u> | <u>PVC DR35</u> | SIZE | <u>25mm</u> | <u>125mm</u> | <u>125mm</u> | COLOUR | <u>Blue</u> | <u>White</u> | <u>Green</u> | DEPTH @ MAIN | <u>1.88m</u> | <u>3.02m</u> | <u>3.08m</u> | DEPTH @ ST. LINE | <u>1.68m</u> | <u>2.28m</u> | <u>2.31m</u> | ELEV @ MAIN | <u>95.98</u> | <u>94.84</u> | <u>94.78</u> | ELEV @ ST. LINE | <u>96.33</u> | <u>95.73</u> | <u>95.70</u> | MAIN SIZE | <u>200mm</u> | <u>200mm</u> | <u>300mm</u> | <p>PRIVATE</p> <table border="1" style="width:100%; border-collapse: collapse;"> <thead> <tr> <th></th> <th>Water</th> <th>Sanitary</th> <th>Storm</th> </tr> </thead> <tbody> <tr> <td>LENGTH</td> <td></td> <td></td> <td></td> </tr> <tr> <td>MATERIAL</td> <td></td> <td></td> <td></td> </tr> <tr> <td>SIZE</td> <td></td> <td></td> <td></td> </tr> <tr> <td>COLOUR</td> <td></td> <td></td> <td></td> </tr> <tr> <td>DEPTH @ ST. LINE</td> <td></td> <td></td> <td></td> </tr> <tr> <td>DEPTH @ BLDG</td> <td></td> <td></td> <td></td> </tr> </tbody> </table> <p> Contractor _____ Inspected By _____ Date _____ </p> <p> Sanitary Type: Pressurized <input type="checkbox"/> Gravity <input type="checkbox"/> Private Lift Station Info: Lift: <input type="checkbox"/> Distance <input type="checkbox"/> </p> <p> Insulation: <input type="checkbox"/> Yes <input type="checkbox"/> No Rock: <input type="checkbox"/> Yes <input type="checkbox"/> No Clay Plug: <input type="checkbox"/> Yes <input type="checkbox"/> No Foundation Drain Connected: <input type="checkbox"/> Yes <input type="checkbox"/> No Rain Leaders Connected: <input type="checkbox"/> Yes <input type="checkbox"/> No Trace Wire: <input type="checkbox"/> Yes <input type="checkbox"/> No Sound Check: <input type="checkbox"/> Yes <input type="checkbox"/> No </p> | | Water | Sanitary | Storm | LENGTH | | | | MATERIAL | | | | SIZE | | | | COLOUR | | | | DEPTH @ ST. LINE | | | | DEPTH @ BLDG | | | |
| | Water | Sanitary | Storm | | | | | | | | | | | | | | | | | | | | | | | | | | | | | | | | | | | | | | | | | | | | | | | | | | | | | | | | | | | | | | | | | | |
| LENGTH | <u>11.1m</u> | <u>11.7m</u> | <u>9.7m</u> | | | | | | | | | | | | | | | | | | | | | | | | | | | | | | | | | | | | | | | | | | | | | | | | | | | | | | | | | | | | | | | | | | |
| MATERIAL | <u>Polyethylene</u> | <u>PVC DR28</u> | <u>PVC DR35</u> | |
| SIZE | <u>25mm</u> | <u>125mm</u> | <u>125mm</u> | | | | | | | | | | | | | | | | | | | | | | | | | | | | | | | | | | | | | | | | | | | | | | | | | | | | | | | | | | | | | | | | | | |
| COLOUR | <u>Blue</u> | <u>White</u> | <u>Green</u> | | | | | | | | | | | | | | | | | | | | | | | | | | | | | | | | | | | | | | | | | | | | | | | | | | | | | | | | | | | | | | | | | | |
| DEPTH @ MAIN | <u>1.88m</u> | <u>3.02m</u> | <u>3.08m</u> | | | | | | | | | | | | | | | | | | | | | | | | | | | | | | | | | | | | | | | | | | | | | | | | | | | | | | | | | | | | | | | | | | |
| DEPTH @ ST. LINE | <u>1.68m</u> | <u>2.28m</u> | <u>2.31m</u> | | | | | | | | | | | | | | | | | | | | | | | | | | | | | | | | | | | | | | | | | | | | | | | | | | | | | | | | | | | | | | | | | | |
| ELEV @ MAIN | <u>95.98</u> | <u>94.84</u> | <u>94.78</u> | | | | | | | | | | | | | | | | | | | | | | | | | | | | | | | | | | | | | | | | | | | | | | | | | | | | | | | | | | | | | | | | | | |
| ELEV @ ST. LINE | <u>96.33</u> | <u>95.73</u> | <u>95.70</u> | | | | | | | | | | | | | | | | | | | | | | | | | | | | | | | | | | | | | | | | | | | | | | | | | | | | | | | | | | | | | | | | | | |
| MAIN SIZE | <u>200mm</u> | <u>200mm</u> | <u>300mm</u> | | | | | | | | | | | | | | | | | | | | | | | | | | | | | | | | | | | | | | | | | | | | | | | | | | | | | | | | | | | | | | | | | | |
| | Water | Sanitary | Storm | | | | | | | | | | | | | | | | | | | | | | | | | | | | | | | | | | | | | | | | | | | | | | | | | | | | | | | | | | | | | | | | | | |
| LENGTH | | | | | | | | | | | | | | | | | | | | | | | | | | | | | | | | | | | | | | | | | | | | | | | | | | | | | | | | | | | | | | | | | | | | | |
| MATERIAL | | | | | | | | | | | | | | | | | | | | | | | | | | | | | | | | | | | | | | | | | | | | | | | | | | | | | | | | | | | | | | | | | | | | | |
| SIZE | | | | | | | | | | | | | | | | | | | | | | | | | | | | | | | | | | | | | | | | | | | | | | | | | | | | | | | | | | | | | | | | | | | | | |
| COLOUR | | | | | | | | | | | | | | | | | | | | | | | | | | | | | | | | | | | | | | | | | | | | | | | | | | | | | | | | | | | | | | | | | | | | | |
| DEPTH @ ST. LINE | | | | | | | | | | | | | | | | | | | | | | | | | | | | | | | | | | | | | | | | | | | | | | | | | | | | | | | | | | | | | | | | | | | | | |
| DEPTH @ BLDG | | | | | | | | | | | | | | | | | | | | | | | | | | | | | | | | | | | | | | | | | | | | | | | | | | | | | | | | | | | | | | | | | | | | | |
| <p> <input checked="" type="radio"/> UPS <input type="radio"/> UP6 </p> <p> Curb Stop To: UPS = 40.1m UP6 = 19.2m Corp Stop To: UPS = 39.0m UP6 = 8.7m San End To: UPS = 40.2m UP6 = 20.9m </p> <p style="text-align: center;">Merlot Crst</p> <p style="text-align: center;"> PVC Water PVC SAN PVC STM </p> | | <p style="text-align: center;">PUBLIC</p> <p style="text-align: center;">MHS126</p> <p style="text-align: center;">MHT126</p> <p style="text-align: center;">PRIVATE</p> <p style="text-align: center;">92</p> <p style="text-align: center;">93</p> <p style="text-align: center;">94</p> | |
| | | SEE BACK FOR ADDITIONAL NOTES → | | | | | | | | | | | | | | | | | | | | | | | | | | | | | | | | | | | | | | | | | | | | | | | | | | | | | | | | | | | | | | | | | | | |


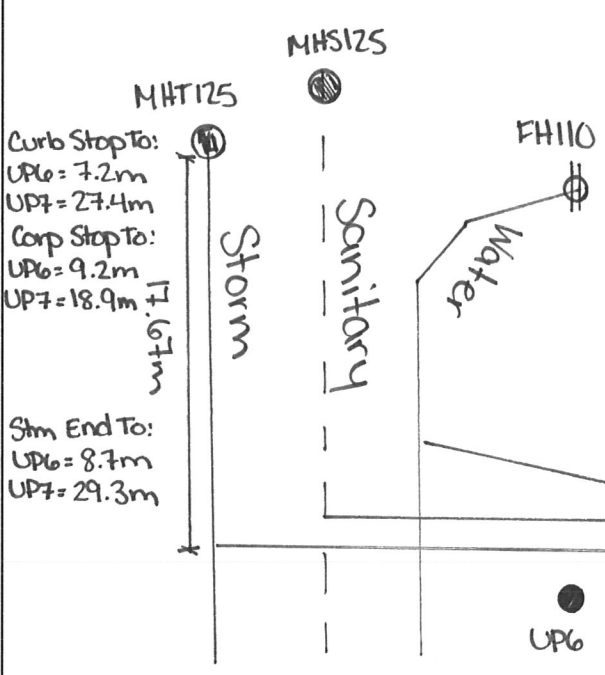
|  | HALIFAX WATER SERVICE LATERAL INFORMATION SHEET | Street <u>Merlot Court</u> Lot <u>94</u> Civic _____ | SLID# _____ | |
|---|
| <table border="1" style="width:100%; border-collapse: collapse;"> <thead> <tr> <th></th> <th style="text-align: center;">Water</th> <th style="text-align: center;">Sanitary</th> <th style="text-align: center;">Storm</th> </tr> </thead> <tbody> <tr> <td>LENGTH</td> <td style="text-align: center;">18.3m</td> <td style="text-align: center;">18.3m</td> <td style="text-align: center;">16.8m</td> </tr> <tr> <td>MATERIAL</td> <td style="text-align: center;">Polyethylene</td> <td style="text-align: center;">PVC DR28</td> <td style="text-align: center;">PVC DR35</td> </tr> <tr> <td>SIZE</td> <td style="text-align: center;">25mm</td> <td style="text-align: center;">125mm</td> <td style="text-align: center;">125mm</td> </tr> <tr> <td>COLOUR</td> <td style="text-align: center;">Blue</td> <td style="text-align: center;">White</td> <td style="text-align: center;">Green</td> </tr> <tr> <td>DEPTH @ MAIN</td> <td style="text-align: center;">1.92m</td> <td style="text-align: center;">2.96m</td> <td style="text-align: center;">2.99m</td> </tr> <tr> <td>DEPTH @ ST. LINE</td> <td style="text-align: center;">1.79m</td> <td style="text-align: center;">2.30m</td> <td style="text-align: center;">2.30m</td> </tr> <tr> <td>ELEV @ MAIN</td> <td style="text-align: center;">96.81</td> <td style="text-align: center;">95.77</td> <td style="text-align: center;">95.74</td> </tr> <tr> <td>ELEV @ ST. LINE</td> <td style="text-align: center;">97.06</td> <td style="text-align: center;">96.55</td> <td style="text-align: center;">96.54</td> </tr> <tr> <td>MAIN SIZE</td> <td style="text-align: center;">200mm</td> <td style="text-align: center;">200mm</td> <td style="text-align: center;">300mm</td> </tr> </tbody> </table> <p>Contractor <u>Dexter Construction</u> Inspected By <u>Trevor Carter - GENIVAR inc.</u> Date <u>March 2011</u> Record Dwg. # <u>D09109-003 001</u></p> <table style="width:100%;"> <tr> <td>Insulation <input checked="" type="checkbox"/> Yes <input type="checkbox"/> No</td> <td>Rock <input type="checkbox"/> Yes <input type="checkbox"/> No</td> <td>Clay Plug <input type="checkbox"/> Yes <input type="checkbox"/> No</td> <td>Trace Wire <input checked="" type="checkbox"/> Yes <input type="checkbox"/> No</td> <td>Anode <input type="checkbox"/> Yes <input checked="" type="checkbox"/> No</td> </tr> </table> | | Water | Sanitary | Storm | LENGTH | 18.3m | 18.3m | 16.8m | MATERIAL | Polyethylene | PVC DR28 | PVC DR35 | SIZE | 25mm | 125mm | 125mm | COLOUR | Blue | White | Green | DEPTH @ MAIN | 1.92m | 2.96m | 2.99m | DEPTH @ ST. LINE | 1.79m | 2.30m | 2.30m | ELEV @ MAIN | 96.81 | 95.77 | 95.74 | ELEV @ ST. LINE | 97.06 | 96.55 | 96.54 | MAIN SIZE | 200mm | 200mm | 300mm | Insulation <input checked="" type="checkbox"/> Yes <input type="checkbox"/> No | Rock <input type="checkbox"/> Yes <input type="checkbox"/> No | Clay Plug <input type="checkbox"/> Yes <input type="checkbox"/> No | Trace Wire <input checked="" type="checkbox"/> Yes <input type="checkbox"/> No | Anode <input type="checkbox"/> Yes <input checked="" type="checkbox"/> No | <table border="1" style="width:100%; border-collapse: collapse;"> <thead> <tr> <th></th> <th style="text-align: center;">Water</th> <th style="text-align: center;">Sanitary</th> <th style="text-align: center;">Storm</th> </tr> </thead> <tbody> <tr><td>LENGTH</td><td></td><td></td><td></td></tr> <tr><td>MATERIAL</td><td></td><td></td><td></td></tr> <tr><td>SIZE</td><td></td><td></td><td></td></tr> <tr><td>COLOUR</td><td></td><td></td><td></td></tr> <tr><td>DEPTH @ ST. LINE</td><td></td><td></td><td></td></tr> <tr><td>DEPTH @ BLDG</td><td></td><td></td><td></td></tr> </tbody> </table> <p>Contractor _____ Inspected By _____ Date _____</p> <p>Sanitary Type: Pressurized <input type="checkbox"/> Gravity <input type="checkbox"/> Private Lift Station Info: Lift: <input type="checkbox"/> Distance <input type="checkbox"/></p> <table style="width:100%;"> <tr> <td>Insulation <input type="checkbox"/> Yes <input type="checkbox"/> No</td> <td>Rock <input type="checkbox"/> Yes <input type="checkbox"/> No</td> <td>Clay Plug <input type="checkbox"/> Yes <input type="checkbox"/> No</td> <td>Foundation Drain Connected <input type="checkbox"/> Yes <input type="checkbox"/> No</td> <td>Rain Leaders Connected <input type="checkbox"/> Yes <input type="checkbox"/> No</td> <td>Trace Wire <input type="checkbox"/> Yes <input type="checkbox"/> No</td> <td>Sound Check <input type="checkbox"/> Yes <input type="checkbox"/> No</td> </tr> </table> | | Water | Sanitary | Storm | LENGTH | | | | MATERIAL | | | | SIZE | | | | COLOUR | | | | DEPTH @ ST. LINE | | | | DEPTH @ BLDG | | | | Insulation <input type="checkbox"/> Yes <input type="checkbox"/> No | Rock <input type="checkbox"/> Yes <input type="checkbox"/> No | Clay Plug <input type="checkbox"/> Yes <input type="checkbox"/> No | Foundation Drain Connected <input type="checkbox"/> Yes <input type="checkbox"/> No | Rain Leaders Connected <input type="checkbox"/> Yes <input type="checkbox"/> No | Trace Wire <input type="checkbox"/> Yes <input type="checkbox"/> No | Sound Check <input type="checkbox"/> Yes <input type="checkbox"/> No |
| | Water | Sanitary | Storm | | | | | | | | | | | | | | | | | | | | | | | | | | | | | | | | | | | | | | | | | | | | | | | | | | | | | | | | | | | | | | | | | | | | | | | | | | | | | | |
| LENGTH | 18.3m | 18.3m | 16.8m | | | | | | | | | | | | | | | | | | | | | | | | | | | | | | | | | | | | | | | | | | | | | | | | | | | | | | | | | | | | | | | | | | | | | | | | | | | | | | |
| MATERIAL | Polyethylene | PVC DR28 | PVC DR35 | |
| SIZE | 25mm | 125mm | 125mm | | | | | | | | | | | | | | | | | | | | | | | | | | | | | | | | | | | | | | | | | | | | | | | | | | | | | | | | | | | | | | | | | | | | | | | | | | | | | | |
| COLOUR | Blue | White | Green | | | | | | | | | | | | | | | | | | | | | | | | | | | | | | | | | | | | | | | | | | | | | | | | | | | | | | | | | | | | | | | | | | | | | | | | | | | | | | |
| DEPTH @ MAIN | 1.92m | 2.96m | 2.99m | | | | | | | | | | | | | | | | | | | | | | | | | | | | | | | | | | | | | | | | | | | | | | | | | | | | | | | | | | | | | | | | | | | | | | | | | | | | | | |
| DEPTH @ ST. LINE | 1.79m | 2.30m | 2.30m | |
| ELEV @ MAIN | 96.81 | 95.77 | 95.74 | | | | | | | | | | | | | | | | | | | | | | | | | | | | | | | | | | | | | | | | | | | | | | | | | | | | | | | | | | | | | | | | | | | | | | | | | | | | | | |
| ELEV @ ST. LINE | 97.06 | 96.55 | 96.54 | |
| MAIN SIZE | 200mm | 200mm | 300mm | | | | | | | | | | | | | | | | | | | | | | | | | | | | | | | | | | | | | | | | | | | | | | | | | | | | | | | | | | | | | | | | | | | | | | | | | | | | | | |
| Insulation <input checked="" type="checkbox"/> Yes <input type="checkbox"/> No | Rock <input type="checkbox"/> Yes <input type="checkbox"/> No | Clay Plug <input type="checkbox"/> Yes <input type="checkbox"/> No | Trace Wire <input checked="" type="checkbox"/> Yes <input type="checkbox"/> No | Anode <input type="checkbox"/> Yes <input checked="" type="checkbox"/> No | |
| | Water | Sanitary | Storm | | | | | | | | | | | | | | | | | | | | | | | | | | | | | | | | | | | | | | | | | | | | | | | | | | | | | | | | | | | | | | | | | | | | | | | | | | | | | | |
| LENGTH | | | | | | | | | | | | | | | | | | | | | | | | | | | | | | | | | | | | | | | | | | | | | | | | | | | | | | | | | | | | | | | | | | | | | | | | | | | | | | | | | |
| MATERIAL | | | | | | | | | | | | | | | | | | | | | | | | | | | | | | | | | | | | | | | | | | | | | | | | | | | | | | | | | | | | | | | | | | | | | | | | | | | | | | | | | |
| SIZE | | | | | | | | | | | | | | | | | | | | | | | | | | | | | | | | | | | | | | | | | | | | | | | | | | | | | | | | | | | | | | | | | | | | | | | | | | | | | | | | | |
| COLOUR | | | | | | | | | | | | | | | | | | | | | | | | | | | | | | | | | | | | | | | | | | | | | | | | | | | | | | | | | | | | | | | | | | | | | | | | | | | | | | | | | |
| DEPTH @ ST. LINE | | | | | | | | | | | | | | | | | | | | | | | | | | | | | | | | | | | | | | | | | | | | | | | | | | | | | | | | | | | | | | | | | | | | | | | | | | | | | | | | | |
| DEPTH @ BLDG | | | | | | | | | | | | | | | | | | | | | | | | | | | | | | | | | | | | | | | | | | | | | | | | | | | | | | | | | | | | | | | | | | | | | | | | | | | | | | | | | |
| Insulation <input type="checkbox"/> Yes <input type="checkbox"/> No | Rock <input type="checkbox"/> Yes <input type="checkbox"/> No | Clay Plug <input type="checkbox"/> Yes <input type="checkbox"/> No | Foundation Drain Connected <input type="checkbox"/> Yes <input type="checkbox"/> No | Rain Leaders Connected <input type="checkbox"/> Yes <input type="checkbox"/> No | Trace Wire <input type="checkbox"/> Yes <input type="checkbox"/> No | Sound Check <input type="checkbox"/> Yes <input type="checkbox"/> No | |
| <p style="text-align: center;">● UP6</p> <p style="text-align: center;">PUBLIC</p> <p>Curb Stop To: UP7 = 19.7m UP6 = 27.3m</p> <p>Corp Stop To: UP7 = 16.2m UP6 = 11.2m</p> <p>San End To: UP7 = 20.7m UP6 = 28.4</p> <p style="text-align: center;">Merlot Cr + Cudesac PVC Water</p> <p style="text-align: center;">PVC SAN 13.1m PVC STM. MHT125 MHT125</p> <p style="text-align: center;">● UP7</p> | <p style="text-align: center;">PRIVATE</p> <p style="text-align: center;">93</p> <p style="text-align: center;">94.</p> <p style="text-align: center;">95</p> <p style="text-align: right;">SEE BACK FOR ADDITIONAL NOTES →</p> | |


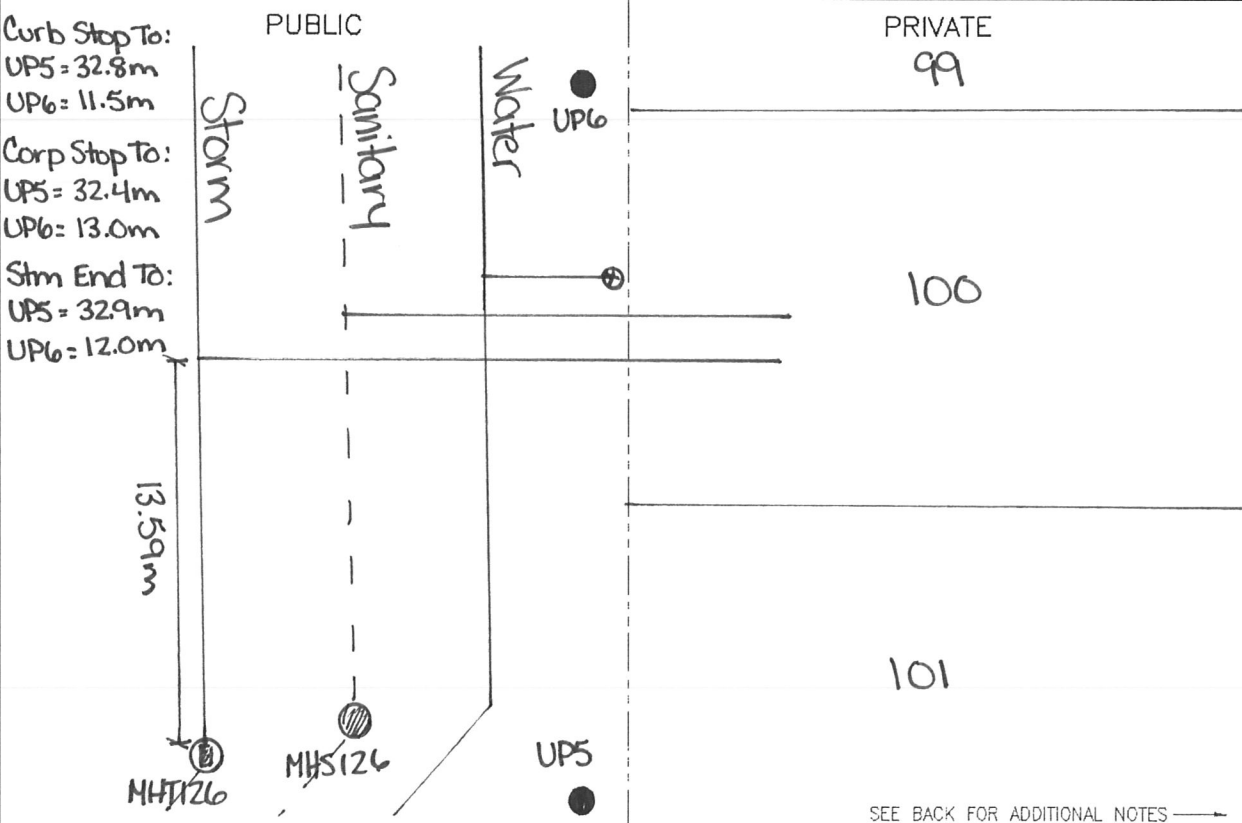
|  | HALIFAX WATER SERVICE LATERAL INFORMATION SHEET | Street <u>Merlot Court</u> Lot <u>95</u> Civic _____ | SLID# _____ | |
|---|
| <p>PUBLIC</p> <table border="1" style="width:100%; border-collapse: collapse;"> <thead> <tr> <th></th> <th>Water</th> <th>Sanitary</th> <th>Storm</th> </tr> </thead> <tbody> <tr> <td>LENGTH</td> <td><u>16.1m</u></td> <td><u>16.6m</u></td> <td><u>15.0m</u></td> </tr> <tr> <td>MATERIAL</td> <td><u>Polyethylene</u></td> <td><u>PVC DR28</u></td> <td><u>PVC DR35</u></td> </tr> <tr> <td>SIZE</td> <td><u>25mm</u></td> <td><u>125mm</u></td> <td><u>125mm</u></td> </tr> <tr> <td>COLOUR</td> <td><u>Blue</u></td> <td><u>White</u></td> <td><u>Green</u></td> </tr> <tr> <td>DEPTH @ MAIN</td> <td><u>1.96m</u></td> <td><u>2.89m</u></td> <td><u>2.81m</u></td> </tr> <tr> <td>DEPTH @ ST. LINE</td> <td><u>1.92m</u></td> <td><u>2.43m</u></td> <td><u>2.41m</u></td> </tr> <tr> <td>ELEV @ MAIN</td> <td><u>97.16</u></td> <td><u>96.23</u></td> <td><u>96.31</u></td> </tr> <tr> <td>ELEV @ ST. LINE</td> <td><u>97.75</u></td> <td><u>97.24</u></td> <td><u>97.26</u></td> </tr> <tr> <td>MAIN SIZE</td> <td><u>200 mm</u></td> <td><u>200 mm</u></td> <td><u>300 mm</u></td> </tr> </tbody> </table> <p>Contractor <u>Dexter Construction</u> Inspected By <u>Trevor Carter - GENIVAR inc.</u> Date <u>March 2011</u> Record Dwg. # <u>D09109-003 09</u></p> <p>Insulation Rock <input checked="" type="checkbox"/> Yes <input type="checkbox"/> No Clay Plug <input type="checkbox"/> Yes <input type="checkbox"/> No Trace Wire <input checked="" type="checkbox"/> Yes <input type="checkbox"/> No Anode <input type="checkbox"/> Yes <input checked="" type="checkbox"/> No</p> | | Water | Sanitary | Storm | LENGTH | <u>16.1m</u> | <u>16.6m</u> | <u>15.0m</u> | MATERIAL | <u>Polyethylene</u> | <u>PVC DR28</u> | <u>PVC DR35</u> | SIZE | <u>25mm</u> | <u>125mm</u> | <u>125mm</u> | COLOUR | <u>Blue</u> | <u>White</u> | <u>Green</u> | DEPTH @ MAIN | <u>1.96m</u> | <u>2.89m</u> | <u>2.81m</u> | DEPTH @ ST. LINE | <u>1.92m</u> | <u>2.43m</u> | <u>2.41m</u> | ELEV @ MAIN | <u>97.16</u> | <u>96.23</u> | <u>96.31</u> | ELEV @ ST. LINE | <u>97.75</u> | <u>97.24</u> | <u>97.26</u> | MAIN SIZE | <u>200 mm</u> | <u>200 mm</u> | <u>300 mm</u> | <p>PRIVATE</p> <table border="1" style="width:100%; border-collapse: collapse;"> <thead> <tr> <th></th> <th>Water</th> <th>Sanitary</th> <th>Storm</th> </tr> </thead> <tbody> <tr><td>LENGTH</td><td></td><td></td><td></td></tr> <tr><td>MATERIAL</td><td></td><td></td><td></td></tr> <tr><td>SIZE</td><td></td><td></td><td></td></tr> <tr><td>COLOUR</td><td></td><td></td><td></td></tr> <tr><td>DEPTH @ ST. LINE</td><td></td><td></td><td></td></tr> <tr><td>DEPTH @ BLDG</td><td></td><td></td><td></td></tr> </tbody> </table> <p>Contractor _____ Inspected By _____ Date _____</p> <p>Sanitary Type Pressurized <input type="checkbox"/> Gravity <input type="checkbox"/> Private Lift Lift: <input type="checkbox"/> Distance <input type="checkbox"/> Station Info.</p> <p>Insulation Rock <input type="checkbox"/> Yes <input type="checkbox"/> No Clay Plug <input type="checkbox"/> Yes <input type="checkbox"/> No Foundation Drain Connected <input type="checkbox"/> Yes <input type="checkbox"/> No Rain Leaders Connected <input type="checkbox"/> Yes <input type="checkbox"/> No Trace Wire <input type="checkbox"/> Yes <input type="checkbox"/> No Sound Check <input type="checkbox"/> Yes <input type="checkbox"/> No</p> | | Water | Sanitary | Storm | LENGTH | | | | MATERIAL | | | | SIZE | | | | COLOUR | | | | DEPTH @ ST. LINE | | | | DEPTH @ BLDG | | | |
| | Water | Sanitary | Storm | | | | | | | | | | | | | | | | | | | | | | | | | | | | | | | | | | | | | | | | | | | | | | | | | | | | | | | | | | | | | | | | | | |
| LENGTH | <u>16.1m</u> | <u>16.6m</u> | <u>15.0m</u> | | | | | | | | | | | | | | | | | | | | | | | | | | | | | | | | | | | | | | | | | | | | | | | | | | | | | | | | | | | | | | | | | | |
| MATERIAL | <u>Polyethylene</u> | <u>PVC DR28</u> | <u>PVC DR35</u> | |
| SIZE | <u>25mm</u> | <u>125mm</u> | <u>125mm</u> | | | | | | | | | | | | | | | | | | | | | | | | | | | | | | | | | | | | | | | | | | | | | | | | | | | | | | | | | | | | | | | | | | |
| COLOUR | <u>Blue</u> | <u>White</u> | <u>Green</u> | | | | | | | | | | | | | | | | | | | | | | | | | | | | | | | | | | | | | | | | | | | | | | | | | | | | | | | | | | | | | | | | | | |
| DEPTH @ MAIN | <u>1.96m</u> | <u>2.89m</u> | <u>2.81m</u> | | | | | | | | | | | | | | | | | | | | | | | | | | | | | | | | | | | | | | | | | | | | | | | | | | | | | | | | | | | | | | | | | | |
| DEPTH @ ST. LINE | <u>1.92m</u> | <u>2.43m</u> | <u>2.41m</u> | | | | | | | | | | | | | | | | | | | | | | | | | | | | | | | | | | | | | | | | | | | | | | | | | | | | | | | | | | | | | | | | | | |
| ELEV @ MAIN | <u>97.16</u> | <u>96.23</u> | <u>96.31</u> | | | | | | | | | | | | | | | | | | | | | | | | | | | | | | | | | | | | | | | | | | | | | | | | | | | | | | | | | | | | | | | | | | |
| ELEV @ ST. LINE | <u>97.75</u> | <u>97.24</u> | <u>97.26</u> | | | | | | | | | | | | | | | | | | | | | | | | | | | | | | | | | | | | | | | | | | | | | | | | | | | | | | | | | | | | | | | | | | |
| MAIN SIZE | <u>200 mm</u> | <u>200 mm</u> | <u>300 mm</u> | | | | | | | | | | | | | | | | | | | | | | | | | | | | | | | | | | | | | | | | | | | | | | | | | | | | | | | | | | | | | | | | | | |
| | Water | Sanitary | Storm | | | | | | | | | | | | | | | | | | | | | | | | | | | | | | | | | | | | | | | | | | | | | | | | | | | | | | | | | | | | | | | | | | |
| LENGTH | | | | | | | | | | | | | | | | | | | | | | | | | | | | | | | | | | | | | | | | | | | | | | | | | | | | | | | | | | | | | | | | | | | | | |
| MATERIAL | | | | | | | | | | | | | | | | | | | | | | | | | | | | | | | | | | | | | | | | | | | | | | | | | | | | | | | | | | | | | | | | | | | | | |
| SIZE | | | | | | | | | | | | | | | | | | | | | | | | | | | | | | | | | | | | | | | | | | | | | | | | | | | | | | | | | | | | | | | | | | | | | |
| COLOUR | | | | | | | | | | | | | | | | | | | | | | | | | | | | | | | | | | | | | | | | | | | | | | | | | | | | | | | | | | | | | | | | | | | | | |
| DEPTH @ ST. LINE | | | | | | | | | | | | | | | | | | | | | | | | | | | | | | | | | | | | | | | | | | | | | | | | | | | | | | | | | | | | | | | | | | | | | |
| DEPTH @ BLDG | | | | | | | | | | | | | | | | | | | | | | | | | | | | | | | | | | | | | | | | | | | | | | | | | | | | | | | | | | | | | | | | | | | | | |
|  <p>PUBLIC</p> <p>Curb Stop To: UP6 = 31.0m UP7 = 7.6m</p> <p>Corp Stop To: UP6 = 15.7m UP7 = 11.1m</p> <p>San End To: UP6 = 32.6m UP7 = 9.2m</p> | <p>PRIVATE</p> <p style="font-size: 2em; text-align: center;">94.</p> <p style="font-size: 2em; text-align: center;">95</p> <p style="font-size: 2em; text-align: center;">96.</p> <p style="text-align: right;">SEE BACK FOR ADDITIONAL NOTES →</p> | |

|  | HALIFAX WATER SERVICE LATERAL INFORMATION SHEET | Street <u>Merlot Court</u> Lot <u>96</u> Civic _____ | SLID# _____ | |
|---|
| <table border="1" style="width:100%; border-collapse: collapse;"> <thead> <tr> <th style="width:10%;"></th> <th style="width:30%;">Water</th> <th style="width:30%;">Sanitary</th> <th style="width:30%;">Storm</th> </tr> </thead> <tbody> <tr> <td>LENGTH</td> <td>11.8m</td> <td>10.13m</td> <td>7.65m</td> </tr> <tr> <td>MATERIAL</td> <td>Polyethylene</td> <td>PVC DR28</td> <td>PVC DR35</td> </tr> <tr> <td>SIZE</td> <td>25mm</td> <td>125mm</td> <td>125mm</td> </tr> <tr> <td>COLOUR</td> <td>Blue</td> <td>White</td> <td>Green</td> </tr> <tr> <td>DEPTH @ MAIN</td> <td>1.9m</td> <td>2.8m</td> <td>2.8m</td> </tr> <tr> <td>DEPTH @ ST. LINE</td> <td>1.7m</td> <td>2.4m</td> <td>2.4m</td> </tr> <tr> <td>ELEV @ MAIN</td> <td>97.25</td> <td>96.63</td> <td>96.73</td> </tr> <tr> <td>ELEV @ ST. LINE</td> <td>98.12</td> <td>97.63</td> <td>97.63</td> </tr> <tr> <td>MAIN SIZE</td> <td>200mm</td> <td>200mm</td> <td>300mm</td> </tr> </tbody> </table> <p>Contractor <u>Dexter Construction</u> Inspected By <u>Trevor Carter - GENIVAR inc.</u> Date <u>March 2011</u> Record Dwg. # <u>D9109-003 001</u></p> <table style="width:100%;"> <tr> <td>Insulation <input checked="" type="checkbox"/> Yes <input type="checkbox"/> No</td> <td>Rock <input type="checkbox"/> Yes <input type="checkbox"/> No</td> <td>Clay Plug <input type="checkbox"/> Yes <input type="checkbox"/> No</td> <td>Trace Wire <input checked="" type="checkbox"/> Yes <input type="checkbox"/> No</td> <td>Anode <input type="checkbox"/> Yes <input checked="" type="checkbox"/> No</td> </tr> </table> | | Water | Sanitary | Storm | LENGTH | 11.8m | 10.13m | 7.65m | MATERIAL | Polyethylene | PVC DR28 | PVC DR35 | SIZE | 25mm | 125mm | 125mm | COLOUR | Blue | White | Green | DEPTH @ MAIN | 1.9m | 2.8m | 2.8m | DEPTH @ ST. LINE | 1.7m | 2.4m | 2.4m | ELEV @ MAIN | 97.25 | 96.63 | 96.73 | ELEV @ ST. LINE | 98.12 | 97.63 | 97.63 | MAIN SIZE | 200mm | 200mm | 300mm | Insulation <input checked="" type="checkbox"/> Yes <input type="checkbox"/> No | Rock <input type="checkbox"/> Yes <input type="checkbox"/> No | Clay Plug <input type="checkbox"/> Yes <input type="checkbox"/> No | Trace Wire <input checked="" type="checkbox"/> Yes <input type="checkbox"/> No | Anode <input type="checkbox"/> Yes <input checked="" type="checkbox"/> No | <table border="1" style="width:100%; border-collapse: collapse;"> <thead> <tr> <th style="width:10%;"></th> <th style="width:30%;">Water</th> <th style="width:30%;">Sanitary</th> <th style="width:30%;">Storm</th> </tr> </thead> <tbody> <tr><td>LENGTH</td><td></td><td></td><td></td></tr> <tr><td>MATERIAL</td><td></td><td></td><td></td></tr> <tr><td>SIZE</td><td></td><td></td><td></td></tr> <tr><td>COLOUR</td><td></td><td></td><td></td></tr> <tr><td>DEPTH @ ST. LINE</td><td></td><td></td><td></td></tr> <tr><td>DEPTH @ BLDG</td><td></td><td></td><td></td></tr> </tbody> </table> <p>Contractor _____ Inspected By _____ Date _____</p> <p>Sanitary Type: Pressurized <input type="checkbox"/> Gravity <input type="checkbox"/> Private Lift Station Info: Lift: <input type="checkbox"/> Distance <input type="checkbox"/></p> <table style="width:100%;"> <tr> <td>Insulation <input type="checkbox"/> Yes <input type="checkbox"/> No</td> <td>Rock <input type="checkbox"/> Yes <input type="checkbox"/> No</td> <td>Clay Plug <input type="checkbox"/> Yes <input type="checkbox"/> No</td> <td>Foundation Drain Connected <input type="checkbox"/> Yes <input type="checkbox"/> No</td> <td>Rain Leaders Connected <input type="checkbox"/> Yes <input type="checkbox"/> No</td> <td>Trace Wire <input type="checkbox"/> Yes <input type="checkbox"/> No</td> <td>Sound Check <input type="checkbox"/> Yes <input type="checkbox"/> No</td> </tr> </table> | | Water | Sanitary | Storm | LENGTH | | | | MATERIAL | | | | SIZE | | | | COLOUR | | | | DEPTH @ ST. LINE | | | | DEPTH @ BLDG | | | | Insulation <input type="checkbox"/> Yes <input type="checkbox"/> No | Rock <input type="checkbox"/> Yes <input type="checkbox"/> No | Clay Plug <input type="checkbox"/> Yes <input type="checkbox"/> No | Foundation Drain Connected <input type="checkbox"/> Yes <input type="checkbox"/> No | Rain Leaders Connected <input type="checkbox"/> Yes <input type="checkbox"/> No | Trace Wire <input type="checkbox"/> Yes <input type="checkbox"/> No | Sound Check <input type="checkbox"/> Yes <input type="checkbox"/> No |
| | Water | Sanitary | Storm | | | | | | | | | | | | | | | | | | | | | | | | | | | | | | | | | | | | | | | | | | | | | | | | | | | | | | | | | | | | | | | | | | | | | | | | | | | | | | |
| LENGTH | 11.8m | 10.13m | 7.65m | | | | | | | | | | | | | | | | | | | | | | | | | | | | | | | | | | | | | | | | | | | | | | | | | | | | | | | | | | | | | | | | | | | | | | | | | | | | | | |
| MATERIAL | Polyethylene | PVC DR28 | PVC DR35 | |
| SIZE | 25mm | 125mm | 125mm | | | | | | | | | | | | | | | | | | | | | | | | | | | | | | | | | | | | | | | | | | | | | | | | | | | | | | | | | | | | | | | | | | | | | | | | | | | | | | |
| COLOUR | Blue | White | Green | | | | | | | | | | | | | | | | | | | | | | | | | | | | | | | | | | | | | | | | | | | | | | | | | | | | | | | | | | | | | | | | | | | | | | | | | | | | | | |
| DEPTH @ MAIN | 1.9m | 2.8m | 2.8m | | | | | | | | | | | | | | | | | | | | | | | | | | | | | | | | | | | | | | | | | | | | | | | | | | | | | | | | | | | | | | | | | | | | | | | | | | | | | | |
| DEPTH @ ST. LINE | 1.7m | 2.4m | 2.4m | | | | | | | | | | | | | | | | | | | | | | | | | | | | | | | | | | | | | | | | | | | | | | | | | | | | | | | | | | | | | | | | | | | | | | | | | | | | | | |
| ELEV @ MAIN | 97.25 | 96.63 | 96.73 | | | | | | | | | | | | | | | | | | | | | | | | | | | | | | | | | | | | | | | | | | | | | | | | | | | | | | | | | | | | | | | | | | | | | | | | | | | | | | |
| ELEV @ ST. LINE | 98.12 | 97.63 | 97.63 | |
| MAIN SIZE | 200mm | 200mm | 300mm | | | | | | | | | | | | | | | | | | | | | | | | | | | | | | | | | | | | | | | | | | | | | | | | | | | | | | | | | | | | | | | | | | | | | | | | | | | | | | |
| Insulation <input checked="" type="checkbox"/> Yes <input type="checkbox"/> No | Rock <input type="checkbox"/> Yes <input type="checkbox"/> No | Clay Plug <input type="checkbox"/> Yes <input type="checkbox"/> No | Trace Wire <input checked="" type="checkbox"/> Yes <input type="checkbox"/> No | Anode <input type="checkbox"/> Yes <input checked="" type="checkbox"/> No | |
| | Water | Sanitary | Storm | | | | | | | | | | | | | | | | | | | | | | | | | | | | | | | | | | | | | | | | | | | | | | | | | | | | | | | | | | | | | | | | | | | | | | | | | | | | | | |
| LENGTH | | | | | | | | | | | | | | | | | | | | | | | | | | | | | | | | | | | | | | | | | | | | | | | | | | | | | | | | | | | | | | | | | | | | | | | | | | | | | | | | | |
| MATERIAL | | | | | | | | | | | | | | | | | | | | | | | | | | | | | | | | | | | | | | | | | | | | | | | | | | | | | | | | | | | | | | | | | | | | | | | | | | | | | | | | | |
| SIZE | | | | | | | | | | | | | | | | | | | | | | | | | | | | | | | | | | | | | | | | | | | | | | | | | | | | | | | | | | | | | | | | | | | | | | | | | | | | | | | | | |
| COLOUR | | | | | | | | | | | | | | | | | | | | | | | | | | | | | | | | | | | | | | | | | | | | | | | | | | | | | | | | | | | | | | | | | | | | | | | | | | | | | | | | | |
| DEPTH @ ST. LINE | | | | | | | | | | | | | | | | | | | | | | | | | | | | | | | | | | | | | | | | | | | | | | | | | | | | | | | | | | | | | | | | | | | | | | | | | | | | | | | | | |
| DEPTH @ BLDG | | | | | | | | | | | | | | | | | | | | | | | | | | | | | | | | | | | | | | | | | | | | | | | | | | | | | | | | | | | | | | | | | | | | | | | | | | | | | | | | | |
| Insulation <input type="checkbox"/> Yes <input type="checkbox"/> No | Rock <input type="checkbox"/> Yes <input type="checkbox"/> No | Clay Plug <input type="checkbox"/> Yes <input type="checkbox"/> No | Foundation Drain Connected <input type="checkbox"/> Yes <input type="checkbox"/> No | Rain Leaders Connected <input type="checkbox"/> Yes <input type="checkbox"/> No | Trace Wire <input type="checkbox"/> Yes <input type="checkbox"/> No | Sound Check <input type="checkbox"/> Yes <input type="checkbox"/> No | |
| <table style="width:100%;"> <tr> <th style="width:50%;">PUBLIC</th> <th style="width:50%;">PRIVATE</th> </tr> </table>  <p> Curb Stop To: UP6 = 28.9m UP7 = 3.5m Corp Stop To: UP6 = 17.2m UP7 = 9.9m San Encl To: UP6 = 29.9m UP7 = 7.7m </p> <p>Merlot Court Culdesac</p> <p>● UP6</p> | PUBLIC | PRIVATE | <p style="text-align: center;">SEE BACK FOR ADDITIONAL NOTES →</p> | |
| PUBLIC | PRIVATE | | | | | | | | | | | | | | | | | | | | | | | | | | | | | | | | | | | | | | | | | | | | | | | | | | | | | | | | | | | | | | | | | | | | | | | | | | | | | | | | |


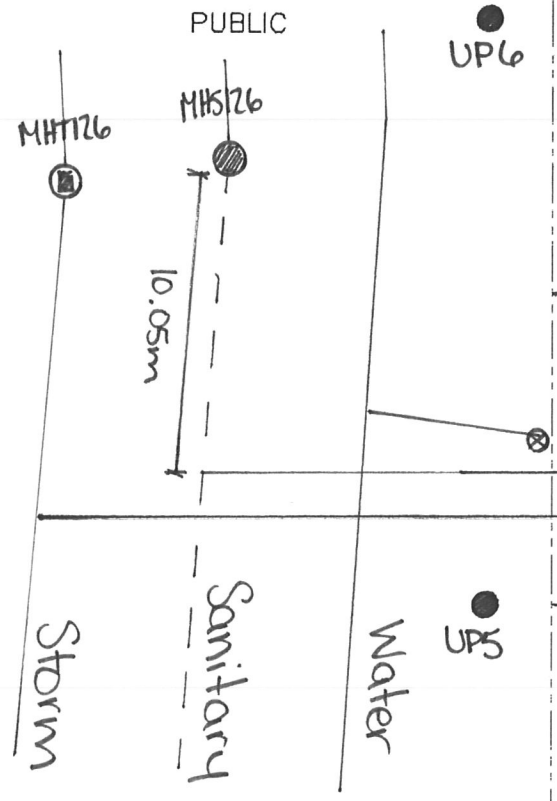
|  | HALIFAX WATER SERVICE LATERAL INFORMATION SHEET | Street <u>Merlot Court</u> Lot <u>97</u> Civic _____ | |
|---|
| <p style="text-align: center;">PUBLIC</p> <table border="1" style="width:100%; border-collapse: collapse;"> <thead> <tr> <th></th> <th>Water</th> <th>Sanitary</th> <th>Storm</th> </tr> </thead> <tbody> <tr> <td>LENGTH</td> <td>9.31m</td> <td>10.84m</td> <td>13.46m</td> </tr> <tr> <td>MATERIAL</td> <td>Polyethylene</td> <td>PVC DR28</td> <td>PVC DR35</td> </tr> <tr> <td>SIZE</td> <td>25mm</td> <td>125mm</td> <td>125mm</td> </tr> <tr> <td>COLOUR</td> <td>Blue</td> <td>White</td> <td>Green</td> </tr> <tr> <td>DEPTH @ MAIN</td> <td>1.9m</td> <td>2.8m</td> <td>3.0m</td> </tr> <tr> <td>DEPTH @ ST. LINE</td> <td>1.7m</td> <td>2.6m</td> <td>2.6m</td> </tr> <tr> <td>ELEV @ MAIN</td> <td>97.33</td> <td>96.54</td> <td>96.40</td> </tr> <tr> <td>ELEV @ ST. LINE</td> <td>98.04</td> <td>97.34</td> <td>97.33</td> </tr> <tr> <td>MAIN SIZE</td> <td>200mm</td> <td>200mm</td> <td>300mm</td> </tr> </tbody> </table> <p>Contractor <u>Dexter Construction</u> Inspected By <u>Trevor Carter - GENIVAR inc.</u> Date <u>March 2011</u> Record Dwg. # <u>D09109-003 001</u></p> <p> Insulation <input checked="" type="checkbox"/> Yes <input type="checkbox"/> No Rock <input type="checkbox"/> Yes <input type="checkbox"/> No Clay Plug <input type="checkbox"/> Yes <input type="checkbox"/> No Trace Wire <input checked="" type="checkbox"/> Yes <input type="checkbox"/> No Anode <input type="checkbox"/> Yes <input checked="" type="checkbox"/> No </p> | | | Water | Sanitary | Storm | LENGTH | 9.31m | 10.84m | 13.46m | MATERIAL | Polyethylene | PVC DR28 | PVC DR35 | SIZE | 25mm | 125mm | 125mm | COLOUR | Blue | White | Green | DEPTH @ MAIN | 1.9m | 2.8m | 3.0m | DEPTH @ ST. LINE | 1.7m | 2.6m | 2.6m | ELEV @ MAIN | 97.33 | 96.54 | 96.40 | ELEV @ ST. LINE | 98.04 | 97.34 | 97.33 | MAIN SIZE | 200mm | 200mm | 300mm | <p style="text-align: right;">SLID# _____</p> <p style="text-align: center;">PRIVATE</p> <table border="1" style="width:100%; border-collapse: collapse;"> <thead> <tr> <th></th> <th>Water</th> <th>Sanitary</th> <th>Storm</th> </tr> </thead> <tbody> <tr><td>LENGTH</td><td></td><td></td><td></td></tr> <tr><td>MATERIAL</td><td></td><td></td><td></td></tr> <tr><td>SIZE</td><td></td><td></td><td></td></tr> <tr><td>COLOUR</td><td></td><td></td><td></td></tr> <tr><td>DEPTH @ ST. LINE</td><td></td><td></td><td></td></tr> <tr><td>DEPTH @ BLDG</td><td></td><td></td><td></td></tr> </tbody> </table> <p>Contractor _____ Inspected By _____ Date _____</p> <p>Sanitary Type Pressurized <input type="checkbox"/> Gravity <input type="checkbox"/> Private Lift Station Info. Lift: <input type="checkbox"/> Distance <input type="checkbox"/></p> <p> Insulation <input type="checkbox"/> Yes <input type="checkbox"/> No Rock <input type="checkbox"/> Yes <input type="checkbox"/> No Clay Plug <input type="checkbox"/> Yes <input type="checkbox"/> No Foundation Drain Connected <input type="checkbox"/> Yes <input type="checkbox"/> No Rain Leaders Connected <input type="checkbox"/> Yes <input type="checkbox"/> No Trace Wire <input type="checkbox"/> Yes <input type="checkbox"/> No Sound Check <input type="checkbox"/> Yes <input type="checkbox"/> No </p> | | Water | Sanitary | Storm | LENGTH | | | | MATERIAL | | | | SIZE | | | | COLOUR | | | | DEPTH @ ST. LINE | | | | DEPTH @ BLDG | | | |
| | Water | Sanitary | Storm | | | | | | | | | | | | | | | | | | | | | | | | | | | | | | | | | | | | | | | | | | | | | | | | | | | | | | | | | | | | | | | | | | | |
| LENGTH | 9.31m | 10.84m | 13.46m | | | | | | | | | | | | | | | | | | | | | | | | | | | | | | | | | | | | | | | | | | | | | | | | | | | | | | | | | | | | | | | | | | | |
| MATERIAL | Polyethylene | PVC DR28 | PVC DR35 | | | | | | | | | | | | | | | | | | | | | | | | | | | | | | | | | | | | | | | | | | | | | | | | | | | | | | | | | | | | | | | | | | | |
| SIZE | 25mm | 125mm | 125mm | | | | | | | | | | | | | | | | | | | | | | | | | | | | | | | | | | | | | | | | | | | | | | | | | | | | | | | | | | | | | | | | | | | |
| COLOUR | Blue | White | Green | | | | | | | | | | | | | | | | | | | | | | | | | | | | | | | | | | | | | | | | | | | | | | | | | | | | | | | | | | | | | | | | | | | |
| DEPTH @ MAIN | 1.9m | 2.8m | 3.0m | | | | | | | | | | | | | | | | | | | | | | | | | | | | | | | | | | | | | | | | | | | | | | | | | | | | | | | | | | | | | | | | | | | |
| DEPTH @ ST. LINE | 1.7m | 2.6m | 2.6m | | | | | | | | | | | | | | | | | | | | | | | | | | | | | | | | | | | | | | | | | | | | | | | | | | | | | | | | | | | | | | | | | | | |
| ELEV @ MAIN | 97.33 | 96.54 | 96.40 | | | | | | | | | | | | | | | | | | | | | | | | | | | | | | | | | | | | | | | | | | | | | | | | | | | | | | | | | | | | | | | | | | | |
| ELEV @ ST. LINE | 98.04 | 97.34 | 97.33 | | | | | | | | | | | | | | | | | | | | | | | | | | | | | | | | | | | | | | | | | | | | | | | | | | | | | | | | | | | | | | | | | | | |
| MAIN SIZE | 200mm | 200mm | 300mm | | | | | | | | | | | | | | | | | | | | | | | | | | | | | | | | | | | | | | | | | | | | | | | | | | | | | | | | | | | | | | | | | | | |
| | Water | Sanitary | Storm | | | | | | | | | | | | | | | | | | | | | | | | | | | | | | | | | | | | | | | | | | | | | | | | | | | | | | | | | | | | | | | | | | | |
| LENGTH | | | | | | | | | | | | | | | | | | | | | | | | | | | | | | | | | | | | | | | | | | | | | | | | | | | | | | | | | | | | | | | | | | | | | | |
| MATERIAL | | | | | | | | | | | | | | | | | | | | | | | | | | | | | | | | | | | | | | | | | | | | | | | | | | | | | | | | | | | | | | | | | | | | | | |
| SIZE | | | | | | | | | | | | | | | | | | | | | | | | | | | | | | | | | | | | | | | | | | | | | | | | | | | | | | | | | | | | | | | | | | | | | | |
| COLOUR | | | | | | | | | | | | | | | | | | | | | | | | | | | | | | | | | | | | | | | | | | | | | | | | | | | | | | | | | | | | | | | | | | | | | | |
| DEPTH @ ST. LINE | | | | | | | | | | | | | | | | | | | | | | | | | | | | | | | | | | | | | | | | | | | | | | | | | | | | | | | | | | | | | | | | | | | | | | |
| DEPTH @ BLDG | | | | | | | | | | | | | | | | | | | | | | | | | | | | | | | | | | | | | | | | | | | | | | | | | | | | | | | | | | | | | | | | | | | | | | |
| <p style="text-align: center;">PUBLIC</p>  <p> Curb Stop To: UP6 = 25.9m UP7 = 10.4m Corp Stop To: UP6 = 17.7m UP7 = 10.5m Strm End To: UP6 = 27.1m UP7 = 11.4m </p> <p style="text-align: right;">SEE BACK FOR ADDITIONAL NOTES →</p> | |

| HALIFAX WATER SERVICE LATERAL INFORMATION SHEET | | Street <u>Merlot Court</u> Lot <u>98</u> Civic _____ | |
|---|
| | | SLID# _____ | | | | | | | | | | | | | | | | | | | | | | | | | | | | | | | | | | | | | | | | | | | | | | | | | | | | | | | | | | | | | | | | | | | |
| <p>PUBLIC</p> <table border="1" style="width:100%; border-collapse: collapse;"> <thead> <tr> <th></th> <th>Water</th> <th>Sanitary</th> <th>Storm</th> </tr> </thead> <tbody> <tr> <td>LENGTH</td> <td>9.3m</td> <td>17.67m</td> <td>18.94m</td> </tr> <tr> <td>MATERIAL</td> <td>Polyethylene</td> <td>PVC DR28</td> <td>PVC DR35</td> </tr> <tr> <td>SIZE</td> <td>25mm</td> <td>125mm</td> <td>125mm</td> </tr> <tr> <td>COLOUR</td> <td>Blue</td> <td>White</td> <td>Green</td> </tr> <tr> <td>DEPTH @ MAIN</td> <td>1.9m</td> <td>3.2m</td> <td>2.9m</td> </tr> <tr> <td>DEPTH @ ST. LINE</td> <td>1.7m</td> <td>2.6m</td> <td>2.6m</td> </tr> <tr> <td>ELEV @ MAIN</td> <td>97.40</td> <td>96.09</td> <td>96.09</td> </tr> <tr> <td>ELEV @ ST. LINE</td> <td>97.55</td> <td>96.91</td> <td>96.90</td> </tr> <tr> <td>MAIN SIZE</td> <td>200mm</td> <td>200mm</td> <td>300mm</td> </tr> </tbody> </table> <p>Contractor <u>Dexter Construction</u> Inspected By <u>Trevor Carter - GENIVAR inc.</u> Date <u>March 2011</u> Record Dwg. # <u>D09109-003 001</u></p> <p> <input checked="" type="checkbox"/> Insulation Yes <input type="checkbox"/> No <input type="checkbox"/> Rock Yes <input type="checkbox"/> No <input type="checkbox"/> Clay Plug Yes <input type="checkbox"/> No <input checked="" type="checkbox"/> Trace Wire Yes <input type="checkbox"/> No <input type="checkbox"/> Anode Yes <input checked="" type="checkbox"/> No </p> | | Water | Sanitary | Storm | LENGTH | 9.3m | 17.67m | 18.94m | MATERIAL | Polyethylene | PVC DR28 | PVC DR35 | SIZE | 25mm | 125mm | 125mm | COLOUR | Blue | White | Green | DEPTH @ MAIN | 1.9m | 3.2m | 2.9m | DEPTH @ ST. LINE | 1.7m | 2.6m | 2.6m | ELEV @ MAIN | 97.40 | 96.09 | 96.09 | ELEV @ ST. LINE | 97.55 | 96.91 | 96.90 | MAIN SIZE | 200mm | 200mm | 300mm | <p>PRIVATE</p> <table border="1" style="width:100%; border-collapse: collapse;"> <thead> <tr> <th></th> <th>Water</th> <th>Sanitary</th> <th>Storm</th> </tr> </thead> <tbody> <tr> <td>LENGTH</td> <td></td> <td></td> <td></td> </tr> <tr> <td>MATERIAL</td> <td></td> <td></td> <td></td> </tr> <tr> <td>SIZE</td> <td></td> <td></td> <td></td> </tr> <tr> <td>COLOUR</td> <td></td> <td></td> <td></td> </tr> <tr> <td>DEPTH @ ST. LINE</td> <td></td> <td></td> <td></td> </tr> <tr> <td>DEPTH @ BLDG</td> <td></td> <td></td> <td></td> </tr> </tbody> </table> <p>Contractor _____ Inspected By _____ Date _____</p> <p>Sanitary Type: Pressurized <input type="checkbox"/> <input type="checkbox"/> Gravity Private Lift: Lift: <input type="checkbox"/> <input type="checkbox"/> Distance</p> <p> <input type="checkbox"/> Insulation Yes <input type="checkbox"/> No <input type="checkbox"/> Rock Yes <input type="checkbox"/> No <input type="checkbox"/> Clay Plug Yes <input type="checkbox"/> No <input type="checkbox"/> Foundation Drain Connected Yes <input type="checkbox"/> No <input type="checkbox"/> Rain Leaders Connected Yes <input type="checkbox"/> No <input type="checkbox"/> Trace Wire Yes <input type="checkbox"/> No <input type="checkbox"/> Sound Check Yes <input type="checkbox"/> No </p> | | Water | Sanitary | Storm | LENGTH | | | | MATERIAL | | | | SIZE | | | | COLOUR | | | | DEPTH @ ST. LINE | | | | DEPTH @ BLDG | | | |
| | Water | Sanitary | Storm | | | | | | | | | | | | | | | | | | | | | | | | | | | | | | | | | | | | | | | | | | | | | | | | | | | | | | | | | | | | | | | | | | |
| LENGTH | 9.3m | 17.67m | 18.94m | | | | | | | | | | | | | | | | | | | | | | | | | | | | | | | | | | | | | | | | | | | | | | | | | | | | | | | | | | | | | | | | | | |
| MATERIAL | Polyethylene | PVC DR28 | PVC DR35 | | | | | | | | | | | | | | | | | | | | | | | | | | | | | | | | | | | | | | | | | | | | | | | | | | | | | | | | | | | | | | | | | | |
| SIZE | 25mm | 125mm | 125mm | | | | | | | | | | | | | | | | | | | | | | | | | | | | | | | | | | | | | | | | | | | | | | | | | | | | | | | | | | | | | | | | | | |
| COLOUR | Blue | White | Green | | | | | | | | | | | | | | | | | | | | | | | | | | | | | | | | | | | | | | | | | | | | | | | | | | | | | | | | | | | | | | | | | | |
| DEPTH @ MAIN | 1.9m | 3.2m | 2.9m | | | | | | | | | | | | | | | | | | | | | | | | | | | | | | | | | | | | | | | | | | | | | | | | | | | | | | | | | | | | | | | | | | |
| DEPTH @ ST. LINE | 1.7m | 2.6m | 2.6m | | | | | | | | | | | | | | | | | | | | | | | | | | | | | | | | | | | | | | | | | | | | | | | | | | | | | | | | | | | | | | | | | | |
| ELEV @ MAIN | 97.40 | 96.09 | 96.09 | | | | | | | | | | | | | | | | | | | | | | | | | | | | | | | | | | | | | | | | | | | | | | | | | | | | | | | | | | | | | | | | | | |
| ELEV @ ST. LINE | 97.55 | 96.91 | 96.90 | | | | | | | | | | | | | | | | | | | | | | | | | | | | | | | | | | | | | | | | | | | | | | | | | | | | | | | | | | | | | | | | | | |
| MAIN SIZE | 200mm | 200mm | 300mm | | | | | | | | | | | | | | | | | | | | | | | | | | | | | | | | | | | | | | | | | | | | | | | | | | | | | | | | | | | | | | | | | | |
| | Water | Sanitary | Storm | | | | | | | | | | | | | | | | | | | | | | | | | | | | | | | | | | | | | | | | | | | | | | | | | | | | | | | | | | | | | | | | | | |
| LENGTH | | | | | | | | | | | | | | | | | | | | | | | | | | | | | | | | | | | | | | | | | | | | | | | | | | | | | | | | | | | | | | | | | | | | | |
| MATERIAL | | | | | | | | | | | | | | | | | | | | | | | | | | | | | | | | | | | | | | | | | | | | | | | | | | | | | | | | | | | | | | | | | | | | | |
| SIZE | | | | | | | | | | | | | | | | | | | | | | | | | | | | | | | | | | | | | | | | | | | | | | | | | | | | | | | | | | | | | | | | | | | | | |
| COLOUR | | | | | | | | | | | | | | | | | | | | | | | | | | | | | | | | | | | | | | | | | | | | | | | | | | | | | | | | | | | | | | | | | | | | | |
| DEPTH @ ST. LINE | | | | | | | | | | | | | | | | | | | | | | | | | | | | | | | | | | | | | | | | | | | | | | | | | | | | | | | | | | | | | | | | | | | | | |
| DEPTH @ BLDG | | | | | | | | | | | | | | | | | | | | | | | | | | | | | | | | | | | | | | | | | | | | | | | | | | | | | | | | | | | | | | | | | | | | | |
| <p>● UP7</p> <p>PUBLIC</p> <p>Curb Stop To: Corp Stop to: UP6 = 14.6m UP6 = 17.7m UP7 = 18.8m UP7 = 11.5m - Stm End to: UP6 = 20.7m UP7 = 29.3m</p> <p>MHT125 MHT125 Merlot Court CULDESAC FH110</p> <p>8.0m</p> <p>Storm Sanitary Water</p> <p>● UP6</p> | | <p>PRIVATE</p> <p>97</p> <p>98</p> <p>SEE BACK FOR ADDITIONAL NOTES →</p> | |

|  | HALIFAX WATER SERVICE LATERAL INFORMATION SHEET | Street <u>Merlot Court</u> Lot <u>99</u> Civic _____ | SLID# _____ | |
|---|
| <table border="1" style="width:100%; border-collapse: collapse;"> <thead> <tr> <th style="width:15%;"></th> <th style="width:25%;">Water</th> <th style="width:25%;">Sanitary</th> <th style="width:35%;">Storm</th> </tr> </thead> <tbody> <tr> <td>LENGTH</td> <td>13.55m</td> <td>16.60m</td> <td>18.57m</td> </tr> <tr> <td>MATERIAL</td> <td>Polyethylene</td> <td>PVC DR28</td> <td>PVC DR35</td> </tr> <tr> <td>SIZE</td> <td>25mm</td> <td>125mm</td> <td>125mm</td> </tr> <tr> <td>COLOUR</td> <td>Blue</td> <td>White</td> <td>Green</td> </tr> <tr> <td>DEPTH @ MAIN</td> <td>2.1m</td> <td>3.0m</td> <td>3.1m</td> </tr> <tr> <td>DEPTH @ ST. LINE</td> <td>1.8m</td> <td>2.2m</td> <td>2.3m</td> </tr> <tr> <td>ELEV @ MAIN</td> <td>96.68</td> <td>95.42</td> <td>95.37</td> </tr> <tr> <td>ELEV @ ST. LINE</td> <td>96.83</td> <td>96.47</td> <td>96.43</td> </tr> <tr> <td>MAIN SIZE</td> <td>200mm</td> <td>200mm</td> <td>300mm</td> </tr> </tbody> </table> <p>Contractor <u>Dexter Construction</u> Inspected By <u>Trevor Carter - GENIVAR inc.</u> Date <u>March 2011</u> Record Dwg. # <u>D09109 - 003 001</u></p> <table style="width:100%;"> <tr> <td>Insulation <input checked="" type="checkbox"/> Yes <input type="checkbox"/> No</td> <td>Rock <input type="checkbox"/> Yes <input type="checkbox"/> No</td> <td>Clay Plug <input type="checkbox"/> Yes <input type="checkbox"/> No</td> <td>Trace Wire <input checked="" type="checkbox"/> Yes <input type="checkbox"/> No</td> <td>Anode <input type="checkbox"/> Yes <input checked="" type="checkbox"/> No</td> </tr> </table> | | Water | Sanitary | Storm | LENGTH | 13.55m | 16.60m | 18.57m | MATERIAL | Polyethylene | PVC DR28 | PVC DR35 | SIZE | 25mm | 125mm | 125mm | COLOUR | Blue | White | Green | DEPTH @ MAIN | 2.1m | 3.0m | 3.1m | DEPTH @ ST. LINE | 1.8m | 2.2m | 2.3m | ELEV @ MAIN | 96.68 | 95.42 | 95.37 | ELEV @ ST. LINE | 96.83 | 96.47 | 96.43 | MAIN SIZE | 200mm | 200mm | 300mm | Insulation <input checked="" type="checkbox"/> Yes <input type="checkbox"/> No | Rock <input type="checkbox"/> Yes <input type="checkbox"/> No | Clay Plug <input type="checkbox"/> Yes <input type="checkbox"/> No | Trace Wire <input checked="" type="checkbox"/> Yes <input type="checkbox"/> No | Anode <input type="checkbox"/> Yes <input checked="" type="checkbox"/> No | <table border="1" style="width:100%; border-collapse: collapse;"> <thead> <tr> <th style="width:15%;"></th> <th style="width:25%;">Water</th> <th style="width:25%;">Sanitary</th> <th style="width:35%;">Storm</th> </tr> </thead> <tbody> <tr><td>LENGTH</td><td></td><td></td><td></td></tr> <tr><td>MATERIAL</td><td></td><td></td><td></td></tr> <tr><td>SIZE</td><td></td><td></td><td></td></tr> <tr><td>COLOUR</td><td></td><td></td><td></td></tr> <tr><td>DEPTH @ ST. LINE</td><td></td><td></td><td></td></tr> <tr><td>DEPTH @ BLDG</td><td></td><td></td><td></td></tr> </tbody> </table> <p>Contractor _____ Inspected By _____ Date _____</p> <p>Sanitary Type: Pressurized <input type="checkbox"/> Gravity <input type="checkbox"/> Private Lift Station Info: Lift: <input type="checkbox"/> Distance <input type="checkbox"/></p> <table style="width:100%;"> <tr> <td>Insulation <input type="checkbox"/> Yes <input type="checkbox"/> No</td> <td>Rock <input type="checkbox"/> Yes <input type="checkbox"/> No</td> <td>Clay Plug <input type="checkbox"/> Yes <input type="checkbox"/> No</td> <td>Foundation Drain Connected <input type="checkbox"/> Yes <input type="checkbox"/> No</td> <td>Rain Leaders Connected <input type="checkbox"/> Yes <input type="checkbox"/> No</td> <td>Trace Wire <input type="checkbox"/> Yes <input type="checkbox"/> No</td> <td>Sound Check <input type="checkbox"/> Yes <input type="checkbox"/> No</td> </tr> </table> | | Water | Sanitary | Storm | LENGTH | | | | MATERIAL | | | | SIZE | | | | COLOUR | | | | DEPTH @ ST. LINE | | | | DEPTH @ BLDG | | | | Insulation <input type="checkbox"/> Yes <input type="checkbox"/> No | Rock <input type="checkbox"/> Yes <input type="checkbox"/> No | Clay Plug <input type="checkbox"/> Yes <input type="checkbox"/> No | Foundation Drain Connected <input type="checkbox"/> Yes <input type="checkbox"/> No | Rain Leaders Connected <input type="checkbox"/> Yes <input type="checkbox"/> No | Trace Wire <input type="checkbox"/> Yes <input type="checkbox"/> No | Sound Check <input type="checkbox"/> Yes <input type="checkbox"/> No |
| | Water | Sanitary | Storm | | | | | | | | | | | | | | | | | | | | | | | | | | | | | | | | | | | | | | | | | | | | | | | | | | | | | | | | | | | | | | | | | | | | | | | | | | | | | | |
| LENGTH | 13.55m | 16.60m | 18.57m | | | | | | | | | | | | | | | | | | | | | | | | | | | | | | | | | | | | | | | | | | | | | | | | | | | | | | | | | | | | | | | | | | | | | | | | | | | | | | |
| MATERIAL | Polyethylene | PVC DR28 | PVC DR35 | |
| SIZE | 25mm | 125mm | 125mm | | | | | | | | | | | | | | | | | | | | | | | | | | | | | | | | | | | | | | | | | | | | | | | | | | | | | | | | | | | | | | | | | | | | | | | | | | | | | | |
| COLOUR | Blue | White | Green | | | | | | | | | | | | | | | | | | | | | | | | | | | | | | | | | | | | | | | | | | | | | | | | | | | | | | | | | | | | | | | | | | | | | | | | | | | | | | |
| DEPTH @ MAIN | 2.1m | 3.0m | 3.1m | | | | | | | | | | | | | | | | | | | | | | | | | | | | | | | | | | | | | | | | | | | | | | | | | | | | | | | | | | | | | | | | | | | | | | | | | | | | | | |
| DEPTH @ ST. LINE | 1.8m | 2.2m | 2.3m | | | | | | | | | | | | | | | | | | | | | | | | | | | | | | | | | | | | | | | | | | | | | | | | | | | | | | | | | | | | | | | | | | | | | | | | | | | | | | |
| ELEV @ MAIN | 96.68 | 95.42 | 95.37 | | | | | | | | | | | | | | | | | | | | | | | | | | | | | | | | | | | | | | | | | | | | | | | | | | | | | | | | | | | | | | | | | | | | | | | | | | | | | | |
| ELEV @ ST. LINE | 96.83 | 96.47 | 96.43 | |
| MAIN SIZE | 200mm | 200mm | 300mm | | | | | | | | | | | | | | | | | | | | | | | | | | | | | | | | | | | | | | | | | | | | | | | | | | | | | | | | | | | | | | | | | | | | | | | | | | | | | | |
| Insulation <input checked="" type="checkbox"/> Yes <input type="checkbox"/> No | Rock <input type="checkbox"/> Yes <input type="checkbox"/> No | Clay Plug <input type="checkbox"/> Yes <input type="checkbox"/> No | Trace Wire <input checked="" type="checkbox"/> Yes <input type="checkbox"/> No | Anode <input type="checkbox"/> Yes <input checked="" type="checkbox"/> No | |
| | Water | Sanitary | Storm | | | | | | | | | | | | | | | | | | | | | | | | | | | | | | | | | | | | | | | | | | | | | | | | | | | | | | | | | | | | | | | | | | | | | | | | | | | | | | |
| LENGTH | | | | | | | | | | | | | | | | | | | | | | | | | | | | | | | | | | | | | | | | | | | | | | | | | | | | | | | | | | | | | | | | | | | | | | | | | | | | | | | | | |
| MATERIAL | | | | | | | | | | | | | | | | | | | | | | | | | | | | | | | | | | | | | | | | | | | | | | | | | | | | | | | | | | | | | | | | | | | | | | | | | | | | | | | | | |
| SIZE | | | | | | | | | | | | | | | | | | | | | | | | | | | | | | | | | | | | | | | | | | | | | | | | | | | | | | | | | | | | | | | | | | | | | | | | | | | | | | | | | |
| COLOUR | | | | | | | | | | | | | | | | | | | | | | | | | | | | | | | | | | | | | | | | | | | | | | | | | | | | | | | | | | | | | | | | | | | | | | | | | | | | | | | | | |
| DEPTH @ ST. LINE | | | | | | | | | | | | | | | | | | | | | | | | | | | | | | | | | | | | | | | | | | | | | | | | | | | | | | | | | | | | | | | | | | | | | | | | | | | | | | | | | |
| DEPTH @ BLDG | | | | | | | | | | | | | | | | | | | | | | | | | | | | | | | | | | | | | | | | | | | | | | | | | | | | | | | | | | | | | | | | | | | | | | | | | | | | | | | | | |
| Insulation <input type="checkbox"/> Yes <input type="checkbox"/> No | Rock <input type="checkbox"/> Yes <input type="checkbox"/> No | Clay Plug <input type="checkbox"/> Yes <input type="checkbox"/> No | Foundation Drain Connected <input type="checkbox"/> Yes <input type="checkbox"/> No | Rain Leaders Connected <input type="checkbox"/> Yes <input type="checkbox"/> No | Trace Wire <input type="checkbox"/> Yes <input type="checkbox"/> No | Sound Check <input type="checkbox"/> Yes <input type="checkbox"/> No | |
| <p>UP7</p> <p style="text-align: center;">PUBLIC</p> <p style="text-align: center; font-size: 1.2em;">Merlot Court Culdesac</p>  <p> Curb Stop To: UP6 = 7.2m UP7 = 27.4m Corp Stop To: UP6 = 9.2m UP7 = 18.9m 17.67m </p> <p> Stm End To: UP6 = 8.7m UP7 = 29.3m </p> | <p style="text-align: center;">PRIVATE</p> <p style="text-align: center; font-size: 1.5em;">97</p> <p style="text-align: center; font-size: 1.5em;">98</p> <p style="text-align: center; font-size: 1.5em;">99</p> <p style="text-align: right;">SEE BACK FOR ADDITIONAL NOTES →</p> | |


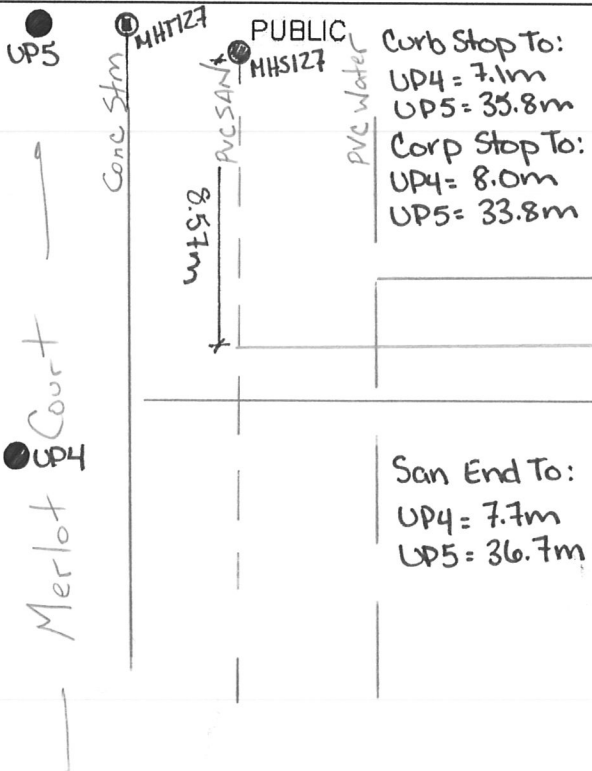
|  | HALIFAX WATER SERVICE LATERAL INFORMATION SHEET | Street <u>Merlot Court</u> Lot <u>100</u> Civic _____ | SID# _____ | |
|---|
| <table border="1" style="width:100%; border-collapse: collapse;"> <thead> <tr> <th colspan="4" style="text-align: center;">PUBLIC</th> </tr> <tr> <th></th> <th style="text-align: center;">Water</th> <th style="text-align: center;">Sanitary</th> <th style="text-align: center;">Storm</th> </tr> </thead> <tbody> <tr> <td>LENGTH</td> <td style="text-align: center;">6.0m</td> <td style="text-align: center;">9.31m</td> <td style="text-align: center;">11.34m</td> </tr> <tr> <td>MATERIAL</td> <td style="text-align: center;">Polyethylene</td> <td style="text-align: center;">PVC DR28</td> <td style="text-align: center;">PVC DR35</td> </tr> <tr> <td>SIZE</td> <td style="text-align: center;">25mm</td> <td style="text-align: center;">125mm</td> <td style="text-align: center;">125mm</td> </tr> <tr> <td>COLOUR</td> <td style="text-align: center;">Blue</td> <td style="text-align: center;">White</td> <td style="text-align: center;">Green</td> </tr> <tr> <td>DEPTH @ MAIN</td> <td style="text-align: center;">1.9m</td> <td style="text-align: center;">3.0m</td> <td style="text-align: center;">3.0m</td> </tr> <tr> <td>DEPTH @ ST. LINE</td> <td style="text-align: center;">1.8m</td> <td style="text-align: center;">2.4m</td> <td style="text-align: center;">2.4m</td> </tr> <tr> <td>ELEV @ MAIN</td> <td style="text-align: center;">95.41</td> <td style="text-align: center;">94.35</td> <td style="text-align: center;">94.28</td> </tr> <tr> <td>ELEV @ ST. LINE</td> <td style="text-align: center;">95.77</td> <td style="text-align: center;">95.20</td> <td style="text-align: center;">95.19</td> </tr> <tr> <td>MAIN SIZE</td> <td style="text-align: center;">200mm</td> <td style="text-align: center;">200mm</td> <td style="text-align: center;">300mm</td> </tr> </tbody> </table> <p>Contractor <u>Dexter Construction</u> Inspected By <u>Trevor Carter - GENIVAR Inc.</u> Date <u>March 2011</u> Record Dwg. # <u>D09109-003 001</u></p> <table style="width:100%;"> <tr> <td>Insulation</td> <td><input checked="" type="checkbox"/> Yes</td> <td><input type="checkbox"/> No</td> </tr> <tr> <td>Rock</td> <td><input type="checkbox"/> Yes</td> <td><input type="checkbox"/> No</td> </tr> <tr> <td>Clay Plug</td> <td><input type="checkbox"/> Yes</td> <td><input type="checkbox"/> No</td> </tr> <tr> <td>Trace Wire</td> <td><input checked="" type="checkbox"/> Yes</td> <td><input type="checkbox"/> No</td> </tr> <tr> <td>Anode</td> <td><input type="checkbox"/> Yes</td> <td><input checked="" type="checkbox"/> No</td> </tr> </table> | PUBLIC | | | | | Water | Sanitary | Storm | LENGTH | 6.0m | 9.31m | 11.34m | MATERIAL | Polyethylene | PVC DR28 | PVC DR35 | SIZE | 25mm | 125mm | 125mm | COLOUR | Blue | White | Green | DEPTH @ MAIN | 1.9m | 3.0m | 3.0m | DEPTH @ ST. LINE | 1.8m | 2.4m | 2.4m | ELEV @ MAIN | 95.41 | 94.35 | 94.28 | ELEV @ ST. LINE | 95.77 | 95.20 | 95.19 | MAIN SIZE | 200mm | 200mm | 300mm | Insulation | <input checked="" type="checkbox"/> Yes | <input type="checkbox"/> No | Rock | <input type="checkbox"/> Yes | <input type="checkbox"/> No | Clay Plug | <input type="checkbox"/> Yes | <input type="checkbox"/> No | Trace Wire | <input checked="" type="checkbox"/> Yes | <input type="checkbox"/> No | Anode | <input type="checkbox"/> Yes | <input checked="" type="checkbox"/> No | <table border="1" style="width:100%; border-collapse: collapse;"> <thead> <tr> <th colspan="4" style="text-align: center;">PRIVATE</th> </tr> <tr> <th></th> <th style="text-align: center;">Water</th> <th style="text-align: center;">Sanitary</th> <th style="text-align: center;">Storm</th> </tr> </thead> <tbody> <tr><td>LENGTH</td><td></td><td></td><td></td></tr> <tr><td>MATERIAL</td><td></td><td></td><td></td></tr> <tr><td>SIZE</td><td></td><td></td><td></td></tr> <tr><td>COLOUR</td><td></td><td></td><td></td></tr> <tr><td>DEPTH @ ST. LINE</td><td></td><td></td><td></td></tr> <tr><td>DEPTH @ BLDG</td><td></td><td></td><td></td></tr> </tbody> </table> <p>Contractor _____ Inspected By _____ Date _____</p> <p>Sanitary Type Pressurized <input type="checkbox"/> Gravity <input type="checkbox"/> Private Lift Lift: <input type="checkbox"/> Distance <input type="checkbox"/></p> <table style="width:100%;"> <tr> <td>Insulation</td> <td><input type="checkbox"/> Yes</td> <td><input type="checkbox"/> No</td> </tr> <tr> <td>Rock</td> <td><input type="checkbox"/> Yes</td> <td><input type="checkbox"/> No</td> </tr> <tr> <td>Clay Plug</td> <td><input type="checkbox"/> Yes</td> <td><input type="checkbox"/> No</td> </tr> <tr> <td>Foundation Drain Connected</td> <td><input type="checkbox"/> Yes</td> <td><input type="checkbox"/> No</td> </tr> <tr> <td>Rain Leaders Connected</td> <td><input type="checkbox"/> Yes</td> <td><input type="checkbox"/> No</td> </tr> <tr> <td>Trace Wire</td> <td><input type="checkbox"/> Yes</td> <td><input type="checkbox"/> No</td> </tr> <tr> <td>Sound Check</td> <td><input type="checkbox"/> Yes</td> <td><input type="checkbox"/> No</td> </tr> </table> | PRIVATE | | | | | Water | Sanitary | Storm | LENGTH | | | | MATERIAL | | | | SIZE | | | | COLOUR | | | | DEPTH @ ST. LINE | | | | DEPTH @ BLDG | | | | Insulation | <input type="checkbox"/> Yes | <input type="checkbox"/> No | Rock | <input type="checkbox"/> Yes | <input type="checkbox"/> No | Clay Plug | <input type="checkbox"/> Yes | <input type="checkbox"/> No | Foundation Drain Connected | <input type="checkbox"/> Yes | <input type="checkbox"/> No | Rain Leaders Connected | <input type="checkbox"/> Yes | <input type="checkbox"/> No | Trace Wire | <input type="checkbox"/> Yes | <input type="checkbox"/> No | Sound Check | <input type="checkbox"/> Yes | <input type="checkbox"/> No |
| PUBLIC | |
| | Water | Sanitary | Storm | |
| LENGTH | 6.0m | 9.31m | 11.34m | |
| MATERIAL | Polyethylene | PVC DR28 | PVC DR35 | |
| SIZE | 25mm | 125mm | 125mm | |
| COLOUR | Blue | White | Green | |
| DEPTH @ MAIN | 1.9m | 3.0m | 3.0m | |
| DEPTH @ ST. LINE | 1.8m | 2.4m | 2.4m | |
| ELEV @ MAIN | 95.41 | 94.35 | 94.28 | |
| ELEV @ ST. LINE | 95.77 | 95.20 | 95.19 | |
| MAIN SIZE | 200mm | 200mm | 300mm | |
| Insulation | <input checked="" type="checkbox"/> Yes | <input type="checkbox"/> No | |
| Rock | <input type="checkbox"/> Yes | <input type="checkbox"/> No | |
| Clay Plug | <input type="checkbox"/> Yes | <input type="checkbox"/> No | |
| Trace Wire | <input checked="" type="checkbox"/> Yes | <input type="checkbox"/> No | |
| Anode | <input type="checkbox"/> Yes | <input checked="" type="checkbox"/> No | |
| PRIVATE | |
| | Water | Sanitary | Storm | |
| LENGTH | |
| MATERIAL | |
| SIZE | |
| COLOUR | |
| DEPTH @ ST. LINE | |
| DEPTH @ BLDG | |
| Insulation | <input type="checkbox"/> Yes | <input type="checkbox"/> No | |
| Rock | <input type="checkbox"/> Yes | <input type="checkbox"/> No | |
| Clay Plug | <input type="checkbox"/> Yes | <input type="checkbox"/> No | |
| Foundation Drain Connected | <input type="checkbox"/> Yes | <input type="checkbox"/> No | |
| Rain Leaders Connected | <input type="checkbox"/> Yes | <input type="checkbox"/> No | |
| Trace Wire | <input type="checkbox"/> Yes | <input type="checkbox"/> No | |
| Sound Check | <input type="checkbox"/> Yes | <input type="checkbox"/> No | |
| <p>Curb Stop To: UP5 = 32.8m UP6 = 11.5m</p> <p>Corp Stop To: UP5 = 32.4m UP6 = 13.0m</p> <p>Stm End To: UP5 = 32.9m UP6 = 12.0m</p> <p style="text-align: center;">13.59m</p>  | <p>PUBLIC</p> <p>PRIVATE</p> <p>99</p> <p>100</p> <p>101</p> <p style="text-align: right;">SEE BACK FOR ADDITIONAL NOTES →</p> | |

| HALIFAX WATER SERVICE LATERAL INFORMATION SHEET | | Street <u>Merlot Court</u> Lot <u>101</u> Civic _____ | |
|---|
| | | SLID# _____ | | | | | | | | | | | | | | | | | | | | | | | | | | | | | | | | | | | | | | | | | | | | | | | | | | | | | | | | | | | | | | | | | | | |
| <p>PUBLIC</p> <table border="1" style="width:100%; border-collapse: collapse;"> <thead> <tr> <th></th> <th>Water</th> <th>Sanitary</th> <th>Storm</th> </tr> </thead> <tbody> <tr> <td>LENGTH</td> <td>5.18m</td> <td>8.73m</td> <td>11.13m</td> </tr> <tr> <td>MATERIAL</td> <td>Polyethylene</td> <td>PVC DR28</td> <td>PVC DR35</td> </tr> <tr> <td>SIZE</td> <td>25mm</td> <td>125mm</td> <td>125mm</td> </tr> <tr> <td>COLOUR</td> <td>Blue</td> <td>White</td> <td>Green</td> </tr> <tr> <td>DEPTH @ MAIN</td> <td>1.8m</td> <td>2.8m</td> <td>2.9m</td> </tr> <tr> <td>DEPTH @ ST. LINE</td> <td>1.7m</td> <td>2.3m</td> <td>2.4m</td> </tr> <tr> <td>ELEV @ MAIN</td> <td>94.38</td> <td>93.38</td> <td>93.29</td> </tr> <tr> <td>ELEV @ ST. LINE</td> <td>94.74</td> <td>94.20</td> <td>94.19</td> </tr> <tr> <td>MAIN SIZE</td> <td>200mm</td> <td>200mm</td> <td>300mm</td> </tr> </tbody> </table> <p>Contractor <u>Dexter Construction</u> Inspected By <u>Trevor Carter - GENIVAR Inc.</u> Date <u>March 2011</u> Record Dwg. # <u>089109-003 001</u></p> <p> <input checked="" type="checkbox"/> Insulation Yes <input type="checkbox"/> No <input type="checkbox"/> Rock Yes <input type="checkbox"/> No <input type="checkbox"/> Clay Plug Yes <input type="checkbox"/> No <input checked="" type="checkbox"/> Trace Wire Yes <input type="checkbox"/> No <input type="checkbox"/> Anode Yes <input checked="" type="checkbox"/> No </p> | | Water | Sanitary | Storm | LENGTH | 5.18m | 8.73m | 11.13m | MATERIAL | Polyethylene | PVC DR28 | PVC DR35 | SIZE | 25mm | 125mm | 125mm | COLOUR | Blue | White | Green | DEPTH @ MAIN | 1.8m | 2.8m | 2.9m | DEPTH @ ST. LINE | 1.7m | 2.3m | 2.4m | ELEV @ MAIN | 94.38 | 93.38 | 93.29 | ELEV @ ST. LINE | 94.74 | 94.20 | 94.19 | MAIN SIZE | 200mm | 200mm | 300mm | <p>PRIVATE</p> <table border="1" style="width:100%; border-collapse: collapse;"> <thead> <tr> <th></th> <th>Water</th> <th>Sanitary</th> <th>Storm</th> </tr> </thead> <tbody> <tr> <td>LENGTH</td> <td></td> <td></td> <td></td> </tr> <tr> <td>MATERIAL</td> <td></td> <td></td> <td></td> </tr> <tr> <td>SIZE</td> <td></td> <td></td> <td></td> </tr> <tr> <td>COLOUR</td> <td></td> <td></td> <td></td> </tr> <tr> <td>DEPTH @ ST. LINE</td> <td></td> <td></td> <td></td> </tr> <tr> <td>DEPTH @ BLDG</td> <td></td> <td></td> <td></td> </tr> </tbody> </table> <p>Contractor _____ Inspected By _____ Date _____</p> <p>Sanitary Type: Pressurized <input type="checkbox"/> Gravity <input type="checkbox"/> Private Lift Station Info: Lift: <input type="checkbox"/> Distance <input type="checkbox"/></p> <p> <input type="checkbox"/> Insulation Yes <input type="checkbox"/> No <input type="checkbox"/> Rock Yes <input type="checkbox"/> No <input type="checkbox"/> Clay Plug Yes <input type="checkbox"/> No <input type="checkbox"/> Foundation Drain Connected Yes <input type="checkbox"/> No <input type="checkbox"/> Rain Leaders Connected Yes <input type="checkbox"/> No <input type="checkbox"/> Trace Wire Yes <input type="checkbox"/> No <input type="checkbox"/> Sound Check Yes <input type="checkbox"/> No </p> | | Water | Sanitary | Storm | LENGTH | | | | MATERIAL | | | | SIZE | | | | COLOUR | | | | DEPTH @ ST. LINE | | | | DEPTH @ BLDG | | | |
| | Water | Sanitary | Storm | | | | | | | | | | | | | | | | | | | | | | | | | | | | | | | | | | | | | | | | | | | | | | | | | | | | | | | | | | | | | | | | | | |
| LENGTH | 5.18m | 8.73m | 11.13m | | | | | | | | | | | | | | | | | | | | | | | | | | | | | | | | | | | | | | | | | | | | | | | | | | | | | | | | | | | | | | | | | | |
| MATERIAL | Polyethylene | PVC DR28 | PVC DR35 | | | | | | | | | | | | | | | | | | | | | | | | | | | | | | | | | | | | | | | | | | | | | | | | | | | | | | | | | | | | | | | | | | |
| SIZE | 25mm | 125mm | 125mm | | | | | | | | | | | | | | | | | | | | | | | | | | | | | | | | | | | | | | | | | | | | | | | | | | | | | | | | | | | | | | | | | | |
| COLOUR | Blue | White | Green | | | | | | | | | | | | | | | | | | | | | | | | | | | | | | | | | | | | | | | | | | | | | | | | | | | | | | | | | | | | | | | | | | |
| DEPTH @ MAIN | 1.8m | 2.8m | 2.9m | | | | | | | | | | | | | | | | | | | | | | | | | | | | | | | | | | | | | | | | | | | | | | | | | | | | | | | | | | | | | | | | | | |
| DEPTH @ ST. LINE | 1.7m | 2.3m | 2.4m | | | | | | | | | | | | | | | | | | | | | | | | | | | | | | | | | | | | | | | | | | | | | | | | | | | | | | | | | | | | | | | | | | |
| ELEV @ MAIN | 94.38 | 93.38 | 93.29 | | | | | | | | | | | | | | | | | | | | | | | | | | | | | | | | | | | | | | | | | | | | | | | | | | | | | | | | | | | | | | | | | | |
| ELEV @ ST. LINE | 94.74 | 94.20 | 94.19 | | | | | | | | | | | | | | | | | | | | | | | | | | | | | | | | | | | | | | | | | | | | | | | | | | | | | | | | | | | | | | | | | | |
| MAIN SIZE | 200mm | 200mm | 300mm | | | | | | | | | | | | | | | | | | | | | | | | | | | | | | | | | | | | | | | | | | | | | | | | | | | | | | | | | | | | | | | | | | |
| | Water | Sanitary | Storm | | | | | | | | | | | | | | | | | | | | | | | | | | | | | | | | | | | | | | | | | | | | | | | | | | | | | | | | | | | | | | | | | | |
| LENGTH | | | | | | | | | | | | | | | | | | | | | | | | | | | | | | | | | | | | | | | | | | | | | | | | | | | | | | | | | | | | | | | | | | | | | |
| MATERIAL | | | | | | | | | | | | | | | | | | | | | | | | | | | | | | | | | | | | | | | | | | | | | | | | | | | | | | | | | | | | | | | | | | | | | |
| SIZE | | | | | | | | | | | | | | | | | | | | | | | | | | | | | | | | | | | | | | | | | | | | | | | | | | | | | | | | | | | | | | | | | | | | | |
| COLOUR | | | | | | | | | | | | | | | | | | | | | | | | | | | | | | | | | | | | | | | | | | | | | | | | | | | | | | | | | | | | | | | | | | | | | |
| DEPTH @ ST. LINE | | | | | | | | | | | | | | | | | | | | | | | | | | | | | | | | | | | | | | | | | | | | | | | | | | | | | | | | | | | | | | | | | | | | | |
| DEPTH @ BLDG | | | | | | | | | | | | | | | | | | | | | | | | | | | | | | | | | | | | | | | | | | | | | | | | | | | | | | | | | | | | | | | | | | | | | |
| <p> Curb Stop To: UP5 = 20.4m UP6 = 24.3m Corp Stop To: UP5 = 19.8m UP6 = 24.6m Stm End To: UP5 = 20.8m UP6 = 24.9m </p> | <p>PRIVATE</p> <p>100</p> <p>101</p> <p>102</p> <p style="text-align: right;">SEE BACK FOR ADDITIONAL NOTES →</p> | |

|  | HALIFAX WATER SERVICE LATERAL INFORMATION SHEET | Street <u>Merlot Court</u> Lot <u>102</u> Civic _____ | SLID# _____ | |
|---|
| <p>PUBLIC</p> <table border="1" style="width:100%; border-collapse: collapse;"> <thead> <tr> <th></th> <th>Water</th> <th>Sanitary</th> <th>Storm</th> </tr> </thead> <tbody> <tr> <td>LENGTH</td> <td>6.98m</td> <td>10.51m</td> <td>12.46m</td> </tr> <tr> <td>MATERIAL</td> <td>Polyethylene</td> <td>PVC DR28</td> <td>PVC DR35</td> </tr> <tr> <td>SIZE</td> <td>25mm</td> <td>125mm</td> <td>125mm</td> </tr> <tr> <td>COLOUR</td> <td>Blue</td> <td>White</td> <td>Green</td> </tr> <tr> <td>DEPTH @ MAIN</td> <td>1.7m</td> <td>2.8m</td> <td>2.9m</td> </tr> <tr> <td>DEPTH @ ST. LINE</td> <td>1.7m</td> <td>2.4m</td> <td>2.4m</td> </tr> <tr> <td>ELEV @ MAIN</td> <td>93.36</td> <td>92.31</td> <td>92.17</td> </tr> <tr> <td>ELEV @ ST. LINE</td> <td>93.60</td> <td>92.82</td> <td>92.81</td> </tr> <tr> <td>MAIN SIZE</td> <td>200 mm</td> <td>200 mm</td> <td>450 mm</td> </tr> </tbody> </table> <p>Contractor <u>Dexter Construction</u> Inspected By <u>Trevor Carter - GENIVAR Inc.</u> Date <u>March 2011</u> Record Dwg. # <u>009109-003 001</u></p> <p> <input checked="" type="checkbox"/> Insulation Yes <input type="checkbox"/> No <input type="checkbox"/> Rock Yes <input type="checkbox"/> No <input type="checkbox"/> Clay Plug Yes <input type="checkbox"/> No <input checked="" type="checkbox"/> Trace Wire Yes <input type="checkbox"/> No <input type="checkbox"/> Anode Yes <input checked="" type="checkbox"/> No </p> | | Water | Sanitary | Storm | LENGTH | 6.98m | 10.51m | 12.46m | MATERIAL | Polyethylene | PVC DR28 | PVC DR35 | SIZE | 25mm | 125mm | 125mm | COLOUR | Blue | White | Green | DEPTH @ MAIN | 1.7m | 2.8m | 2.9m | DEPTH @ ST. LINE | 1.7m | 2.4m | 2.4m | ELEV @ MAIN | 93.36 | 92.31 | 92.17 | ELEV @ ST. LINE | 93.60 | 92.82 | 92.81 | MAIN SIZE | 200 mm | 200 mm | 450 mm | <p>PRIVATE</p> <table border="1" style="width:100%; border-collapse: collapse;"> <thead> <tr> <th></th> <th>Water</th> <th>Sanitary</th> <th>Storm</th> </tr> </thead> <tbody> <tr> <td>LENGTH</td> <td></td> <td></td> <td></td> </tr> <tr> <td>MATERIAL</td> <td></td> <td></td> <td></td> </tr> <tr> <td>SIZE</td> <td></td> <td></td> <td></td> </tr> <tr> <td>COLOUR</td> <td></td> <td></td> <td></td> </tr> <tr> <td>DEPTH @ ST. LINE</td> <td></td> <td></td> <td></td> </tr> <tr> <td>DEPTH @ BLDG</td> <td></td> <td></td> <td></td> </tr> </tbody> </table> <p> Contractor _____ Inspected By _____ Date _____ </p> <p> Sanitary Type Pressurized <input type="checkbox"/> <input type="checkbox"/> Gravity Private Lift Lift: <input type="checkbox"/> <input type="checkbox"/> Distance </p> <p> <input type="checkbox"/> Insulation Yes <input type="checkbox"/> No <input type="checkbox"/> Rock Yes <input type="checkbox"/> No <input type="checkbox"/> Clay Plug Yes <input type="checkbox"/> No <input type="checkbox"/> Foundation Drain Connected Yes <input type="checkbox"/> No <input type="checkbox"/> Rain Leaders Connected Yes <input type="checkbox"/> No <input type="checkbox"/> Trace Wire Yes <input type="checkbox"/> No <input type="checkbox"/> Sound Check Yes <input type="checkbox"/> No </p> | | Water | Sanitary | Storm | LENGTH | | | | MATERIAL | | | | SIZE | | | | COLOUR | | | | DEPTH @ ST. LINE | | | | DEPTH @ BLDG | | | |
| | Water | Sanitary | Storm | | | | | | | | | | | | | | | | | | | | | | | | | | | | | | | | | | | | | | | | | | | | | | | | | | | | | | | | | | | | | | | | | | |
| LENGTH | 6.98m | 10.51m | 12.46m | | | | | | | | | | | | | | | | | | | | | | | | | | | | | | | | | | | | | | | | | | | | | | | | | | | | | | | | | | | | | | | | | | |
| MATERIAL | Polyethylene | PVC DR28 | PVC DR35 | | | | | | | | | | | | | | | | | | | | | | | | | | | | | | | | | | | | | | | | | | | | | | | | | | | | | | | | | | | | | | | | | | |
| SIZE | 25mm | 125mm | 125mm | | | | | | | | | | | | | | | | | | | | | | | | | | | | | | | | | | | | | | | | | | | | | | | | | | | | | | | | | | | | | | | | | | |
| COLOUR | Blue | White | Green | | | | | | | | | | | | | | | | | | | | | | | | | | | | | | | | | | | | | | | | | | | | | | | | | | | | | | | | | | | | | | | | | | |
| DEPTH @ MAIN | 1.7m | 2.8m | 2.9m | | | | | | | | | | | | | | | | | | | | | | | | | | | | | | | | | | | | | | | | | | | | | | | | | | | | | | | | | | | | | | | | | | |
| DEPTH @ ST. LINE | 1.7m | 2.4m | 2.4m | | | | | | | | | | | | | | | | | | | | | | | | | | | | | | | | | | | | | | | | | | | | | | | | | | | | | | | | | | | | | | | | | | |
| ELEV @ MAIN | 93.36 | 92.31 | 92.17 | | | | | | | | | | | | | | | | | | | | | | | | | | | | | | | | | | | | | | | | | | | | | | | | | | | | | | | | | | | | | | | | | | |
| ELEV @ ST. LINE | 93.60 | 92.82 | 92.81 | | | | | | | | | | | | | | | | | | | | | | | | | | | | | | | | | | | | | | | | | | | | | | | | | | | | | | | | | | | | | | | | | | |
| MAIN SIZE | 200 mm | 200 mm | 450 mm | | | | | | | | | | | | | | | | | | | | | | | | | | | | | | | | | | | | | | | | | | | | | | | | | | | | | | | | | | | | | | | | | | |
| | Water | Sanitary | Storm | | | | | | | | | | | | | | | | | | | | | | | | | | | | | | | | | | | | | | | | | | | | | | | | | | | | | | | | | | | | | | | | | | |
| LENGTH | | | | | | | | | | | | | | | | | | | | | | | | | | | | | | | | | | | | | | | | | | | | | | | | | | | | | | | | | | | | | | | | | | | | | |
| MATERIAL | | | | | | | | | | | | | | | | | | | | | | | | | | | | | | | | | | | | | | | | | | | | | | | | | | | | | | | | | | | | | | | | | | | | | |
| SIZE | | | | | | | | | | | | | | | | | | | | | | | | | | | | | | | | | | | | | | | | | | | | | | | | | | | | | | | | | | | | | | | | | | | | | |
| COLOUR | | | | | | | | | | | | | | | | | | | | | | | | | | | | | | | | | | | | | | | | | | | | | | | | | | | | | | | | | | | | | | | | | | | | | |
| DEPTH @ ST. LINE | | | | | | | | | | | | | | | | | | | | | | | | | | | | | | | | | | | | | | | | | | | | | | | | | | | | | | | | | | | | | | | | | | | | | |
| DEPTH @ BLDG | | | | | | | | | | | | | | | | | | | | | | | | | | | | | | | | | | | | | | | | | | | | | | | | | | | | | | | | | | | | | | | | | | | | | |
|  <p style="text-align: center;">PUBLIC</p> <p style="text-align: center;">UP6</p> <p style="text-align: center;">UP5</p> <p style="text-align: center;">Storm</p> <p style="text-align: center;">Sanitary</p> <p style="text-align: center;">Water</p> | | <p> PRIVATE Corp Stop To: UP5 = 6.4m UP6 = 38.9m </p> <p> 101 Corp Stop To: UP5 = 8.1m UP6 = 37.0m </p> <p> San End To: UP5 = 7.1m UP6 = 39.8m </p> <p style="text-align: center;">102</p> <p style="text-align: center;">103</p> | |
| SEE BACK FOR ADDITIONAL NOTES → | | | | | | | | | | | | | | | | | | | | | | | | | | | | | | | | | | | | | | | | | | | | | | | | | | | | | | | | | | | | | | | | | | | | | |

| HALIFAX WATER SERVICE LATERAL INFORMATION SHEET | | Street <u>Merlot Court</u> Lot <u>103</u> Civic _____ | |
|---|
| | | SLID# _____ | | | | | | | | | | | | | | | | | | | | | | | | | | | | | | | | | | | | | | | | | | | | | | | | | | | | | | | | | | | | | | | | | | | | | | | | | | | | | | | | | |
| <p>PUBLIC</p> <table border="1" style="width:100%; border-collapse: collapse;"> <thead> <tr> <th></th> <th>Water</th> <th>Sanitary</th> <th>Storm</th> </tr> </thead> <tbody> <tr> <td>LENGTH</td> <td><u>7.5m</u></td> <td><u>10.3m</u></td> <td><u>12.0m</u></td> </tr> <tr> <td>MATERIAL</td> <td><u>Polyethylene</u></td> <td><u>PVC DR28</u></td> <td><u>PVC DR35</u></td> </tr> <tr> <td>SIZE</td> <td><u>25mm</u></td> <td><u>125mm</u></td> <td><u>125mm</u></td> </tr> <tr> <td>COLOUR</td> <td><u>Blue</u></td> <td><u>White</u></td> <td><u>Green</u></td> </tr> <tr> <td>DEPTH @ MAIN</td> <td><u>1.65m</u></td> <td><u>2.56m</u></td> <td><u>2.72m</u></td> </tr> <tr> <td>DEPTH @ ST. LINE</td> <td><u>1.69m</u></td> <td><u>2.60m</u></td> <td><u>2.60m</u></td> </tr> <tr> <td>ELEV @ MAIN</td> <td><u>92.02</u></td> <td><u>91.08</u></td> <td><u>90.92</u></td> </tr> <tr> <td>ELEV @ ST. LINE</td> <td><u>92.21</u></td> <td><u>91.30</u></td> <td><u>91.30</u></td> </tr> <tr> <td>MAIN SIZE</td> <td><u>200mm</u></td> <td><u>200mm</u></td> <td><u>450mm</u></td> </tr> </tbody> </table> <p>Contractor <u>Dexter Construction</u> Inspected By <u>Trevor Carter - GENIVAR inc.</u> Date <u>March 2011</u> Record Dwg. # <u>D09109-003 001</u></p> <table style="width:100%;"> <tr> <td>Insulation <input checked="" type="checkbox"/> Yes <input type="checkbox"/> No</td> <td>Rock <input type="checkbox"/> Yes <input type="checkbox"/> No</td> </tr> <tr> <td>Clay Plug <input type="checkbox"/> Yes <input type="checkbox"/> No</td> <td>Trace Wire <input checked="" type="checkbox"/> Yes <input type="checkbox"/> No</td> </tr> <tr> <td>Anode <input type="checkbox"/> Yes <input checked="" type="checkbox"/> No</td> <td></td> </tr> </table> | | Water | Sanitary | Storm | LENGTH | <u>7.5m</u> | <u>10.3m</u> | <u>12.0m</u> | MATERIAL | <u>Polyethylene</u> | <u>PVC DR28</u> | <u>PVC DR35</u> | SIZE | <u>25mm</u> | <u>125mm</u> | <u>125mm</u> | COLOUR | <u>Blue</u> | <u>White</u> | <u>Green</u> | DEPTH @ MAIN | <u>1.65m</u> | <u>2.56m</u> | <u>2.72m</u> | DEPTH @ ST. LINE | <u>1.69m</u> | <u>2.60m</u> | <u>2.60m</u> | ELEV @ MAIN | <u>92.02</u> | <u>91.08</u> | <u>90.92</u> | ELEV @ ST. LINE | <u>92.21</u> | <u>91.30</u> | <u>91.30</u> | MAIN SIZE | <u>200mm</u> | <u>200mm</u> | <u>450mm</u> | Insulation <input checked="" type="checkbox"/> Yes <input type="checkbox"/> No | Rock <input type="checkbox"/> Yes <input type="checkbox"/> No | Clay Plug <input type="checkbox"/> Yes <input type="checkbox"/> No | Trace Wire <input checked="" type="checkbox"/> Yes <input type="checkbox"/> No | Anode <input type="checkbox"/> Yes <input checked="" type="checkbox"/> No | | <p>PRIVATE</p> <table border="1" style="width:100%; border-collapse: collapse;"> <thead> <tr> <th></th> <th>Water</th> <th>Sanitary</th> <th>Storm</th> </tr> </thead> <tbody> <tr><td>LENGTH</td><td></td><td></td><td></td></tr> <tr><td>MATERIAL</td><td></td><td></td><td></td></tr> <tr><td>SIZE</td><td></td><td></td><td></td></tr> <tr><td>COLOUR</td><td></td><td></td><td></td></tr> <tr><td>DEPTH @ ST. LINE</td><td></td><td></td><td></td></tr> <tr><td>DEPTH @ BLDG</td><td></td><td></td><td></td></tr> </tbody> </table> <p>Contractor _____ Inspected By _____ Date _____</p> <p>Sanitary Type Pressurized <input type="checkbox"/> Gravity <input type="checkbox"/> Private Lift Lift: <input type="checkbox"/> Distance <input type="checkbox"/> Station Info.</p> <table style="width:100%;"> <tr> <td>Insulation <input type="checkbox"/> Yes <input type="checkbox"/> No</td> <td>Rock <input type="checkbox"/> Yes <input type="checkbox"/> No</td> </tr> <tr> <td>Clay Plug <input type="checkbox"/> Yes <input type="checkbox"/> No</td> <td>Foundation Drain Connected <input type="checkbox"/> Yes <input type="checkbox"/> No</td> </tr> <tr> <td>Rain Leaders Connected <input type="checkbox"/> Yes <input type="checkbox"/> No</td> <td>Trace Wire <input type="checkbox"/> Yes <input type="checkbox"/> No</td> </tr> <tr> <td>Sound Check <input type="checkbox"/> Yes <input type="checkbox"/> No</td> <td></td> </tr> </table> | | Water | Sanitary | Storm | LENGTH | | | | MATERIAL | | | | SIZE | | | | COLOUR | | | | DEPTH @ ST. LINE | | | | DEPTH @ BLDG | | | | Insulation <input type="checkbox"/> Yes <input type="checkbox"/> No | Rock <input type="checkbox"/> Yes <input type="checkbox"/> No | Clay Plug <input type="checkbox"/> Yes <input type="checkbox"/> No | Foundation Drain Connected <input type="checkbox"/> Yes <input type="checkbox"/> No | Rain Leaders Connected <input type="checkbox"/> Yes <input type="checkbox"/> No | Trace Wire <input type="checkbox"/> Yes <input type="checkbox"/> No | Sound Check <input type="checkbox"/> Yes <input type="checkbox"/> No | |
| | Water | Sanitary | Storm | | | | | | | | | | | | | | | | | | | | | | | | | | | | | | | | | | | | | | | | | | | | | | | | | | | | | | | | | | | | | | | | | | | | | | | | | | | | | | | | |
| LENGTH | <u>7.5m</u> | <u>10.3m</u> | <u>12.0m</u> | |
| MATERIAL | <u>Polyethylene</u> | <u>PVC DR28</u> | <u>PVC DR35</u> | |
| SIZE | <u>25mm</u> | <u>125mm</u> | <u>125mm</u> | |
| COLOUR | <u>Blue</u> | <u>White</u> | <u>Green</u> | |
| DEPTH @ MAIN | <u>1.65m</u> | <u>2.56m</u> | <u>2.72m</u> | |
| DEPTH @ ST. LINE | <u>1.69m</u> | <u>2.60m</u> | <u>2.60m</u> | |
| ELEV @ MAIN | <u>92.02</u> | <u>91.08</u> | <u>90.92</u> | |
| ELEV @ ST. LINE | <u>92.21</u> | <u>91.30</u> | <u>91.30</u> | |
| MAIN SIZE | <u>200mm</u> | <u>200mm</u> | <u>450mm</u> | |
| Insulation <input checked="" type="checkbox"/> Yes <input type="checkbox"/> No | Rock <input type="checkbox"/> Yes <input type="checkbox"/> No | |
| Clay Plug <input type="checkbox"/> Yes <input type="checkbox"/> No | Trace Wire <input checked="" type="checkbox"/> Yes <input type="checkbox"/> No | |
| Anode <input type="checkbox"/> Yes <input checked="" type="checkbox"/> No | |
| | Water | Sanitary | Storm | | | | | | | | | | | | | | | | | | | | | | | | | | | | | | | | | | | | | | | | | | | | | | | | | | | | | | | | | | | | | | | | | | | | | | | | | | | | | | | | |
| LENGTH | | | | | | | | | | | | | | | | | | | | | | | | | | | | | | | | | | | | | | | | | | | | | | | | | | | | | | | | | | | | | | | | | | | | | | | | | | | | | | | | | | | |
| MATERIAL | | | | | | | | | | | | | | | | | | | | | | | | | | | | | | | | | | | | | | | | | | | | | | | | | | | | | | | | | | | | | | | | | | | | | | | | | | | | | | | | | | | |
| SIZE | | | | | | | | | | | | | | | | | | | | | | | | | | | | | | | | | | | | | | | | | | | | | | | | | | | | | | | | | | | | | | | | | | | | | | | | | | | | | | | | | | | |
| COLOUR | | | | | | | | | | | | | | | | | | | | | | | | | | | | | | | | | | | | | | | | | | | | | | | | | | | | | | | | | | | | | | | | | | | | | | | | | | | | | | | | | | | |
| DEPTH @ ST. LINE | | | | | | | | | | | | | | | | | | | | | | | | | | | | | | | | | | | | | | | | | | | | | | | | | | | | | | | | | | | | | | | | | | | | | | | | | | | | | | | | | | | |
| DEPTH @ BLDG | | | | | | | | | | | | | | | | | | | | | | | | | | | | | | | | | | | | | | | | | | | | | | | | | | | | | | | | | | | | | | | | | | | | | | | | | | | | | | | | | | | |
| Insulation <input type="checkbox"/> Yes <input type="checkbox"/> No | Rock <input type="checkbox"/> Yes <input type="checkbox"/> No | |
| Clay Plug <input type="checkbox"/> Yes <input type="checkbox"/> No | Foundation Drain Connected <input type="checkbox"/> Yes <input type="checkbox"/> No | |
| Rain Leaders Connected <input type="checkbox"/> Yes <input type="checkbox"/> No | Trace Wire <input type="checkbox"/> Yes <input type="checkbox"/> No | |
| Sound Check <input type="checkbox"/> Yes <input type="checkbox"/> No | |
| <p>PUBLIC</p> <p>San End To: UP4 = 34.6m UP5 = 9.3m</p> <p>Corp Stop To: UP4 = 32.8m UP5 = 9.3m</p> <p>Curb Stop To: UP4 = 34.6m UP5 = 8.3m</p> <p>San End To: UP4 = 34.6m UP5 = 9.8m</p> <p>14.9m Pvc SAN Pvc Water</p> | <p>PRIVATE</p> <p>102</p> <p>103</p> <p>104.</p> <p style="text-align: right;">SEE BACK FOR ADDITIONAL NOTES →</p> | |

| HALIFAX WATER SERVICE LATERAL INFORMATION SHEET | | Street <u>Merlot Court</u> Lot <u>104</u> Civic _____ | |
|---|
| | | SLID# _____ | | | | | | | | | | | | | | | | | | | | | | | | | | | | | | | | | | | | | | | | | | | | | | | | | | | | | | | | | | | | | | | | | | | |
| <p>PUBLIC</p> <table border="1" style="width:100%; border-collapse: collapse;"> <thead> <tr> <th></th> <th>Water</th> <th>Sanitary</th> <th>Storm</th> </tr> </thead> <tbody> <tr> <td>LENGTH</td> <td><u>5.8m</u></td> <td><u>8.4m</u></td> <td><u>10.1m</u></td> </tr> <tr> <td>MATERIAL</td> <td><u>Polyethylene</u></td> <td><u>PVC DR28</u></td> <td><u>PVC DR35</u></td> </tr> <tr> <td>SIZE</td> <td><u>25mm</u></td> <td><u>125mm</u></td> <td><u>125mm</u></td> </tr> <tr> <td>COLOUR</td> <td><u>Blue</u></td> <td><u>White</u></td> <td><u>Green</u></td> </tr> <tr> <td>DEPTH @ MAIN</td> <td><u>1.60m</u></td> <td><u>2.63m</u></td> <td><u>2.78m</u></td> </tr> <tr> <td>DEPTH @ ST. LINE</td> <td><u>1.89m</u></td> <td><u>2.91m</u></td> <td><u>3.26m</u></td> </tr> <tr> <td>ELEV @ MAIN</td> <td><u>90.80</u></td> <td><u>89.72</u></td> <td><u>89.57</u></td> </tr> <tr> <td>ELEV @ ST. LINE</td> <td><u>90.94</u></td> <td><u>89.92</u></td> <td><u>89.92</u></td> </tr> <tr> <td>MAIN SIZE</td> <td><u>200mm</u></td> <td><u>200mm</u></td> <td><u>525mm</u></td> </tr> </tbody> </table> <p>Contractor <u>Dexter Construction</u> Inspected By <u>Trevor Carter - GENIVAR inc.</u> Date <u>March 2011</u> Record Dwg. # <u>D09109-003 001</u></p> <p> Insulation <input checked="" type="checkbox"/> Yes <input type="checkbox"/> No Rock <input type="checkbox"/> Yes <input type="checkbox"/> No Clay Plug <input type="checkbox"/> Yes <input type="checkbox"/> No Trace Wire <input checked="" type="checkbox"/> Yes <input type="checkbox"/> No Anode <input type="checkbox"/> Yes <input checked="" type="checkbox"/> No </p> | | Water | Sanitary | Storm | LENGTH | <u>5.8m</u> | <u>8.4m</u> | <u>10.1m</u> | MATERIAL | <u>Polyethylene</u> | <u>PVC DR28</u> | <u>PVC DR35</u> | SIZE | <u>25mm</u> | <u>125mm</u> | <u>125mm</u> | COLOUR | <u>Blue</u> | <u>White</u> | <u>Green</u> | DEPTH @ MAIN | <u>1.60m</u> | <u>2.63m</u> | <u>2.78m</u> | DEPTH @ ST. LINE | <u>1.89m</u> | <u>2.91m</u> | <u>3.26m</u> | ELEV @ MAIN | <u>90.80</u> | <u>89.72</u> | <u>89.57</u> | ELEV @ ST. LINE | <u>90.94</u> | <u>89.92</u> | <u>89.92</u> | MAIN SIZE | <u>200mm</u> | <u>200mm</u> | <u>525mm</u> | <p>PRIVATE</p> <table border="1" style="width:100%; border-collapse: collapse;"> <thead> <tr> <th></th> <th>Water</th> <th>Sanitary</th> <th>Storm</th> </tr> </thead> <tbody> <tr> <td>LENGTH</td> <td></td> <td></td> <td></td> </tr> <tr> <td>MATERIAL</td> <td></td> <td></td> <td></td> </tr> <tr> <td>SIZE</td> <td></td> <td></td> <td></td> </tr> <tr> <td>COLOUR</td> <td></td> <td></td> <td></td> </tr> <tr> <td>DEPTH @ ST. LINE</td> <td></td> <td></td> <td></td> </tr> <tr> <td>DEPTH @ BLDG</td> <td></td> <td></td> <td></td> </tr> </tbody> </table> <p>Contractor _____ Inspected By _____ Date _____</p> <p>Sanitary Type: Pressurized <input type="checkbox"/> Gravity <input type="checkbox"/> Private Lift Station Info: Lift: <input type="checkbox"/> Distance <input type="checkbox"/></p> <p> Insulation <input type="checkbox"/> Yes <input type="checkbox"/> No Rock <input type="checkbox"/> Yes <input type="checkbox"/> No Clay Plug <input type="checkbox"/> Yes <input type="checkbox"/> No Foundation Drain Connected <input type="checkbox"/> Yes <input type="checkbox"/> No Rain Leaders Connected <input type="checkbox"/> Yes <input type="checkbox"/> No Trace Wire <input type="checkbox"/> Yes <input type="checkbox"/> No Sound Check <input type="checkbox"/> Yes <input type="checkbox"/> No </p> | | Water | Sanitary | Storm | LENGTH | | | | MATERIAL | | | | SIZE | | | | COLOUR | | | | DEPTH @ ST. LINE | | | | DEPTH @ BLDG | | | |
| | Water | Sanitary | Storm | | | | | | | | | | | | | | | | | | | | | | | | | | | | | | | | | | | | | | | | | | | | | | | | | | | | | | | | | | | | | | | | | | |
| LENGTH | <u>5.8m</u> | <u>8.4m</u> | <u>10.1m</u> | | | | | | | | | | | | | | | | | | | | | | | | | | | | | | | | | | | | | | | | | | | | | | | | | | | | | | | | | | | | | | | | | | |
| MATERIAL | <u>Polyethylene</u> | <u>PVC DR28</u> | <u>PVC DR35</u> | |
| SIZE | <u>25mm</u> | <u>125mm</u> | <u>125mm</u> | | | | | | | | | | | | | | | | | | | | | | | | | | | | | | | | | | | | | | | | | | | | | | | | | | | | | | | | | | | | | | | | | | |
| COLOUR | <u>Blue</u> | <u>White</u> | <u>Green</u> | | | | | | | | | | | | | | | | | | | | | | | | | | | | | | | | | | | | | | | | | | | | | | | | | | | | | | | | | | | | | | | | | | |
| DEPTH @ MAIN | <u>1.60m</u> | <u>2.63m</u> | <u>2.78m</u> | | | | | | | | | | | | | | | | | | | | | | | | | | | | | | | | | | | | | | | | | | | | | | | | | | | | | | | | | | | | | | | | | | |
| DEPTH @ ST. LINE | <u>1.89m</u> | <u>2.91m</u> | <u>3.26m</u> | | | | | | | | | | | | | | | | | | | | | | | | | | | | | | | | | | | | | | | | | | | | | | | | | | | | | | | | | | | | | | | | | | |
| ELEV @ MAIN | <u>90.80</u> | <u>89.72</u> | <u>89.57</u> | | | | | | | | | | | | | | | | | | | | | | | | | | | | | | | | | | | | | | | | | | | | | | | | | | | | | | | | | | | | | | | | | | |
| ELEV @ ST. LINE | <u>90.94</u> | <u>89.92</u> | <u>89.92</u> | | | | | | | | | | | | | | | | | | | | | | | | | | | | | | | | | | | | | | | | | | | | | | | | | | | | | | | | | | | | | | | | | | |
| MAIN SIZE | <u>200mm</u> | <u>200mm</u> | <u>525mm</u> | | | | | | | | | | | | | | | | | | | | | | | | | | | | | | | | | | | | | | | | | | | | | | | | | | | | | | | | | | | | | | | | | | |
| | Water | Sanitary | Storm | | | | | | | | | | | | | | | | | | | | | | | | | | | | | | | | | | | | | | | | | | | | | | | | | | | | | | | | | | | | | | | | | | |
| LENGTH | | | | | | | | | | | | | | | | | | | | | | | | | | | | | | | | | | | | | | | | | | | | | | | | | | | | | | | | | | | | | | | | | | | | | |
| MATERIAL | | | | | | | | | | | | | | | | | | | | | | | | | | | | | | | | | | | | | | | | | | | | | | | | | | | | | | | | | | | | | | | | | | | | | |
| SIZE | | | | | | | | | | | | | | | | | | | | | | | | | | | | | | | | | | | | | | | | | | | | | | | | | | | | | | | | | | | | | | | | | | | | | |
| COLOUR | | | | | | | | | | | | | | | | | | | | | | | | | | | | | | | | | | | | | | | | | | | | | | | | | | | | | | | | | | | | | | | | | | | | | |
| DEPTH @ ST. LINE | | | | | | | | | | | | | | | | | | | | | | | | | | | | | | | | | | | | | | | | | | | | | | | | | | | | | | | | | | | | | | | | | | | | | |
| DEPTH @ BLDG | | | | | | | | | | | | | | | | | | | | | | | | | | | | | | | | | | | | | | | | | | | | | | | | | | | | | | | | | | | | | | | | | | | | | |
| <p>PUBLIC Curb Stop To: UP4 = 21.1m UP5 = 21.8m Corp Stop To: UP4 = 20.5m UP5 = 21.0m San End To: UP4 = 21.3m UP5 = 22.6m</p> | | <p>PRIVATE <u>103</u> <u>104</u> <u>105</u></p> <p style="text-align: right;">SEE BACK FOR ADDITIONAL NOTES →</p> | |

|  | HALIFAX WATER SERVICE LATERAL INFORMATION SHEET | Street <u>Merlot Court</u> Lot <u>105</u> Civic _____ | |
|---|
| | | SLID# _____ | |
| <table border="1" style="width:100%; border-collapse: collapse;"> <thead> <tr> <th></th> <th style="text-align: center;">Water</th> <th style="text-align: center;">Sanitary</th> <th style="text-align: center;">Storm</th> </tr> </thead> <tbody> <tr> <td>LENGTH</td> <td style="text-align: center;">5.7m</td> <td style="text-align: center;">9.0m</td> <td style="text-align: center;">10.2m</td> </tr> <tr> <td>MATERIAL</td> <td style="text-align: center;">Polyethylene</td> <td style="text-align: center;">PVC DR28</td> <td style="text-align: center;">PVC DR35</td> </tr> <tr> <td>SIZE</td> <td style="text-align: center;">25mm</td> <td style="text-align: center;">125mm</td> <td style="text-align: center;">125mm</td> </tr> <tr> <td>COLOUR</td> <td style="text-align: center;">Blue</td> <td style="text-align: center;">White</td> <td style="text-align: center;">Green</td> </tr> <tr> <td>DEPTH @ MAIN</td> <td style="text-align: center;">1.77m</td> <td style="text-align: center;">3.05m</td> <td style="text-align: center;">3.08m</td> </tr> <tr> <td>DEPTH @ ST. LINE</td> <td style="text-align: center;">1.80m</td> <td style="text-align: center;">2.63m</td> <td style="text-align: center;">2.61m</td> </tr> <tr> <td>ELEV @ MAIN</td> <td style="text-align: center;">89.81</td> <td style="text-align: center;">88.53</td> <td style="text-align: center;">88.50</td> </tr> <tr> <td>ELEV @ ST. LINE</td> <td style="text-align: center;">89.99</td> <td style="text-align: center;">89.17</td> <td style="text-align: center;">89.19</td> </tr> <tr> <td>MAIN SIZE</td> <td style="text-align: center;">200mm</td> <td style="text-align: center;">200mm</td> <td style="text-align: center;">525mm</td> </tr> </tbody> </table> <p>Contractor <u>Dexter Construction</u> Inspected By <u>Trevor Carter - GENIVAR inc.</u> Date <u>April 2011</u> Record Dwg. # <u>009109-003 001</u></p> <table style="width:100%;"> <tr> <td>Insulation</td> <td><input checked="" type="checkbox"/> Yes</td> <td><input type="checkbox"/> No</td> </tr> <tr> <td>Rock</td> <td><input type="checkbox"/> Yes</td> <td><input type="checkbox"/> No</td> </tr> <tr> <td>Clay Plug</td> <td><input type="checkbox"/> Yes</td> <td><input type="checkbox"/> No</td> </tr> <tr> <td>Trace Wire</td> <td><input type="checkbox"/> Yes</td> <td><input type="checkbox"/> No</td> </tr> <tr> <td>Anode</td> <td><input type="checkbox"/> Yes</td> <td><input checked="" type="checkbox"/> No</td> </tr> </table> | | Water | Sanitary | Storm | LENGTH | 5.7m | 9.0m | 10.2m | MATERIAL | Polyethylene | PVC DR28 | PVC DR35 | SIZE | 25mm | 125mm | 125mm | COLOUR | Blue | White | Green | DEPTH @ MAIN | 1.77m | 3.05m | 3.08m | DEPTH @ ST. LINE | 1.80m | 2.63m | 2.61m | ELEV @ MAIN | 89.81 | 88.53 | 88.50 | ELEV @ ST. LINE | 89.99 | 89.17 | 89.19 | MAIN SIZE | 200mm | 200mm | 525mm | Insulation | <input checked="" type="checkbox"/> Yes | <input type="checkbox"/> No | Rock | <input type="checkbox"/> Yes | <input type="checkbox"/> No | Clay Plug | <input type="checkbox"/> Yes | <input type="checkbox"/> No | Trace Wire | <input type="checkbox"/> Yes | <input type="checkbox"/> No | Anode | <input type="checkbox"/> Yes | <input checked="" type="checkbox"/> No | <table border="1" style="width:100%; border-collapse: collapse;"> <thead> <tr> <th></th> <th style="text-align: center;">Water</th> <th style="text-align: center;">Sanitary</th> <th style="text-align: center;">Storm</th> </tr> </thead> <tbody> <tr> <td>LENGTH</td> <td></td> <td></td> <td></td> </tr> <tr> <td>MATERIAL</td> <td></td> <td></td> <td></td> </tr> <tr> <td>SIZE</td> <td></td> <td></td> <td></td> </tr> <tr> <td>COLOUR</td> <td></td> <td></td> <td></td> </tr> <tr> <td>DEPTH @ ST. LINE</td> <td></td> <td></td> <td></td> </tr> <tr> <td>DEPTH @ BLDG</td> <td></td> <td></td> <td></td> </tr> </tbody> </table> <p>Contractor _____ Inspected By _____ Date _____</p> <p>Sanitary Type: Pressurized <input type="checkbox"/> Gravity <input type="checkbox"/> Private Lift Station Info: Lift <input type="checkbox"/> Distance <input type="checkbox"/></p> <table style="width:100%;"> <tr> <td>Insulation</td> <td><input type="checkbox"/> Yes</td> <td><input type="checkbox"/> No</td> </tr> <tr> <td>Rock</td> <td><input type="checkbox"/> Yes</td> <td><input type="checkbox"/> No</td> </tr> <tr> <td>Clay Plug</td> <td><input type="checkbox"/> Yes</td> <td><input type="checkbox"/> No</td> </tr> <tr> <td>Foundation Drain Connected</td> <td><input type="checkbox"/> Yes</td> <td><input type="checkbox"/> No</td> </tr> <tr> <td>Rain Leaders Connected</td> <td><input type="checkbox"/> Yes</td> <td><input type="checkbox"/> No</td> </tr> <tr> <td>Trace Wire</td> <td><input type="checkbox"/> Yes</td> <td><input type="checkbox"/> No</td> </tr> <tr> <td>Sound Check</td> <td><input type="checkbox"/> Yes</td> <td><input type="checkbox"/> No</td> </tr> </table> | | Water | Sanitary | Storm | LENGTH | | | | MATERIAL | | | | SIZE | | | | COLOUR | | | | DEPTH @ ST. LINE | | | | DEPTH @ BLDG | | | | Insulation | <input type="checkbox"/> Yes | <input type="checkbox"/> No | Rock | <input type="checkbox"/> Yes | <input type="checkbox"/> No | Clay Plug | <input type="checkbox"/> Yes | <input type="checkbox"/> No | Foundation Drain Connected | <input type="checkbox"/> Yes | <input type="checkbox"/> No | Rain Leaders Connected | <input type="checkbox"/> Yes | <input type="checkbox"/> No | Trace Wire | <input type="checkbox"/> Yes | <input type="checkbox"/> No | Sound Check | <input type="checkbox"/> Yes | <input type="checkbox"/> No |
| | Water | Sanitary | Storm | |
| LENGTH | 5.7m | 9.0m | 10.2m | |
| MATERIAL | Polyethylene | PVC DR28 | PVC DR35 | |
| SIZE | 25mm | 125mm | 125mm | |
| COLOUR | Blue | White | Green | |
| DEPTH @ MAIN | 1.77m | 3.05m | 3.08m | |
| DEPTH @ ST. LINE | 1.80m | 2.63m | 2.61m | |
| ELEV @ MAIN | 89.81 | 88.53 | 88.50 | |
| ELEV @ ST. LINE | 89.99 | 89.17 | 89.19 | |
| MAIN SIZE | 200mm | 200mm | 525mm | |
| Insulation | <input checked="" type="checkbox"/> Yes | <input type="checkbox"/> No | |
| Rock | <input type="checkbox"/> Yes | <input type="checkbox"/> No | |
| Clay Plug | <input type="checkbox"/> Yes | <input type="checkbox"/> No | |
| Trace Wire | <input type="checkbox"/> Yes | <input type="checkbox"/> No | |
| Anode | <input type="checkbox"/> Yes | <input checked="" type="checkbox"/> No | |
| | Water | Sanitary | Storm | |
| LENGTH | |
| MATERIAL | |
| SIZE | |
| COLOUR | |
| DEPTH @ ST. LINE | |
| DEPTH @ BLDG | |
| Insulation | <input type="checkbox"/> Yes | <input type="checkbox"/> No | |
| Rock | <input type="checkbox"/> Yes | <input type="checkbox"/> No | |
| Clay Plug | <input type="checkbox"/> Yes | <input type="checkbox"/> No | |
| Foundation Drain Connected | <input type="checkbox"/> Yes | <input type="checkbox"/> No | |
| Rain Leaders Connected | <input type="checkbox"/> Yes | <input type="checkbox"/> No | |
| Trace Wire | <input type="checkbox"/> Yes | <input type="checkbox"/> No | |
| Sound Check | <input type="checkbox"/> Yes | <input type="checkbox"/> No | |
|  <p>PUBLIC Curb Stop To: UP4 = 7.1m UP5 = 33.8m Corp Stop To: UP4 = 8.0m UP5 = 33.8m</p> <p>San End To: UP4 = 7.7m UP5 = 36.7m</p> | <p style="text-align: center;">PRIVATE</p> <p style="text-align: center; font-size: 2em;">104</p> <hr/> <p style="text-align: center; font-size: 2em;">105</p> <hr/> <p style="text-align: center; font-size: 2em;">106</p> | |
| | | SEE BACK FOR ADDITIONAL NOTES → | |