
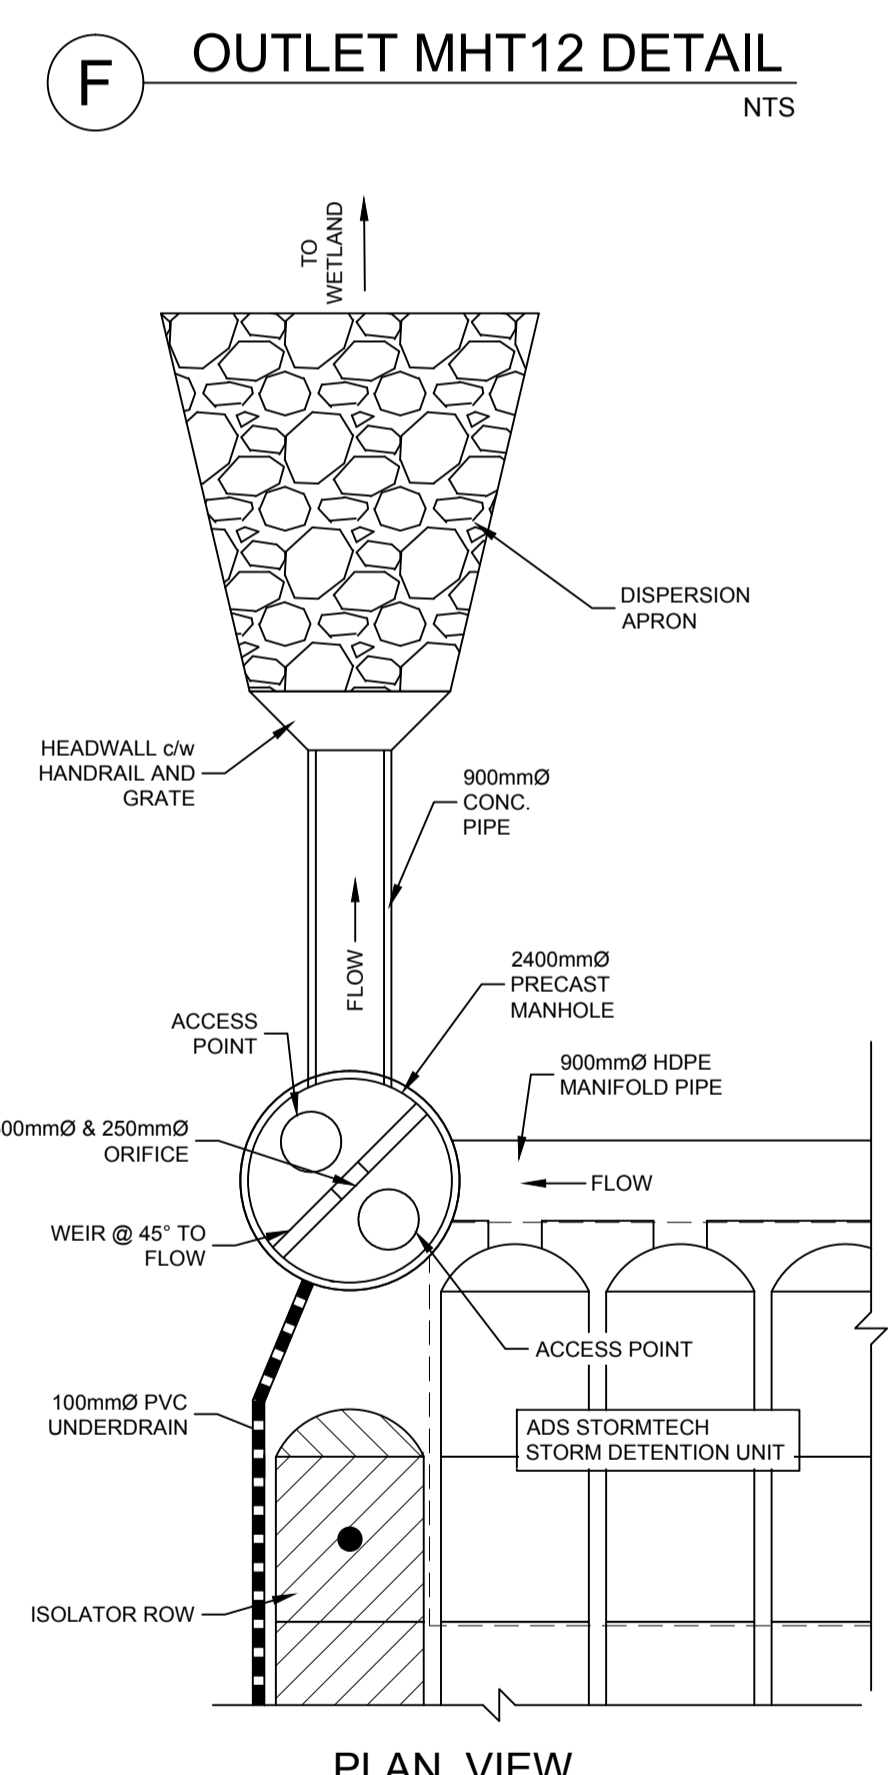
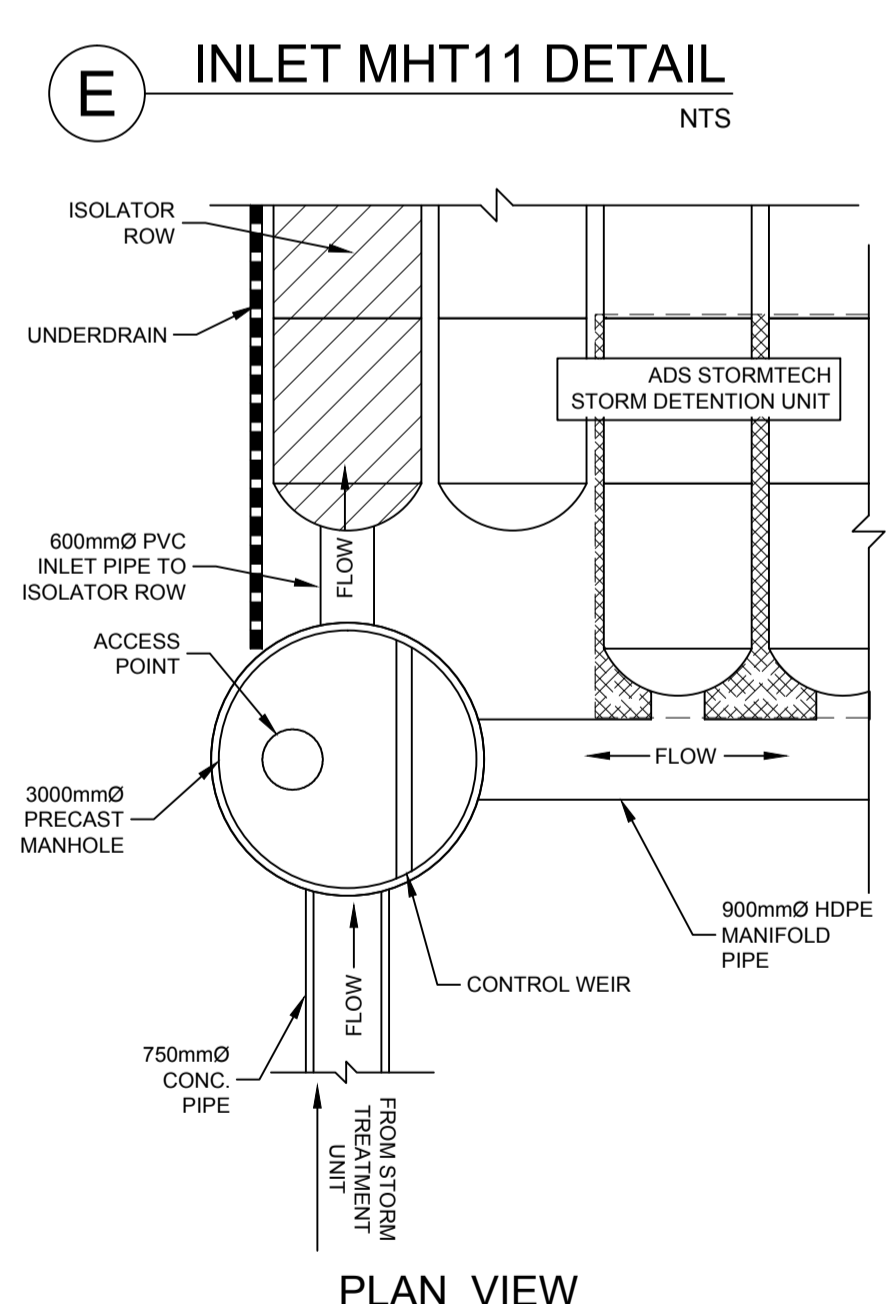


VALVE SWING TIES
WV1 TO UP1 = 14.8m
WV1 TO ARV VENT = 3.4m
ARV TO UP1 = 13.3m
ARV TO ARV VENT = 2.9m

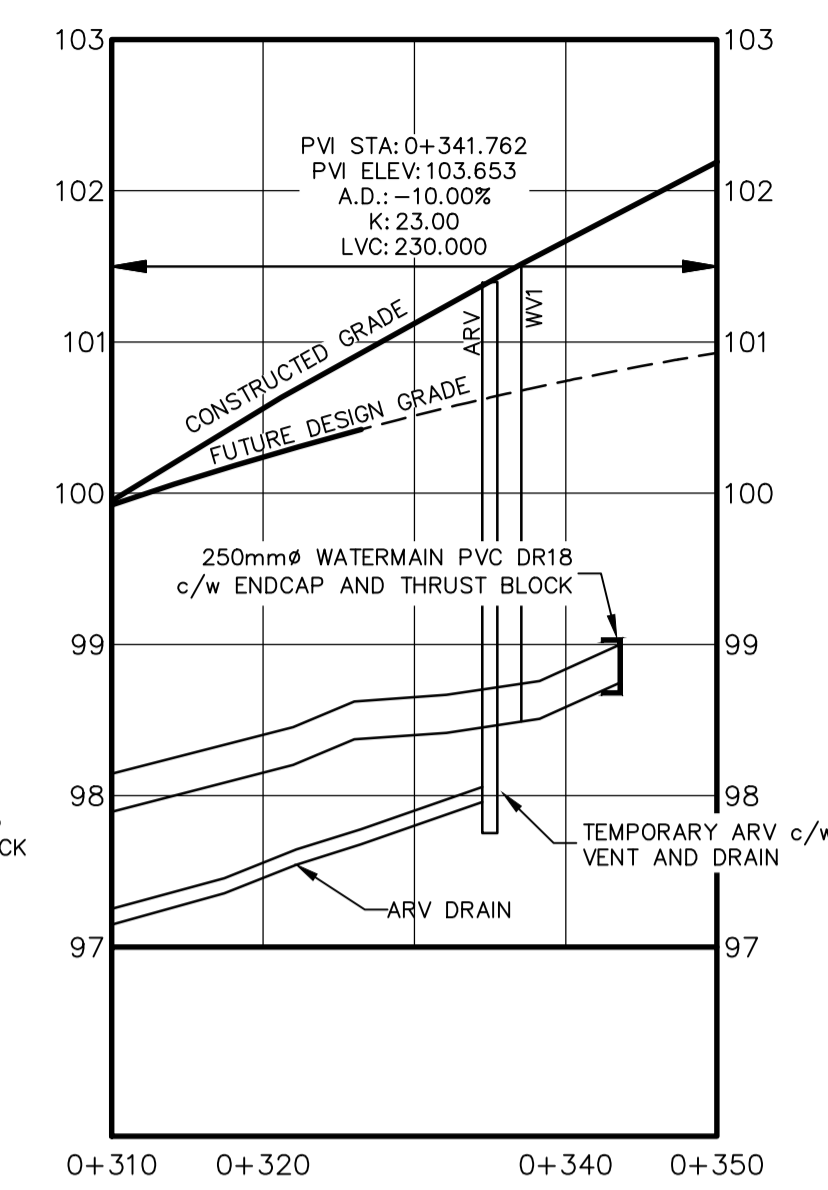

wsp
WSP Canada Inc.
1 Spectacle Lake Drive
Dartmouth, Nova Scotia, Canada B3B 1X7
T 902-835-9955 F 902-835-1645 www.wsp.com

SEAL:
REGISTERED PROFESSIONAL ENGINEER
DATE: 2018/10/15
C. G. A. MUTCH
8031
PROVINCE OF NOVA SCOTIA

KEY PLAN:
Timberlea
SITE
Government Lake
Lakeside
Highway 102
Hwy 102
Hwy 102
Hwy 102

DISCLAIMER: DRAWINGS ARE PRELIMINARY AND ARE SUBJECT TO APPROVAL PRIOR TO CONSTRUCTION. THIS DRAWING AND DESIGN IS COPYRIGHT PROTECTED WHICH SHALL NOT BE USED, REPRODUCED OR REVISED WITHOUT WRITTEN PERMISSION BY WSP CANADA INC. THE CONTRACTOR SHALL CHECK AND VERIFY ALL DIMENSIONS AND UTILITY LOCATIONS AND REPORT ALL ERRORS AND OMISSIONS PRIOR TO COMMENCING WORK. SEE SHEET 11 FOR CONSTRUCTION NOTES AND DETAILS.

REVISION:

11	2018/10/15	RECORD DRAWING
10	2018/04/04	REVISIONS FOR APPROVED LIGHT DESIGN
9	2018/03/21	ISSUED FOR CONSTRUCTION
8	2018/02/26	REVISED LOTS 216-232, PRIMARY POWER
7	2013/07/22	2017/10/27 VARIOUS REVISIONS
0	2012/12/21	ISSUED FOR REVIEW

PROJECT NO: 121-24187
DATE: (YYYY/MM/DD) 2012/12/21
ORIGINAL SCALE: HORIZONTAL: AS NOTED VERTICAL: N/A
DESIGNED BY: C. MUTCH, P.ENG.
DRAWN BY: S. LEWIS, E.I.T.
CHECKED BY: C. MUTCH, P.ENG.

SCALE: 1:250 METRIC
5 4 3 2 1 0 5 10 15

CLIENT: BRUNELLO ESTATES INC.

CLIENT REF. #
PROJECT: BRUNELLO ESTATES PHASE 2.1
TIMBERLEA, NOVA SCOTIA

TITLE: STORM DETENTION DETAILS

SHEET NUMBER: 7
SHEET # 7 OF 11
ISSUE: RECORD DRAWING
DATE OF: 2018/10/15
REV # 11

XREFS: K:\DARTMOUTH\2012\121-24187-BRUNELLO PH. 2\DWG\ENG\RECORD DRAWING\121-24187-BASE-REC.DWG - K:\DARTMOUTH\2012\121-24187-BRUNELLO PH.

PRINTED: 8:35 AM 2018/10/15 BY: GRAGLUTZ STORM DETENTION DETAILS