



HALIFAX REGIONAL WATER COMMISSION

SERVICE CONNECTION CARD

STREET Brynnewo Blvd

LOT 201 CIVIC _____

HRM SUBDIVISION #: _____

PERMIT #: _____

SLID _____

PUBLIC

WATER	SANITARY	STORM
9.125M	9.55M	11.1M
MULLIPEX	PVC DR 28	PVC DR 35
25mm	125mm	100mm
Blue	White	Green
1.8M	2.6M	2.7M
1.85M	2.13M	2.18M
88.7M	87.7M	87.6M
88.6M	88.3M	88.28M
250mm	375mm	750mm
0.63M		
	2.44M	2.64M

LENGTH:
MATERIAL:
SIZE:
COLOUR:
DEPTH @ MAIN:
DEPTH @ ST. LINE:
T.O.P. ELEV. @ MAIN:
T.O.P. ELEV. @ ST. LINE:
MAIN SIZE:
CURB STOP TO ST. LINE*:
ST. LINE TO STUB*:

*IF APPLICABLE

CONTRACTOR: DEXTER CONSTRUCTION
INSPECTED BY: WSP
DATE: APRIL 2018
RECORD DWG. #: 121-24187 SHEET 2

INSULATION:	<input checked="" type="checkbox"/> YES	<input type="checkbox"/> NO
ROCK:	<input checked="" type="checkbox"/> YES	<input type="checkbox"/> NO
CLAY PLUG:	<input type="checkbox"/> YES	<input checked="" type="checkbox"/> NO
TRACE WIRE:	<input checked="" type="checkbox"/> YES	<input type="checkbox"/> NO
ANODE:	<input checked="" type="checkbox"/> YES	<input type="checkbox"/> NO
DRIVEWAY CULVERT	<input type="checkbox"/> YES	<input checked="" type="checkbox"/> NO
PRE-CAST HEADWALLS	<input type="checkbox"/> YES	<input checked="" type="checkbox"/> NO

DRIVEWAY CULVERT SIZE MATERIAL

ADDITIONAL NOTES & COMMENTS:

PRIVATE

WATER	SANITARY	STORM

LENGTH:
MATERIAL:
SIZE:
COLOUR:
DEPTH @ BLDG:
CONTRACTOR:
INSPECTED BY:
DATE:

INSULATION:	<input type="checkbox"/> YES	<input type="checkbox"/> NO
ROCK:	<input type="checkbox"/> YES	<input type="checkbox"/> NO
CLAY PLUG:	<input type="checkbox"/> YES	<input type="checkbox"/> NO
TRACE WIRE:	<input type="checkbox"/> YES	<input type="checkbox"/> NO
SOUND CHECK:	<input type="checkbox"/> YES	<input type="checkbox"/> NO

FOUNDATION DRAIN CONNECTED:	<input type="checkbox"/> YES	<input type="checkbox"/> NO
RAIN LEADERS CONNECTED:	<input type="checkbox"/> YES	<input type="checkbox"/> NO
SANITARY TYPE:	<input type="checkbox"/> PRESSURE	<input type="checkbox"/> GRAVITY

PRIVATE LIFT STATION INFO: LIFT: _____
DISTANCE: _____

ADDITIONAL NOTES & COMMENTS:



HALIFAX REGIONAL WATER COMMISSION
SERVICE CONNECTION CARD

STREET BRUNELLO BLVD

LOT 201 CIVIC _____


LOT 202

LOT 201

TIMBENLEA VILLAGE PKWY

PRIVATE

PUBLIC

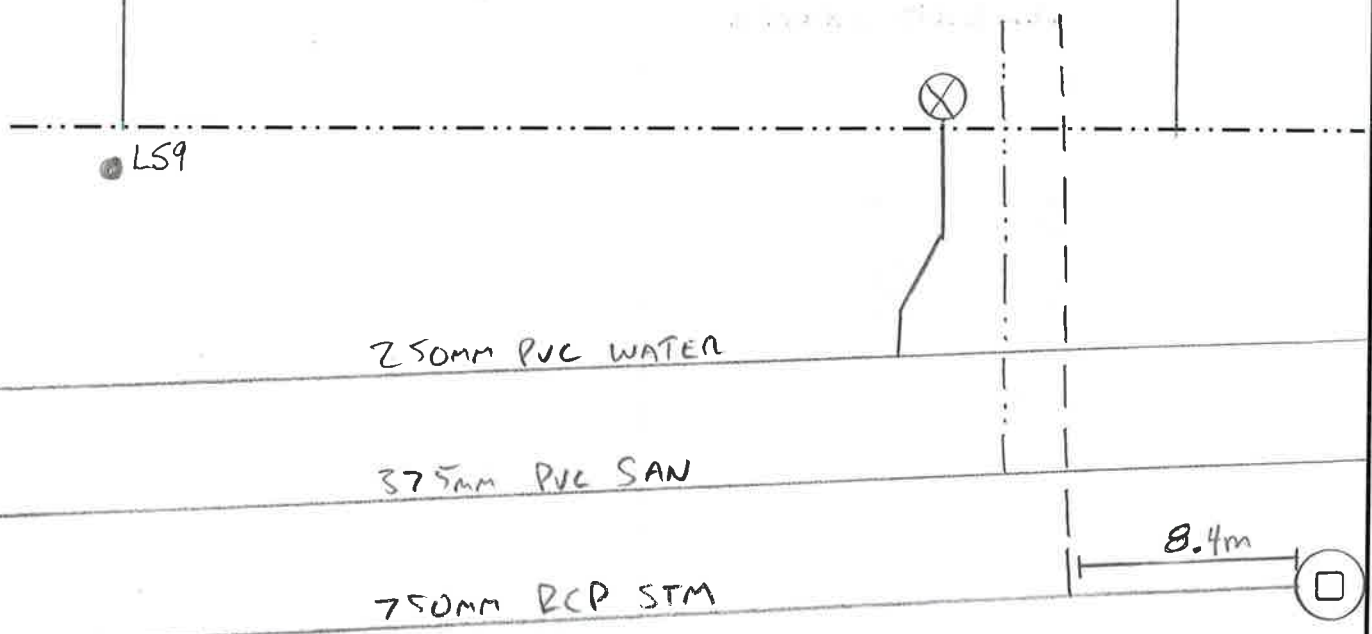

- CURBSTOP TO LS9 = 23.0m
- CURBSTOP TO LS10 = 15.4m
- CORP. STOP TO LS9 = 21.1m
- CORP. STOP TO LS10 = 7.3m



SEE REVERSE FOR DETAILS →



HALIFAX REGIONAL WATER COMMISSION

SERVICE CONNECTION CARD

STREET SAUNELLO BLVD

LOT 202 CIVIC _____

HRM SUBDIVISION #: _____

PERMIT #: _____

SLID _____

PUBLIC

	WATER	SANITARY	STORM
LENGTH:	9.27m	10.10m	10.04m
MATERIAL:	manilpeck	PVC DR 28	PVC DR 35
SIZE:	25mm	125mm	100mm
COLOUR:	Blue	White	Green
DEPTH @ MAIN:	1.7m	2.7m	2.8m
DEPTH @ ST. LINE:	1.84m	2.29m	2.32m
T.O.P. ELEV. @ MAIN:	88.8m	87.8m	87.7m
T.O.P. ELEV. @ ST. LINE:	88.78m	88.55m	88.52m
MAIN SIZE:	250mm	375mm	750mm
CURB STOP TO ST. LINE*:	0.68m		
ST. LINE TO STUB*:		2.30m	2.31m

*If Applicable

CONTRACTOR: Dexter Construction
 INSPECTED BY: WSP
 DATE: April 2018
 RECORD DWG. #: 121-24187 SHEET 2

INSULATION:	<input checked="" type="checkbox"/> YES	<input type="checkbox"/> NO
ROCK:	<input checked="" type="checkbox"/> YES	<input type="checkbox"/> NO
CLAY PLUG:	<input type="checkbox"/> YES	<input checked="" type="checkbox"/> NO
TRACE WIRE:	<input checked="" type="checkbox"/> YES	<input type="checkbox"/> NO
ANODE:	<input checked="" type="checkbox"/> YES	<input type="checkbox"/> NO
DRIVEWAY CULVERT	<input type="checkbox"/> YES	<input checked="" type="checkbox"/> NO
PRE-CAST HEADWALLS	<input type="checkbox"/> YES	<input checked="" type="checkbox"/> NO

DRIVEWAY CULVERT SIZE _____
 MATERIAL _____

ADDITIONAL NOTES & COMMENTS:

PRIVATE

	WATER	SANITARY	STORM
LENGTH:			
MATERIAL:			
SIZE:			
COLOUR:			
DEPTH @ BLDG:			

CONTRACTOR: _____
 INSPECTED BY: _____
 DATE: _____

INSULATION:	<input type="checkbox"/> YES	<input type="checkbox"/> NO
ROCK:	<input type="checkbox"/> YES	<input type="checkbox"/> NO
CLAY PLUG:	<input type="checkbox"/> YES	<input type="checkbox"/> NO
TRACE WIRE:	<input type="checkbox"/> YES	<input type="checkbox"/> NO
SOUND CHECK:	<input type="checkbox"/> YES	<input type="checkbox"/> NO

FOUNDATION DRAIN CONNECTED:	<input type="checkbox"/> YES	<input type="checkbox"/> NO
RAIN LEADERS CONNECTED:	<input type="checkbox"/> YES	<input type="checkbox"/> NO
SANITARY TYPE:	<input type="checkbox"/> PRESSURE	<input type="checkbox"/> GRAVITY

PRIVATE LIFT STATION INFO: LIFT: _____
 DISTANCE: _____

ADDITIONAL NOTES & COMMENTS:



HALIFAX REGIONAL WATER COMMISSION
SERVICE CONNECTION CARD

STREET BRUNELLO BLVD


LOT 202 CIVIC _____

LOT 203

LOT 202

LOT 201

PRIVATE

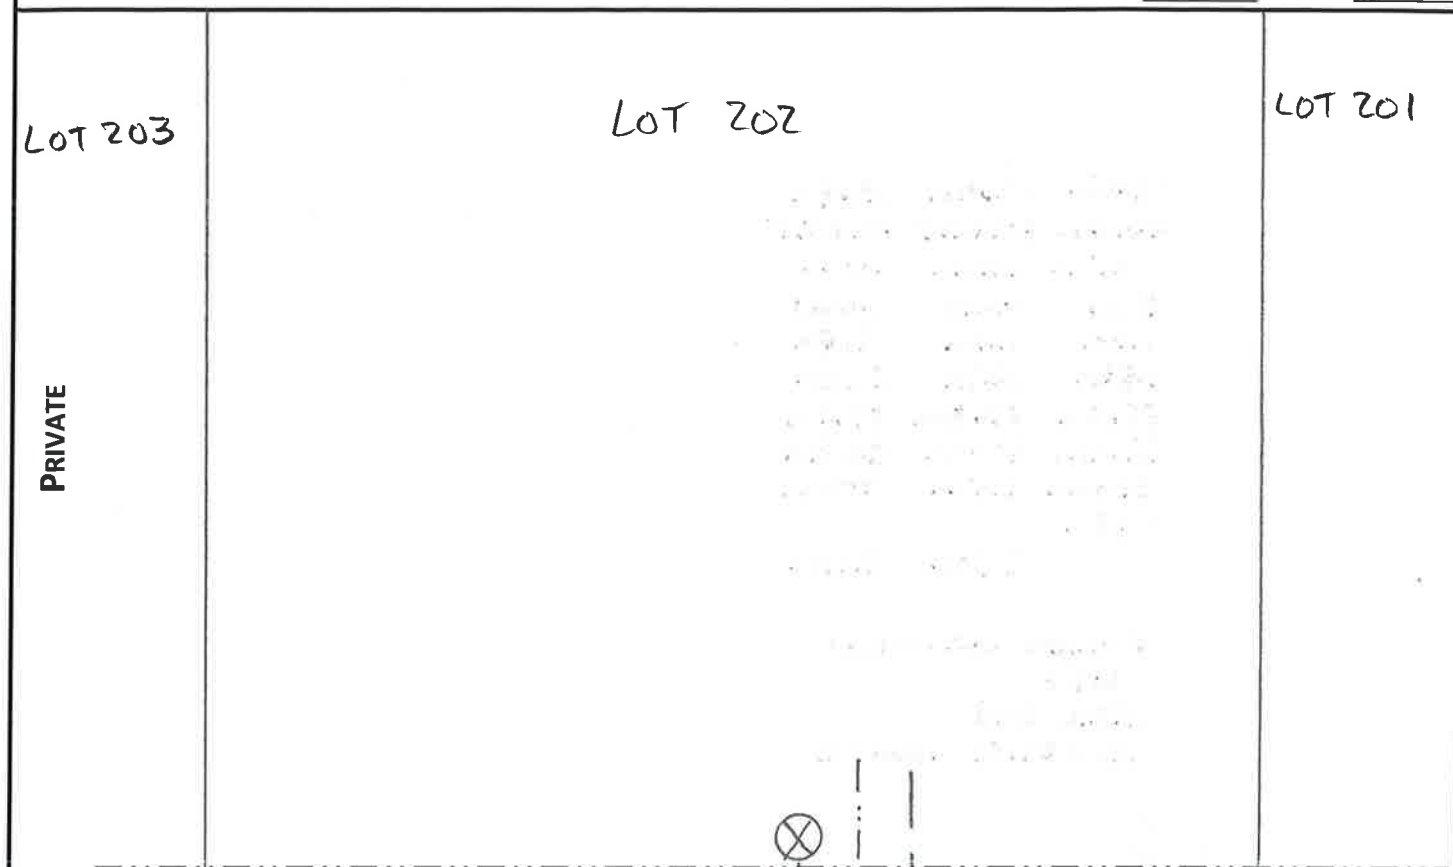

● LS9

250mm PVC WATER

375mm PVC SAN

750mm RCP STM

21.4M



MHT3A

CURB STOP TO LS9 = 12.2m

CURB STOP TO LS10 = 21.1m

CORP. STOP TO LS9 = 10.1m

CORP. STOP TO LS10 = 17.0m

● LS10



PUBLIC

SEE REVERSE FOR DETAILS →



HALIFAX REGIONAL WATER COMMISSION

SERVICE CONNECTION CARD

STREET BRUNELLO BLVD

LOT 203 CIVIC _____


LOT 204

LOT 203

LOT 202

PRIVATE

[Faint, mostly illegible handwritten notes in the center of the lot, possibly describing property details or survey information.]

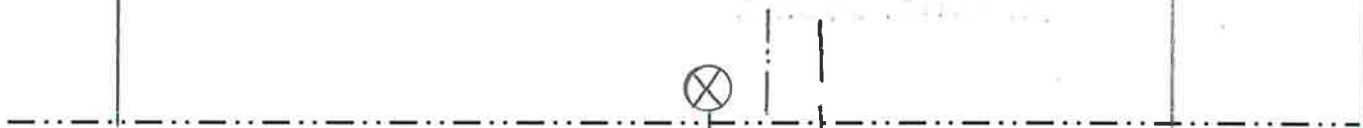


LS9 ●

250mm PVC WATER

13.7M

375mm PVC SAN

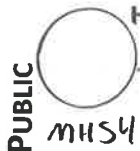

750mm RCP STM

- CURB STOP TO LS9 = 3.8m
- CURB STOP TO LS10 = 28.0m
- CORP. STOP TO LS9 = 5.4m
- CORP. STOP TO LS10 = 24.5m



SEE REVERSE FOR DETAILS →



HALIFAX REGIONAL WATER COMMISSION

SERVICE CONNECTION CARD

STREET BROWNELL RD

LOT 204 CIVIC _____

HRM SUBDIVISION #: _____

PERMIT #: _____

SLID _____

PUBLIC

	WATER	SANITARY	STORM
LENGTH:	7.30m	8.67m	10.45m
MATERIAL:	MUNICIPAL	PVC DR28	PVC DR35
SIZE:	250mm	125mm	100mm
COLOUR:	BLUE	WHITE	GREEN
DEPTH @ MAIN:	1.86	3.1m	3.1m
DEPTH @ ST. LINE:	1.98m	2.5m	2.5m
T.O.P. ELEV. @ MAIN:	89.2m	87.9m	87.9m
T.O.P. ELEV. @ ST. LINE:	89.3m	88.57m	88.55m
MAIN SIZE:	250mm	375mm	750mm
CURB STOP TO ST. LINE*:	0.55m		
ST. LINE TO STUB*:		2.53m	2.65m

*IF APPLICABLE

CONTRACTOR: DEXTER INSTALLATION
 INSPECTED BY: WSP
 DATE: APRIL 2018
 RECORD DWG. #: 171-24187 SHEET 2

INSULATION:	<input checked="" type="checkbox"/> YES	<input type="checkbox"/> NO
ROCK:	<input checked="" type="checkbox"/> YES	<input type="checkbox"/> NO
CLAY PLUG:	<input type="checkbox"/> YES	<input checked="" type="checkbox"/> NO
TRACE WIRE:	<input checked="" type="checkbox"/> YES	<input type="checkbox"/> NO
ANODE:	<input checked="" type="checkbox"/> YES	<input type="checkbox"/> NO
DRIVEWAY CULVERT	<input type="checkbox"/> YES	<input checked="" type="checkbox"/> NO
PRE-CAST HEADWALLS	<input type="checkbox"/> YES	<input checked="" type="checkbox"/> NO

DRIVEWAY CULVERT SIZE MATERIAL

ADDITIONAL NOTES & COMMENTS:

PRIVATE

WATER	SANITARY	STORM

LENGTH: _____
 MATERIAL: _____
 SIZE: _____
 COLOUR: _____
 DEPTH @ BLDG: _____
 CONTRACTOR: _____
 INSPECTED BY: _____
 DATE: _____

INSULATION:	<input type="checkbox"/> YES	<input type="checkbox"/> NO
ROCK:	<input type="checkbox"/> YES	<input type="checkbox"/> NO
CLAY PLUG:	<input type="checkbox"/> YES	<input type="checkbox"/> NO
TRACE WIRE:	<input type="checkbox"/> YES	<input type="checkbox"/> NO
SOUND CHECK:	<input type="checkbox"/> YES	<input type="checkbox"/> NO

FOUNDATION DRAIN CONNECTED:	<input type="checkbox"/> YES	<input type="checkbox"/> NO
RAIN LEADERS CONNECTED:	<input type="checkbox"/> YES	<input type="checkbox"/> NO
SANITARY TYPE:	<input type="checkbox"/> PRESSURE	<input type="checkbox"/> GRAVITY

PRIVATE LIFT STATION INFO: LIFT: _____
 DISTANCE: _____

ADDITIONAL NOTES & COMMENTS:



HALIFAX REGIONAL WATER COMMISSION

SERVICE CONNECTION CARD

STREET Brunello Blvd

LOT 204 CIVIC _____

LOT 205

LOT 204

LOT 203

PRIVATE


[Faint, illegible text, likely a site plan or survey drawing]



LS9

250mm PVC WATER

375mm PVC SAN

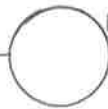


MHS4

2.6m

PUBLIC

750mm RCP STM

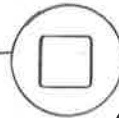

MHT4

LS8

CURBSTOP TO LS8 = 18.6m

CURBSTOP TO LS9 = 11.8m

CORP. STOP TO LS8 = 13.6m

CORP. STOP TO LS9 = 11.5m



SEE REVERSE FOR DETAILS →



HALIFAX REGIONAL WATER COMMISSION

SERVICE CONNECTION CARD

STREET BRUNELLO BLVD

LOT 205 CIVIC _____

HRM SUBDIVISION #: _____

PERMIT #: _____

SLID _____

PUBLIC

	WATER	SANITARY	STORM
LENGTH:	7.68m	8.53m	10.40m
MATERIAL:	Municipal	PVC DR 28	PVC DR 35
SIZE:	25mm	125mm	100mm
COLOUR:	Blue	White	Green
DEPTH @ MAIN:	1.9m	2.8m	3.1m
DEPTH @ ST. LINE:	2.0m	2.5m	2.52m
T.O.P. ELEV. @ MAIN:	89.5m	88.6m	88.3m
T.O.P. ELEV. @ ST. LINE:	89.57m	89.05m	89.04m
MAIN SIZE:	250mm	375mm	750mm
CURB STOP TO ST. LINE*:	0.59m		
ST. LINE TO STUB*:		2.50m	2.60m

*IF APPLICABLE

CONTRACTOR: Dexter Construction
 INSPECTED BY: WSP
 DATE: APRIL 2018
 RECORD DWG. #: 121-24187 SHEET 2

- INSULATION: YES NO
- ROCK: YES NO
- CLAY PLUG: YES NO
- TRACE WIRE: YES NO
- ANODE: YES NO
- DRIVEWAY CULVERT: YES NO
- PRE-CAST HEADWALLS: YES NO

DRIVEWAY CULVERT SIZE MATERIAL

ADDITIONAL NOTES & COMMENTS:

PRIVATE

	WATER	SANITARY	STORM
LENGTH:			
MATERIAL:			
SIZE:			
COLOUR:			
DEPTH @ BLDG:			

CONTRACTOR: _____
 INSPECTED BY: _____
 DATE: _____

- INSULATION: YES NO
- ROCK: YES NO
- CLAY PLUG: YES NO
- TRACE WIRE: YES NO
- SOUND CHECK: YES NO

- FOUNDATION DRAIN CONNECTED: YES NO
- RAIN LEADERS CONNECTED: YES NO
- SANITARY TYPE: PRESSURE GRAVITY

PRIVATE LIFT STATION INFO: LIFT: _____
 DISTANCE: _____

ADDITIONAL NOTES & COMMENTS:



HALIFAX REGIONAL WATER COMMISSION

SERVICE CONNECTION CARD

STREET BRUNELLO BLVD

LOT 205 CIVIC _____

LOT 206

LOT 205

LOT 204

PRIVATE

[Faint handwritten notes in the center of the lot, possibly describing property details or survey information.]




LS9

250mm PVC WATER

375mm PVC SAN

750mm RCP STM

7.4m

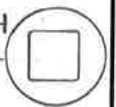

MHT4

PUBLIC

CURBSTOP TO LSB = 14.3m

CURBSTOP TO LS9 = 21.8m

CORPSTOP TO LSB = 6.3m

CORPSTOP TO LS9 = 22.8m

LSB



SEE REVERSE FOR DETAILS →



HALIFAX REGIONAL WATER COMMISSION

SERVICE CONNECTION CARD

STREET BRUNELLO BLVD

LOT 206 CIVIC _____

LOT 207

LOT 206

LOT 205

PRIVATE


[Faint, illegible handwritten notes in the center of the lot area]

● LST

250mm PVC WATER
23.6M

375mm PVC SAN

750mm RCP STM

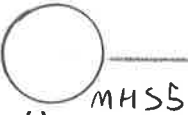

PUBLIC

CURB STOP TO LST = 12.2m
 CURB STOP TO LSB = 17.2m
 CORP. STOP TO LST = 10.5m
 CORP. STOP TO LSB = 13.3m

● LSB



SEE REVERSE FOR DETAILS →



HALIFAX REGIONAL WATER COMMISSION
SERVICE CONNECTION CARD

STREET BRUNELLO BLVD
 LOT 207 CIVIC _____

LOT 208

LOT 207

LOT 206

PRIVATE

[Faint, illegible handwritten notes in the center of the lot area]




LS7

250mm PVC WATER

13.6m

375mm PVC SAN

750mm RCP STM

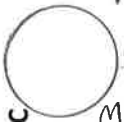

MHSS

PUBLIC

- CURB STOP TO LS7 = 3.8m
- CURB STOP TO LS8 = 24.7m
- CORP. STOP TO LS7 = 4.1m
- CORP. STOP TO LS8 = 21.2m



SEE REVERSE FOR DETAILS →



HALIFAX REGIONAL WATER COMMISSION

SERVICE CONNECTION CARD

STREET BROOKFIELD BLVD

LOT 208 CIVIC _____

HRM SUBDIVISION #: _____

PERMIT #: _____

SLID _____

PUBLIC

	WATER	SANITARY	STORM
LENGTH:	7.02M	8.24M	9.93M
MATERIAL:	MUNICIPAL	PVC DR 28	PVC DR 35
SIZE:	250mm	125mm	100mm
COLOUR:	BLUE	WHITE	GREEN
DEPTH @ MAIN:	1.85M	2.85M	2.95M
DEPTH @ ST. LINE:	1.74M	2.26M	2.35M
T.O.P. ELEV. @ MAIN:	91.2M	90.2M	90.1M
T.O.P. ELEV. @ ST. LINE:	91.37M	90.84M	90.75M
MAIN SIZE:	250mm	375mm	750mm
CURB STOP TO ST. LINE*:	0.63m		
ST. LINE TO STUB*:		2.47M	2.31M

*IF APPLICABLE

PRIVATE

	WATER	SANITARY	STORM
LENGTH:			
MATERIAL:			
SIZE:			
COLOUR:			
DEPTH @ BLDG:			

LENGTH:

MATERIAL:

SIZE:

COLOUR:

DEPTH @ BLDG:

CONTRACTOR:

INSPECTED BY:

DATE:

CONTRACTOR:

DEXTER CONSTRUCTION

INSPECTED BY:

WSP

DATE:

APRIL 2018

RECORD DWG. #:

121-24187 SHEET 2

INSULATION:

YES

NO

ROCK:

YES

NO

CLAY PLUG:

YES

NO

TRACE WIRE:

YES

NO

ANODE:

YES

NO

DRIVEWAY CULVERT

YES

NO

PRE-CAST HEADWALLS

YES

NO

DRIVEWAY CULVERT

SIZE

MATERIAL

ADDITIONAL NOTES & COMMENTS:

INSULATION:

YES

NO

ROCK:

YES

NO

CLAY PLUG:

YES

NO

TRACE WIRE:

YES

NO

SOUND CHECK:

YES

NO

FOUNDATION DRAIN CONNECTED:

YES

NO

RAIN LEADERS CONNECTED:

YES

NO

SANITARY TYPE:

PRESSURE

GRAVITY

PRIVATE LIFT STATION INFO:

LIFT:

DISTANCE:

ADDITIONAL NOTES & COMMENTS:



HALIFAX REGIONAL WATER COMMISSION
SERVICE CONNECTION CARD

STREET BUNJELD BLVD

LOT 208 CIVIC _____

LOT 209

LOT 208

LOT 207

PRIVATE

[Faint handwritten notes in the center of Lot 208, likely describing property details or easements.]



MHSB

PUBLIC

250mm PVC WATER
2.4M

375mm PVC SAN

750mm RCP STM



LS7



LS6

CURB STOP TO LS6 = 21.7m
 CURB STOP TO LS7 = 10.6m
 CORP. STOP TO LS6 = 17.7m
 CORP. STOP TO LS7 = 10.7m



SEE REVERSE FOR DETAILS →



HALIFAX REGIONAL WATER COMMISSION

SERVICE CONNECTION CARD

STREET Brunello Blvd

LOT 209 CIVIC _____

HRM SUBDIVISION #: _____

PERMIT #: _____

SLID _____

PUBLIC

	WATER	SANITARY	STORM
LENGTH:	7.00M	8.25M	9.83M
MATERIAL:	MUNICIPAL	PVC DR28	PVC DR35
SIZE:	25mm	125mm	100mm
COLOUR:	BLUE	WHITE	GREEN
DEPTH @ MAIN:	1.7M	2.6M	2.7M
DEPTH @ ST. LINE:	1.72M	2.18M	2.23M
T.O.P. ELEV. @ MAIN:	92.1M	91.1M	91.0M
T.O.P. ELEV. @ ST. LINE:	92.19M	91.72M	91.67M
MAIN SIZE:	250mm	375mm	750mm
CURB STOP TO ST. LINE*:	0.63M		
ST. LINE TO STUB*:		2.34M	2.54M

*IF APPLICABLE

PRIVATE

	WATER	SANITARY	STORM
LENGTH:			
MATERIAL:			
SIZE:			
COLOUR:			
DEPTH @ BLDG:			

LENGTH:

MATERIAL:

SIZE:

COLOUR:

DEPTH @ BLDG:

CONTRACTOR:

INSPECTED BY:

DATE:

CONTRACTOR:

DEXTER CONSTRUCTION

INSPECTED BY:

WSD

DATE:

APRIL 2018

RECORD DWG. #:

121-24187 SHEET 2

INSULATION:

YES

NO

ROCK:

YES

NO

CLAY PLUG:

YES

NO

TRACE WIRE:

YES

NO

ANODE:

YES

NO

DRIVEWAY CULVERT

YES

NO

PRE-CAST HEADWALLS

YES

NO

DRIVEWAY CULVERT

SIZE

MATERIAL

INSULATION:

YES

NO

ROCK:

YES

NO

CLAY PLUG:

YES

NO

TRACE WIRE:

YES

NO

SOUND CHECK:

YES

NO

FOUNDATION DRAIN CONNECTED:

YES

NO

RAIN LEADERS CONNECTED:

YES

NO

SANITARY TYPE:

PRESSURE

GRAVITY

PRIVATE LIFT STATION INFO:

LIFT:

DISTANCE:

ADDITIONAL NOTES & COMMENTS:

ADDITIONAL NOTES & COMMENTS:



HALIFAX REGIONAL WATER COMMISSION
SERVICE CONNECTION CARD

STREET BRUNELLO BLVD

LOT 209 CIVIC _____

LOT 210


LOT 209

LOT 208

PRIVATE

[Faint, illegible handwritten notes in the center of the lot area]

PUBLIC

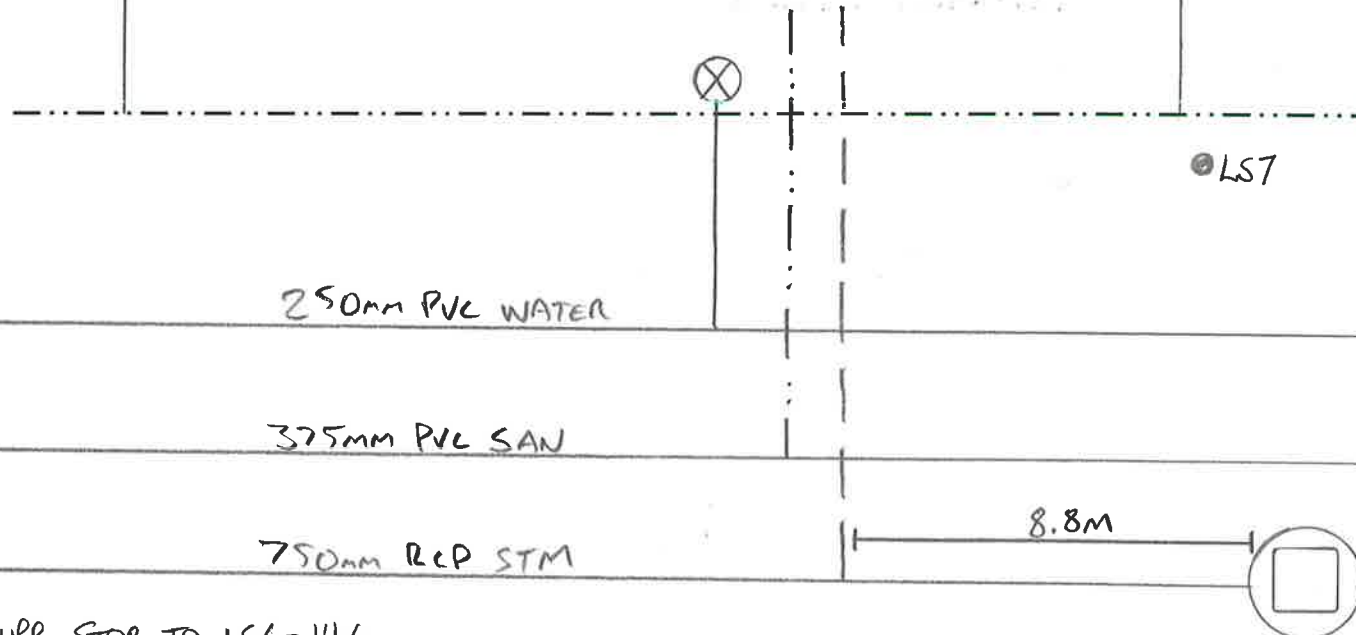

CURB STOP TO LS6 = 14.6m
 CURB STOP TO LS7 = 23.1m
 CORP. STOP TO LS6 = 7.6m
 CORP. STOP TO LS7 = 23.0m

LS6

MHT5



SEE REVERSE FOR DETAILS →



HALIFAX REGIONAL WATER COMMISSION

SERVICE CONNECTION CARD

STREET Brunelco Blvd

LOT 210 CIVIC _____

HRM SUBDIVISION #: _____

PERMIT #: _____

SLID _____

PUBLIC

	WATER	SANITARY	STORM
LENGTH:	6.98m	8.20m	9.82m
MATERIAL:	MUNICIPAL	PVC DR28	PVC DR35
SIZE:	25mm	125mm	100mm
COLOUR:	BLUE	WHITE	GREEN
DEPTH @ MAIN:	2.0m	3.0m	3.1m
DEPTH @ ST. LINE:	1.9m	2.4m	2.45m
T.O.P. ELEV. @ MAIN:	93.1m	92.1m	92.0m
T.O.P. ELEV. @ ST. LINE:	93.17m	92.7m	92.65m
MAIN SIZE:	250mm	375mm	750mm
CURB STOP TO ST. LINE*:	0.65m		
ST. LINE TO STUB*:		2.36m	2.38m

*IF APPLICABLE

CONTRACTOR: Dexter Construction
 INSPECTED BY: WSP
 DATE: APRIL 2018
 RECORD DWG. #: 121-24187 SHEET 2

INSULATION:	<input checked="" type="checkbox"/> YES	<input type="checkbox"/> NO
ROCK:	<input checked="" type="checkbox"/> YES	<input type="checkbox"/> NO
CLAY PLUG:	<input type="checkbox"/> YES	<input checked="" type="checkbox"/> NO
TRACE WIRE:	<input checked="" type="checkbox"/> YES	<input type="checkbox"/> NO
ANODE:	<input checked="" type="checkbox"/> YES	<input type="checkbox"/> NO
DRIVEWAY CULVERT	<input type="checkbox"/> YES	<input checked="" type="checkbox"/> NO
PRE-CAST HEADWALLS	<input type="checkbox"/> YES	<input checked="" type="checkbox"/> NO

DRIVEWAY CULVERT SIZE _____
 MATERIAL _____

ADDITIONAL NOTES & COMMENTS:

PRIVATE

	WATER	SANITARY	STORM
LENGTH:			
MATERIAL:			
SIZE:			
COLOUR:			
DEPTH @ BLDG:			

CONTRACTOR: _____
 INSPECTED BY: _____
 DATE: _____

INSULATION:	<input type="checkbox"/> YES	<input type="checkbox"/> NO
ROCK:	<input type="checkbox"/> YES	<input type="checkbox"/> NO
CLAY PLUG:	<input type="checkbox"/> YES	<input type="checkbox"/> NO
TRACE WIRE:	<input type="checkbox"/> YES	<input type="checkbox"/> NO
SOUND CHECK:	<input type="checkbox"/> YES	<input type="checkbox"/> NO

FOUNDATION DRAIN CONNECTED:	<input type="checkbox"/> YES	<input type="checkbox"/> NO
RAIN LEADERS CONNECTED:	<input type="checkbox"/> YES	<input type="checkbox"/> NO
SANITARY TYPE:	<input type="checkbox"/> PRESSURE	<input type="checkbox"/> GRAVITY

PRIVATE LIFT STATION INFO: LIFT: _____
 DISTANCE: _____

ADDITIONAL NOTES & COMMENTS:



HALIFAX REGIONAL WATER COMMISSION

SERVICE CONNECTION CARD

STREET BRUNELLO BLVD

LOT 210 CIVIC _____

LOT 211

LOT 210

LOT 209

PRIVATE

• 250mm PVC WATER
 • 375mm PVC SAN
 • 750mm RCP STM
 • 21.9m
 • LSS
 • LSG
 • CURB STOP
 • CORP. STOP


● LSS

250mm PVC WATER

375mm PVC SAN

750mm RCP STM

21.9m

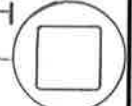

MHT5

- CURB STOP TO LSS = 10.3m
- CURB STOP TO LSG = 17.3m
- CORP. STOP TO LSS = 10.4m
- CORP. STOP TO LSG = 11.9m

● LSG



PUBLIC

SEE REVERSE FOR DETAILS →



HALIFAX REGIONAL WATER COMMISSION

SERVICE CONNECTION CARD

STREET BROWNELL BLVD

LOT 211 CIVIC _____

LOT 212

LOT 211

LOT 210

PRIVATE

Faint handwritten notes, possibly describing property details or survey information.




LS5

250mm PVC WATER

15.0M

375mm PVC SAN

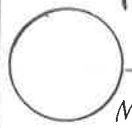

MHS6

750mm RCP STM

PUBLIC

- CURB STOP TO LS4 = 27.1m
- CURB STOP TO LS5 = 4.1m
- CORP. STOP TO LS4 = 24.2m
- CORP. STOP TO LS5 = 4.4m

LS4



SEE REVERSE FOR DETAILS →



HALIFAX REGIONAL WATER COMMISSION
SERVICE CONNECTION CARD

STREET Brunelld Blvd

LOT 212 CIVIC _____


LOT 213

LOT 212

LOT 211

PRIVATE

PUBLIC

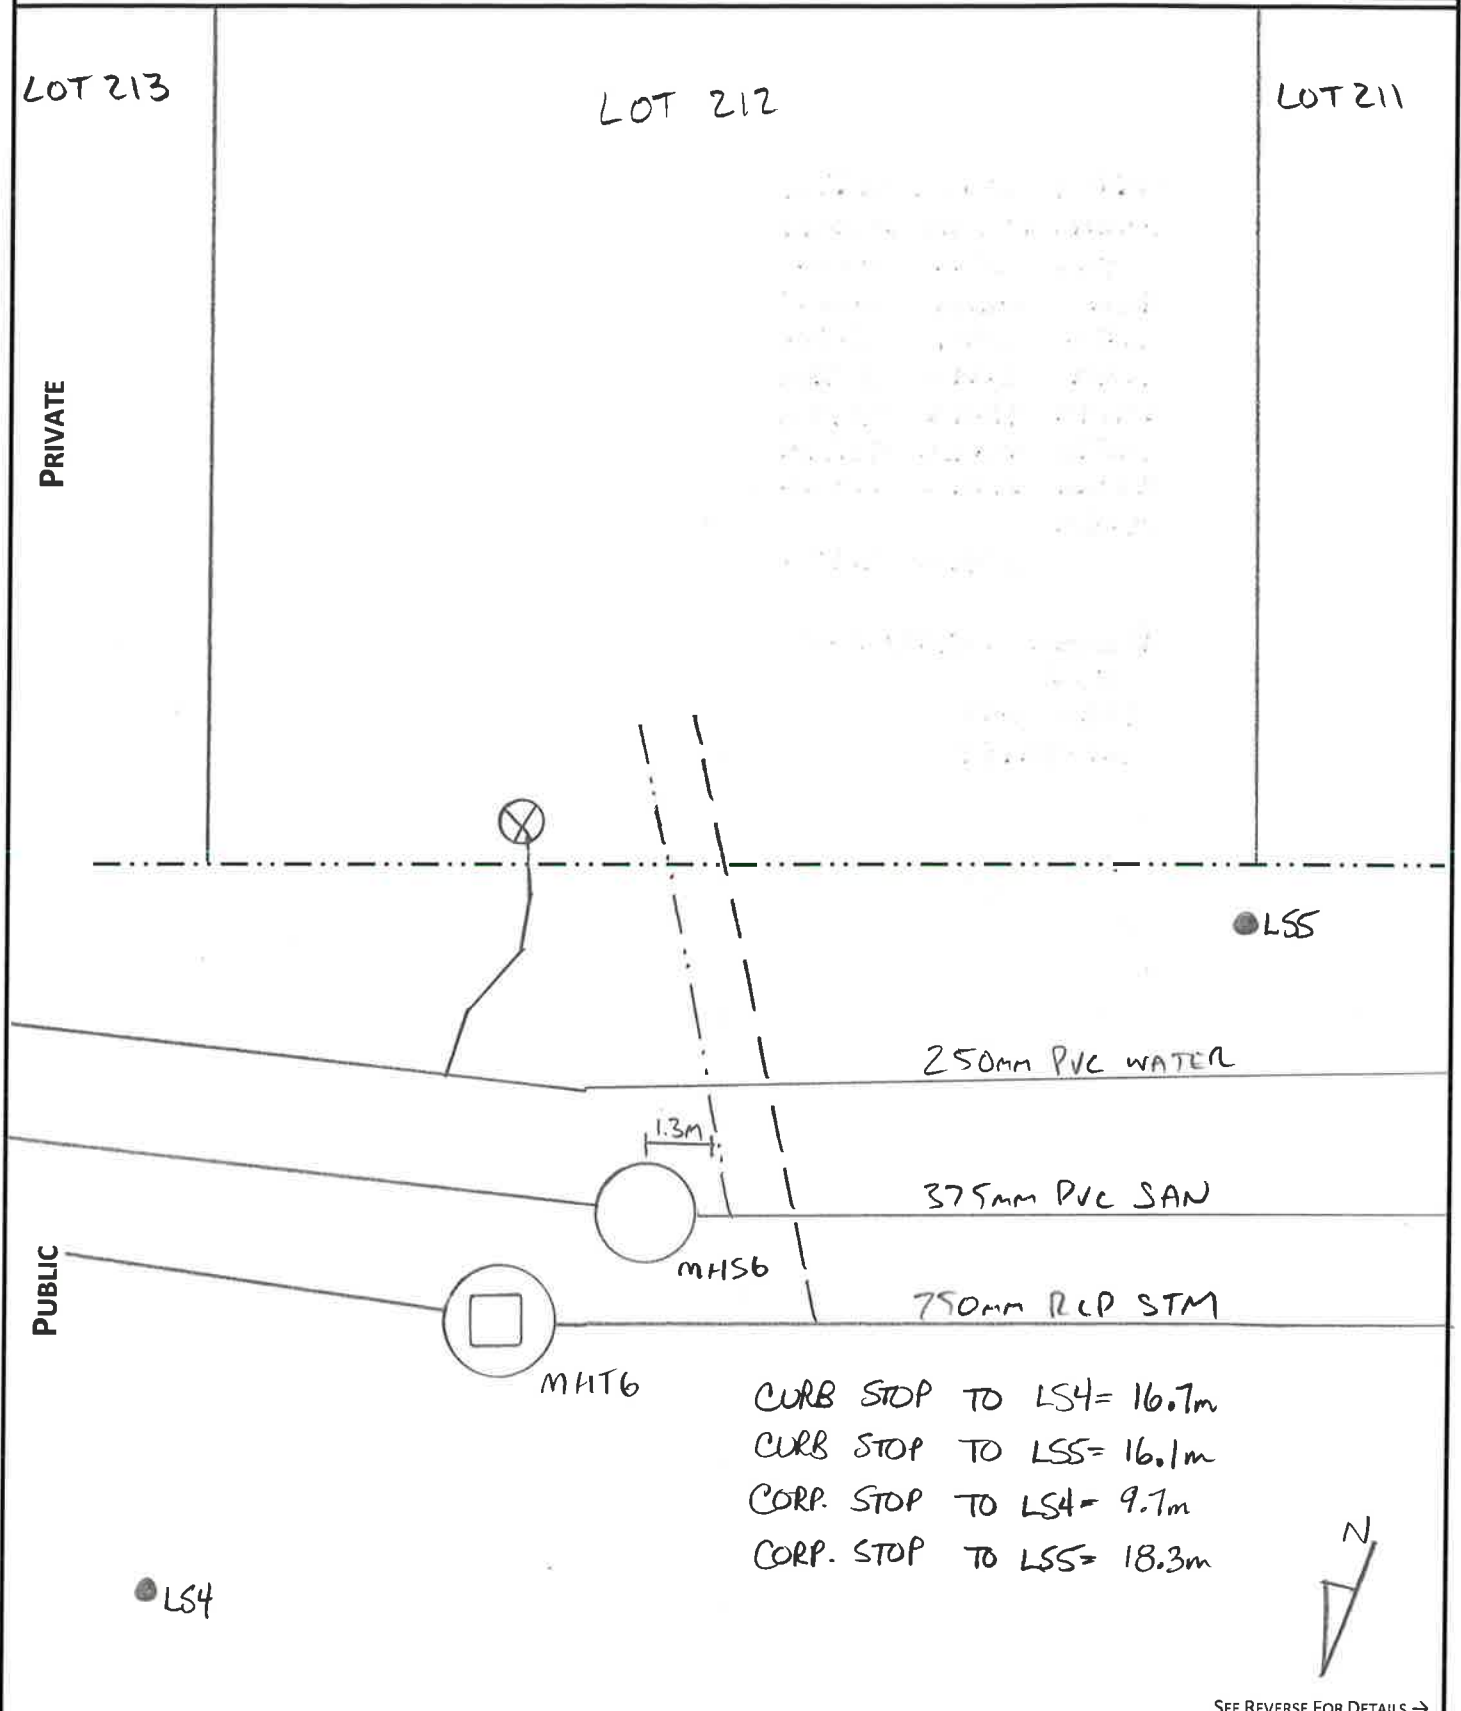

CURB STOP TO LS4 = 16.7m
 CURB STOP TO LSS = 16.1m
 CORP. STOP TO LS4 = 9.7m
 CORP. STOP TO LSS = 18.3m

● LS4

● LSS



SEE REVERSE FOR DETAILS →



HALIFAX REGIONAL WATER COMMISSION
SERVICE CONNECTION CARD

STREET BRUNELLO BLVD
 LOT 213 CIVIC _____

LOT 214

LOT 213

LOT 212

PRIVATE

[Faint handwritten notes in the center of the plan, likely describing utility details or site conditions.]

● LS3

250mm PVC WATER

375mm PVC SAN

750mm RCP STM

15.5M

MHS6

PUBLIC

CURB STOP TO LS3 = 15.6m
 CURB STOP TO LS4 = 16.4m
 CORP STOP TO LS3 = 13.9m
 CORP STOP TO LS4 = 13.0m



SEE REVERSE FOR DETAILS →



HALIFAX REGIONAL WATER COMMISSION

SERVICE CONNECTION CARD

STREET BAUNELLO BLVD

LOT 214 CIVIC _____

LOT 215

LOT 214

LOT 213

PRIVATE

[Faint handwritten notes in the center of the lot, possibly describing property details or survey information.]



LS3 ●

250mm PVC WATER

13.1m

375mm PVC SAN

750mm RCP STM



MHS7

PUBLIC

CURB STOP TO LS3 = 3.8m

CURB STOP TO LS4 = 27.0m

CORP. STOP TO LS3 = 30.0m

CORP. STOP TO LS4 = 24.2m



SEE REVERSE FOR DETAILS →



HALIFAX REGIONAL WATER COMMISSION

SERVICE CONNECTION CARD

STREET BRUNELLO BLVD
 LOT 215 CIVIC _____

HRM SUBDIVISION #: _____

PERMIT #: _____

SLID _____

PUBLIC

	WATER	SANITARY	STORM
LENGTH:	7.83M	9.05M	10.40M
MATERIAL:	MUNICIPAL	PVC D228	PVC D235
SIZE:	25mm	125mm	100mm
COLOUR:	BLUE	WHITE	GREEN
DEPTH @ MAIN:	2.1m	3.2m	3.5m
DEPTH @ ST. LINE:	1.88m	2.45m	2.47m
T.O.P. ELEV. @ MAIN:	97.0m	95.9m	95.6m
T.O.P. ELEV. @ ST. LINE:	97.32m	96.75m	96.73m
MAIN SIZE:	250mm	375mm	750mm
CURB STOP TO ST. LINE*:	0.86m		
ST. LINE TO STUB*:		2.72m	3.10m

*IF APPLICABLE

CONTRACTOR: DEATER CONSTRUCTION
 INSPECTED BY: NSP
 DATE: APRIL 2018
 RECORD DWG. #: RI-24187 SHEET 2

INSULATION: YES NO
 ROCK: YES NO
 CLAY PLUG: YES NO
 TRACE WIRE: YES NO
 ANODE: YES NO
 DRIVEWAY CULVERT: YES NO
 PRE-CAST HEADWALLS: YES NO

DRIVEWAY CULVERT SIZE MATERIAL

ADDITIONAL NOTES & COMMENTS:

PRIVATE

WATER	SANITARY	STORM

LENGTH: _____
 MATERIAL: _____
 SIZE: _____
 COLOUR: _____
 DEPTH @ BLDG: _____
 CONTRACTOR: _____
 INSPECTED BY: _____
 DATE: _____

INSULATION: YES NO
 ROCK: YES NO
 CLAY PLUG: YES NO
 TRACE WIRE: YES NO
 SOUND CHECK: YES NO

FOUNDATION DRAIN CONNECTED: YES NO
 RAIN LEADERS CONNECTED: YES NO
 SANITARY TYPE: PRESSURE GRAVITY

PRIVATE LIFT STATION INFO: LIFT: _____
 DISTANCE: _____

ADDITIONAL NOTES & COMMENTS:



HALIFAX REGIONAL WATER COMMISSION
SERVICE CONNECTION CARD

STREET Brunello Blvd


LOT 215 CIVIC _____

LOT 215

LOT 214

PRIVATE

PUBLIC

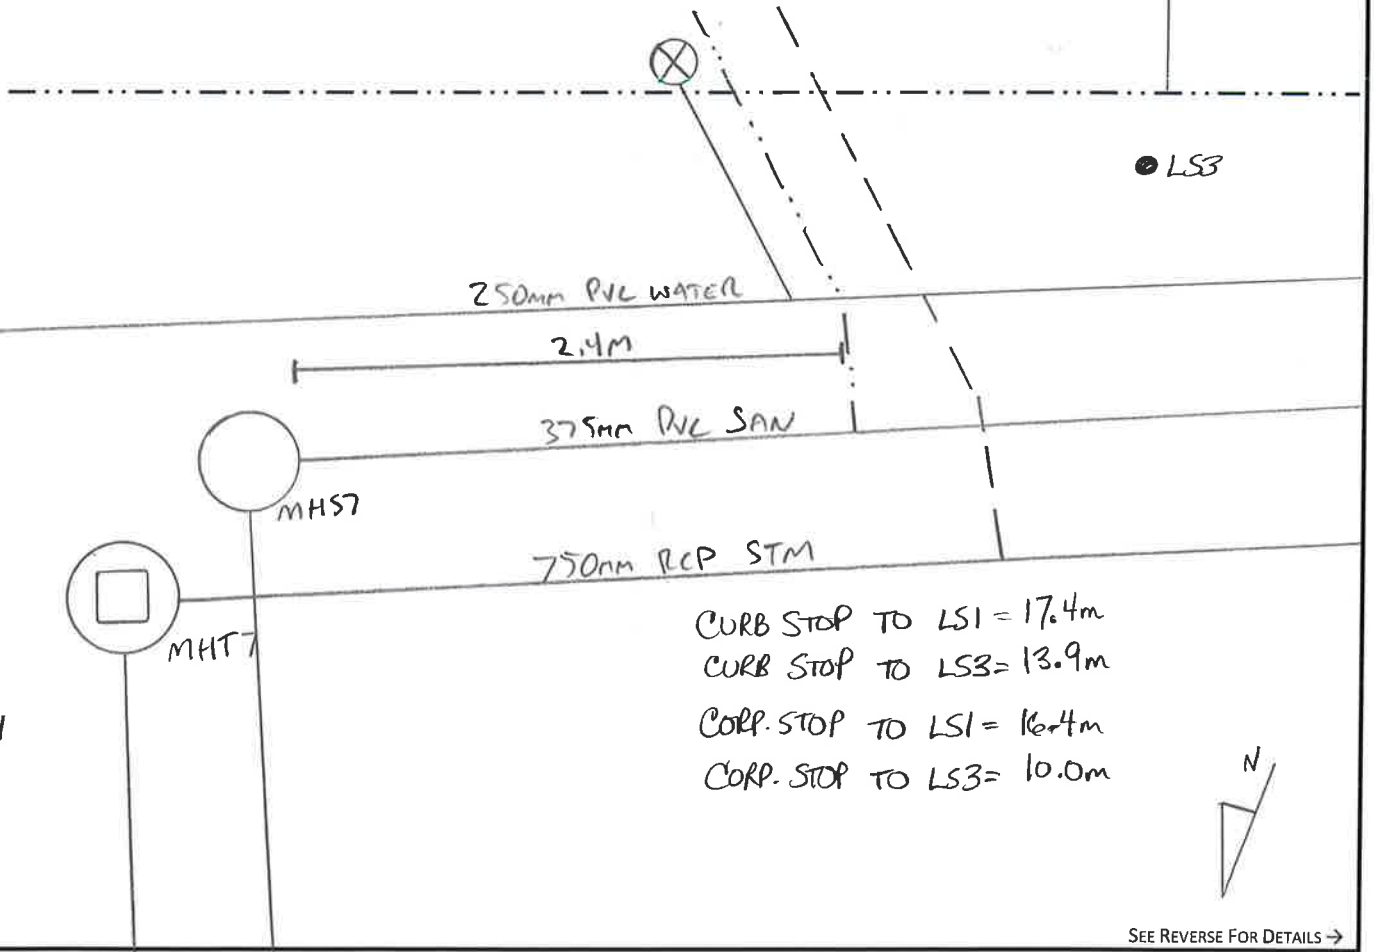

CURB STOP TO LSI = 17.4m
 CURB STOP TO LSB = 13.9m
 CORP. STOP TO LSI = 16.4m
 CORP. STOP TO LSB = 10.0m

SEE REVERSE FOR DETAILS →



HALIFAX REGIONAL WATER COMMISSION

SERVICE CONNECTION CARD

STREET Brunello Bwn

LOT 216 CIVIC _____

HRM SUBDIVISION #: _____

PERMIT #: _____

SLID _____

PUBLIC

	WATER	SANITARY	STORM
LENGTH:	10.07m	7.0m	8.75m
MATERIAL:	Municipal	PVC D. 28	PVC D. 35
SIZE:	25mm	125mm	100mm
COLOUR:	Blue	White	Green
DEPTH @ MAIN:	2.3m	3.1m	3.8m
DEPTH @ ST. LINE:	1.8m	2.44m	2.38m
T.O.P. ELEV. @ MAIN:	88.15m	87.3m	87.2m
T.O.P. ELEV. @ ST. LINE:	88.74m	88.10m	88.16m
MAIN SIZE:	250mm	375mm	250mm
CURB STOP TO ST. LINE*:	0.51m		
ST. LINE TO STUB*:		2.37m	2.31m

*IF APPLICABLE

CONTRACTOR: Dexter Construction
 INSPECTED BY: WSP
 DATE: April 2018
 RECORD DWG. #: 121-24187 Sheet 2

- INSULATION: YES NO
- ROCK: YES NO
- CLAY PLUG: YES NO
- TRACE WIRE: YES NO
- ANODE: YES NO
- DRIVEWAY CULVERT: YES NO
- PRE-CAST HEADWALLS: YES NO

DRIVEWAY CULVERT SIZE MATERIAL

ADDITIONAL NOTES & COMMENTS:

PRIVATE

WATER	SANITARY	STORM

LENGTH: _____
 MATERIAL: _____
 SIZE: _____
 COLOUR: _____
 DEPTH @ BLDG: _____
 CONTRACTOR: _____
 INSPECTED BY: _____
 DATE: _____


- INSULATION: YES NO
- ROCK: YES NO
- CLAY PLUG: YES NO
- TRACE WIRE: YES NO
- SOUND CHECK: YES NO
- FOUNDATION DRAIN CONNECTED: YES NO
- RAIN LEADERS CONNECTED: YES NO
- SANITARY TYPE: PRESSURE GRAVITY
- PRIVATE LIFT STATION INFO: LIFT: _____
 DISTANCE: _____

ADDITIONAL NOTES & COMMENTS:



HALIFAX REGIONAL WATER COMMISSION
SERVICE CONNECTION CARD

STREET BRUNELLO BLVD
 LOT 216 CIVIC _____

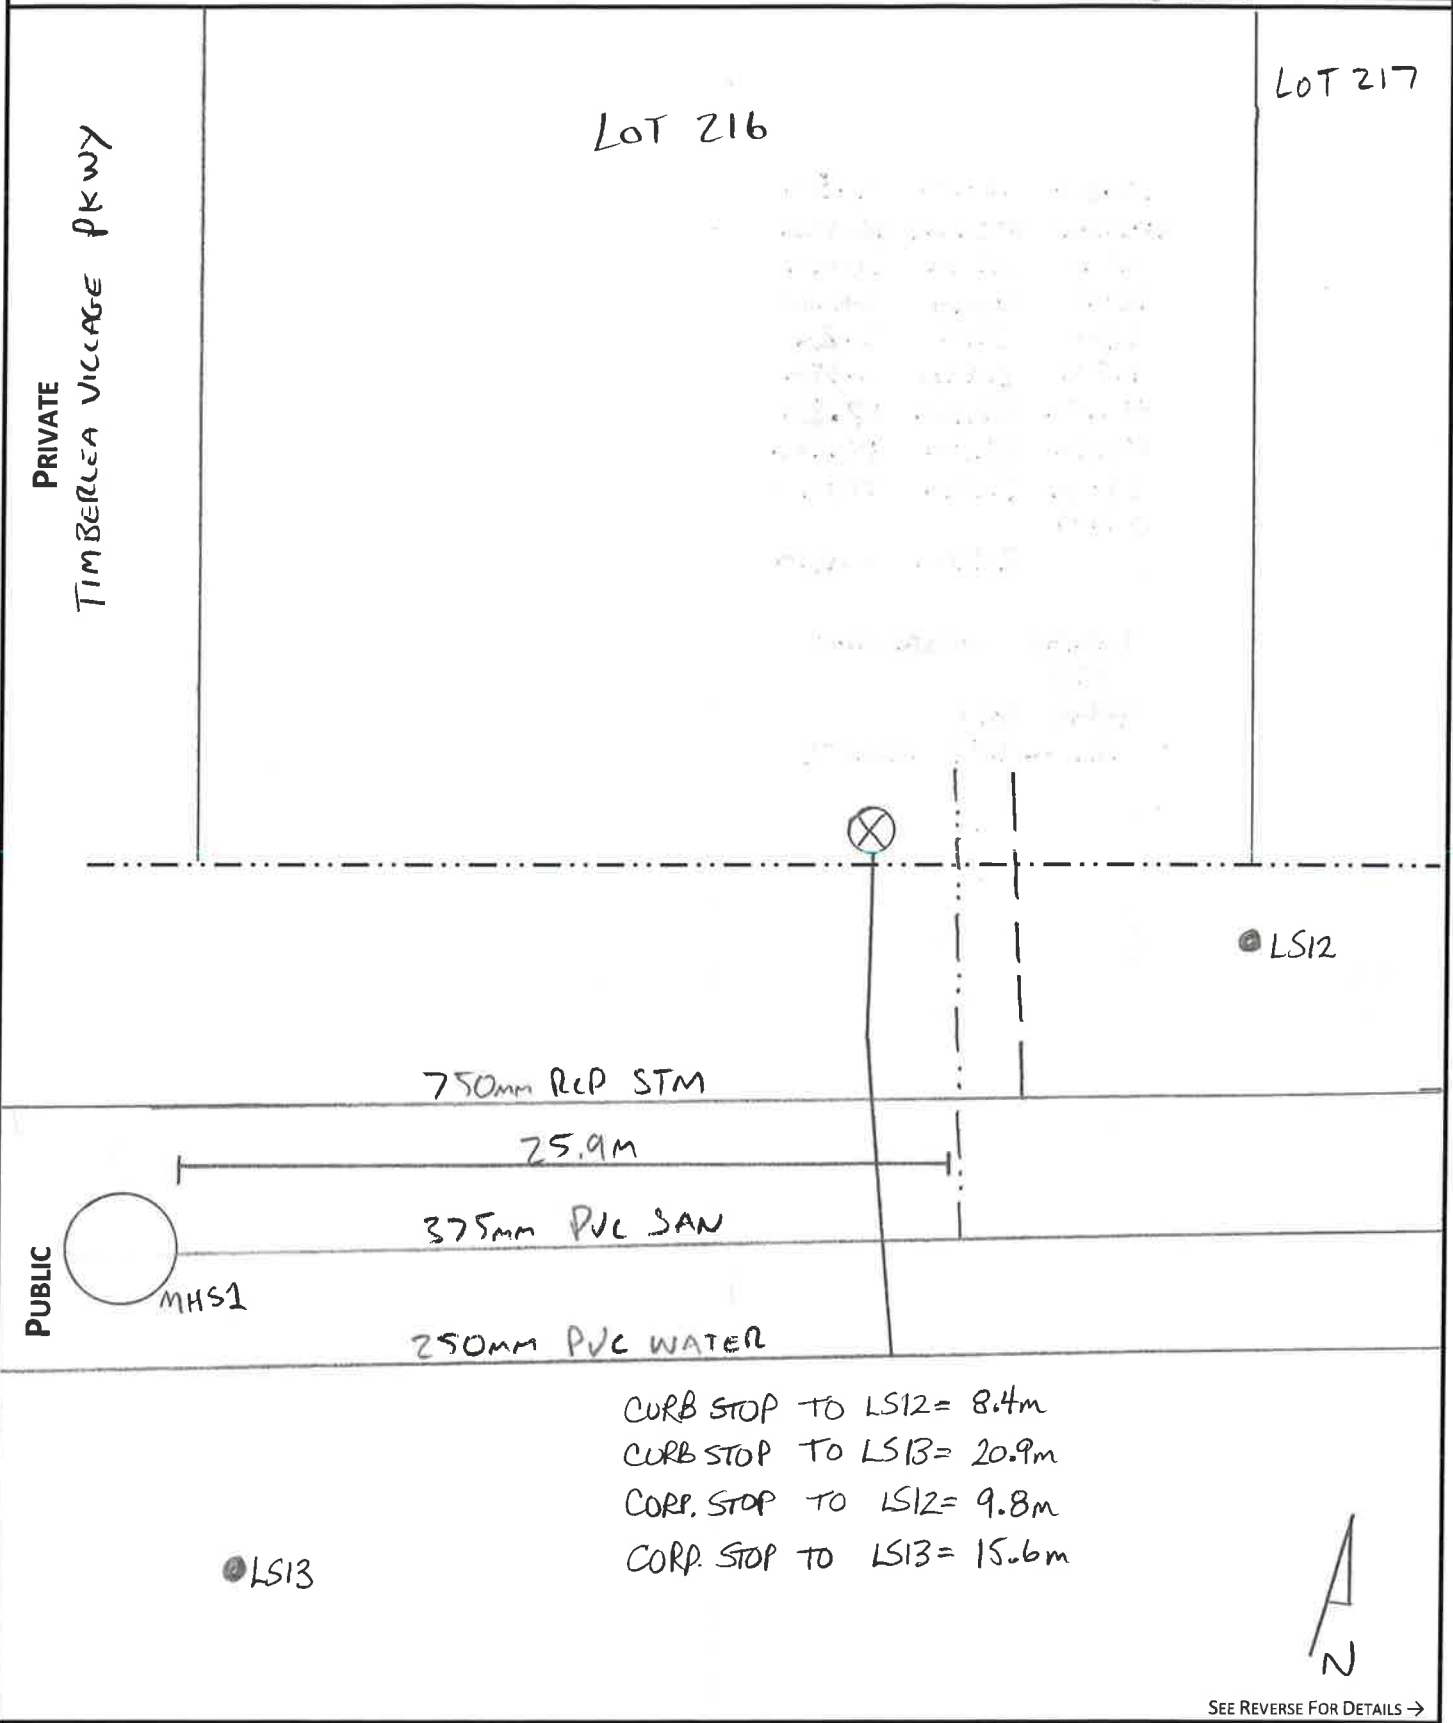

SEE REVERSE FOR DETAILS →



HALIFAX REGIONAL WATER COMMISSION
SERVICE CONNECTION CARD

STREET BRUNETTO BLVD
 LOT 217 CIVIC _____

LOT 216

LOT 217

LOT 218

PRIVATE

[Faint, illegible handwritten notes in the background of Lot 217]

LS12 ●

750mm RCP STM

375mm PVC SAN

250mm PVC WATER

27.3m



PUBLIC

CURB STOP TO LS11 = 22.0m
 CURB STOP TO LS12 = 7.8m
 CORP. STOP TO LS11 = 19.5m
 CORP. STOP TO LS12 = 27.7m



SEE REVERSE FOR DETAILS →



HALIFAX REGIONAL WATER COMMISSION
SERVICE CONNECTION CARD

STREET BRUNELLO BLVD

LOT 218 CIVIC _____

LOT 217

LOT 218

LOT 219

PRIVATE

PUBLIC

● LS12


750mm RCP STM

375mm PVC SAN

250mm PVC WATER



15.6m

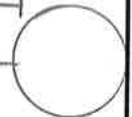

MHS3

CURB STOP TO LS11 = 15.9m
 CURB STOP TO LS12 = 18.8m
 CORP. STOP TO LS11 = 8.4m
 CORP. STOP TO LS12 = 18.0m

● LS11



SEE REVERSE FOR DETAILS →



HALIFAX REGIONAL WATER COMMISSION
SERVICE CONNECTION CARD

STREET BROWNELL BLVD

LOT 219 CIVIC _____

LOT 218


LOT 219

LOT 220

PRIVATE

[Faint, illegible text, likely a site plan or survey drawing]

PUBLIC

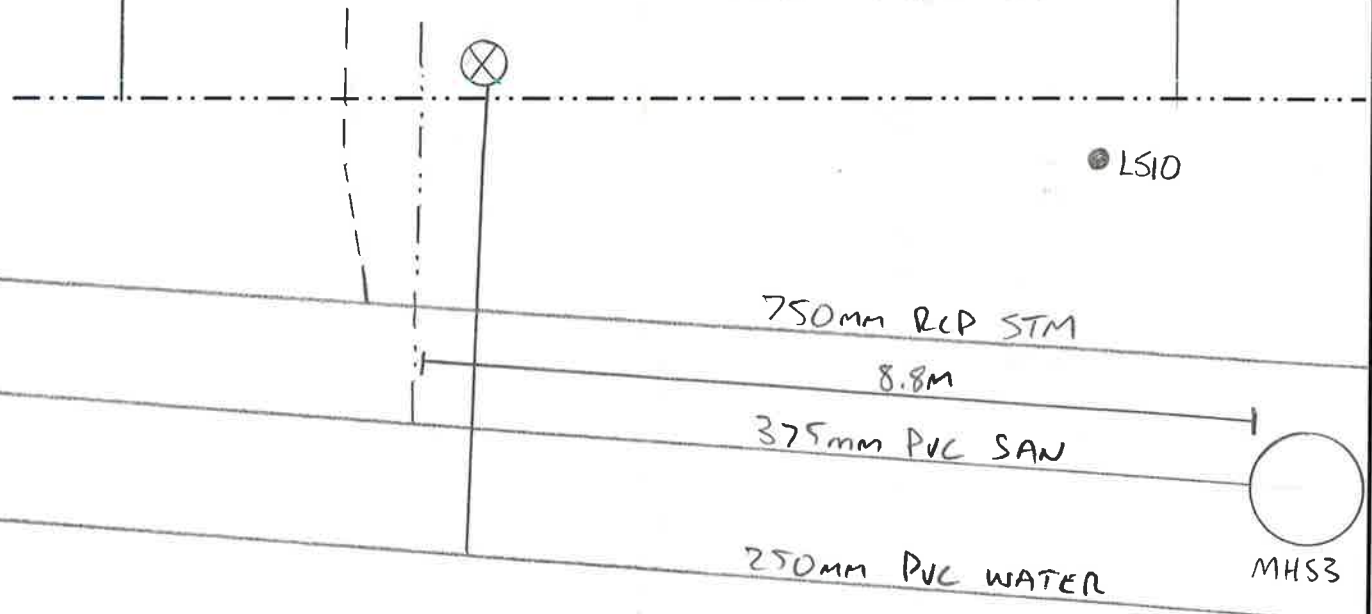

CURB STOP TO LS10 = 16.1m
 CURB STOP TO LS11 = 16.0m
 CORP. STOP TO LS10 = 18.9m
 CORP. STOP TO LS11 = 6.2m

LS11



SEE REVERSE FOR DETAILS →



HALIFAX REGIONAL WATER COMMISSION
SERVICE CONNECTION CARD

STREET BRUNELLO BLVD
 LOT 220 CIVIC _____


LOT 219

LOT 220

LOT 221

PRIVATE

[Faint, illegible handwritten notes in the center of the lot]

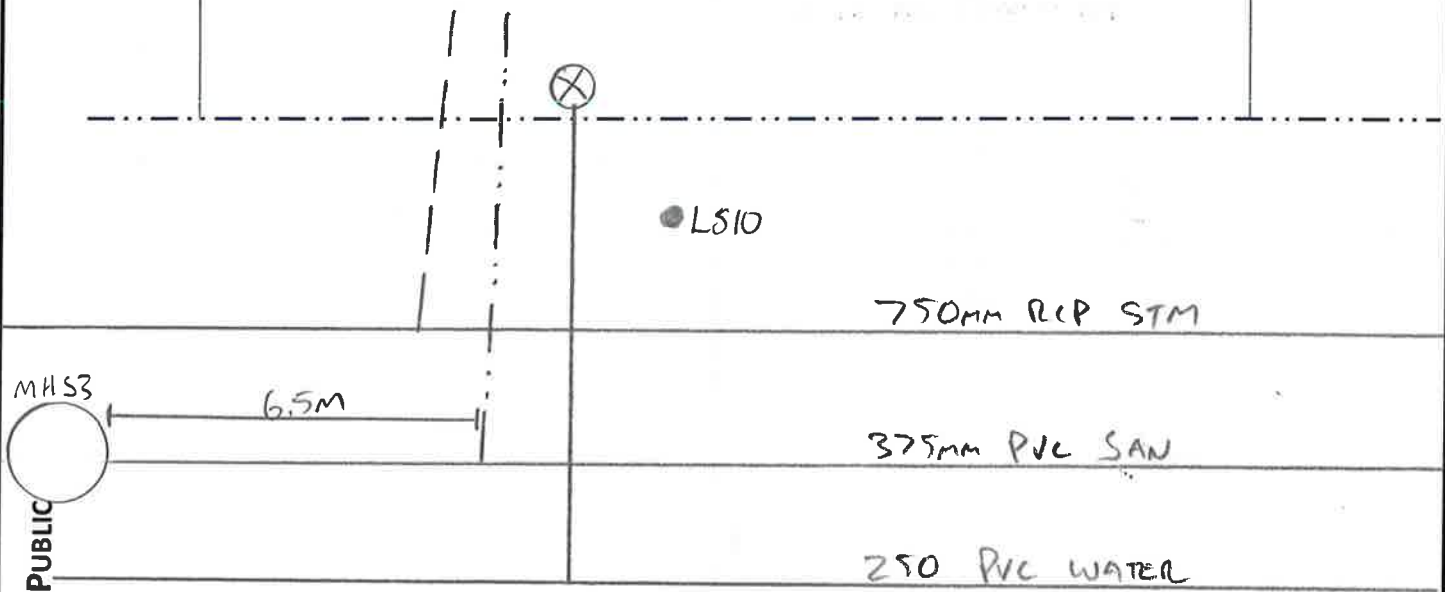

MHS3
 PUBLIC

6.5M

750mm RCP STM

375mm PVC SAN

250 PVC WATER

CURB STOP TO LS10 = 3.7m
 CURB STOP TO LS11 = 24.8m
 CORP. STOP TO LS10 = 6.7m
 CORP. STOP TO LS11 = 21.0m

LS11



SEE REVERSE FOR DETAILS →



HALIFAX REGIONAL WATER COMMISSION
SERVICE CONNECTION CARD

STREET BARNELLO BLVD

LOT 221 CIVIC _____

LOT 220

LOT 221

LOT 222

PRIVATE

● LS10

750mm RCP STM

23.4m

375mm PVC SAN

250mm PVC WATER

MHS3

PUBLIC

CURB STOP TO LS9 = 17.0m
 CURB STOP TO LS10 = 15.6m
 CORP. STOP TO LS9 = 9.3m
 CORP. STOP TO LS10 = 18.0m

● LS9



SEE REVERSE FOR DETAILS →



HALIFAX REGIONAL WATER COMMISSION
SERVICE CONNECTION CARD

STREET BONNELLO BLVD

LOT 222 CIVIC _____


LOT 221

LOT 222

LOT 223

PRIVATE

PUBLIC

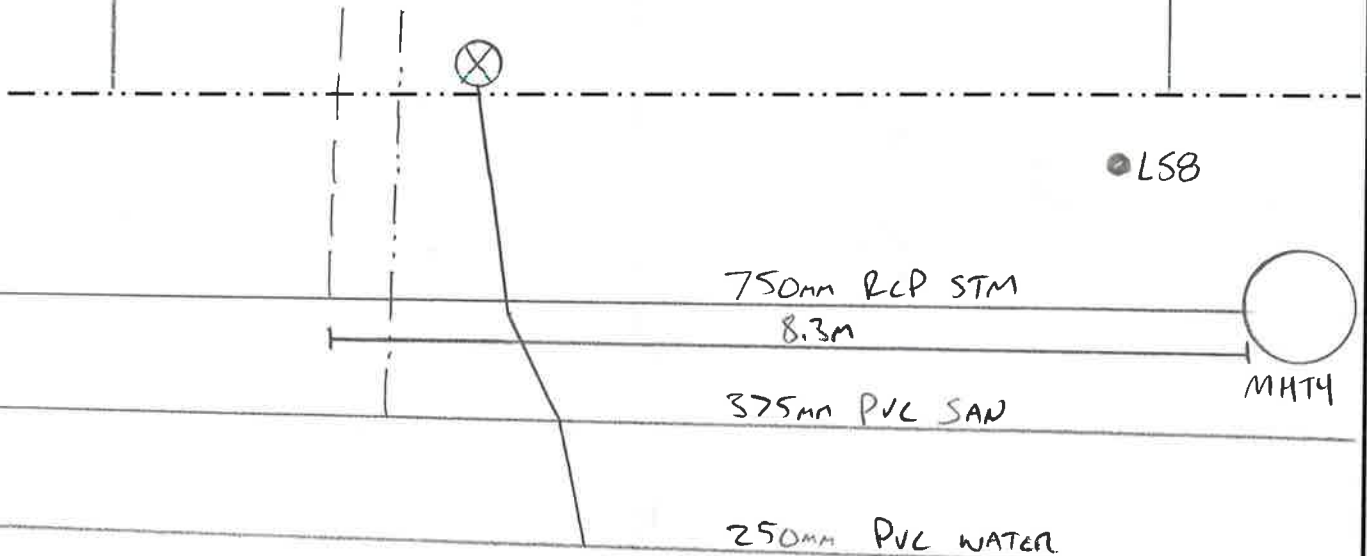

CURB STOP TO LSB = 18.1m
 CURB STOP TO LS9 = 15.1m
 CORP. STOP TO LSB = 19.1m
 CORP. STOP TO LS9 = 6.6m

LS9



SEE REVERSE FOR DETAILS →



HALIFAX REGIONAL WATER COMMISSION

SERVICE CONNECTION CARD

STREET BRUNELLO BLVD
 LOT 223 CIVIC _____

HRM SUBDIVISION #: _____

PERMIT #: _____

SLID _____

PUBLIC

	WATER	SANITARY	STORM
LENGTH:	9.83M	8.05M	6.24M
MATERIAL:	Mawc/Dex	Poc On 28	Poc On 35
SIZE:	25mm	125mm	100mm
COLOUR:	Blue	White	Green
DEPTH @ MAIN:	1.9M	2.8M	3.1M
DEPTH @ ST. LINE:	1.77M	2.24M	2.29M
T.O.P. ELEV. @ MAIN:	89.5M	88.6M	88.3M
T.O.P. ELEV. @ ST. LINE:	89.63M	89.16M	89.11M
MAIN SIZE:	250mm	375mm	750mm
CURB STOP TO ST. LINE*:	0.58M		
ST. LINE TO STUB*:		1.90M	1.97M

*IF APPLICABLE

CONTRACTOR:

Dexter Construction

INSPECTED BY:

WSP

DATE:

APRIL 2018

RECORD DWG. #:

121-24187 SHEET 2

INSULATION:

<input checked="" type="checkbox"/>	YES	<input type="checkbox"/>	NO
<input checked="" type="checkbox"/>	YES	<input type="checkbox"/>	NO
<input type="checkbox"/>	YES	<input checked="" type="checkbox"/>	NO
<input checked="" type="checkbox"/>	YES	<input type="checkbox"/>	NO
<input checked="" type="checkbox"/>	YES	<input type="checkbox"/>	NO
<input type="checkbox"/>	YES	<input checked="" type="checkbox"/>	NO
<input type="checkbox"/>	YES	<input checked="" type="checkbox"/>	NO

DRIVEWAY CULVERT

SIZE
MATERIAL

ADDITIONAL NOTES & COMMENTS:

PRIVATE

WATER	SANITARY	STORM

LENGTH:

MATERIAL:

SIZE:

COLOUR:

DEPTH @ BLDG:

CONTRACTOR:

INSPECTED BY:

DATE:

INSULATION:

ROCK:

CLAY PLUG:

TRACE WIRE:

SOUND CHECK:

FOUNDATION DRAIN CONNECTED:

RAIN LEADERS CONNECTED:

SANITARY TYPE:

PRIVATE LIFT STATION INFO:

<input type="checkbox"/>	YES	<input type="checkbox"/>	NO
<input type="checkbox"/>	YES	<input type="checkbox"/>	NO
<input type="checkbox"/>	PRESSURE	<input type="checkbox"/>	GRAVITY

LIFT:

DISTANCE:

ADDITIONAL NOTES & COMMENTS:



HALIFAX REGIONAL WATER COMMISSION
SERVICE CONNECTION CARD

STREET BRUNELLO BLVD


LOT 223 CIVIC _____

LOT 222

LOT 223

LOT 224

PRIVATE

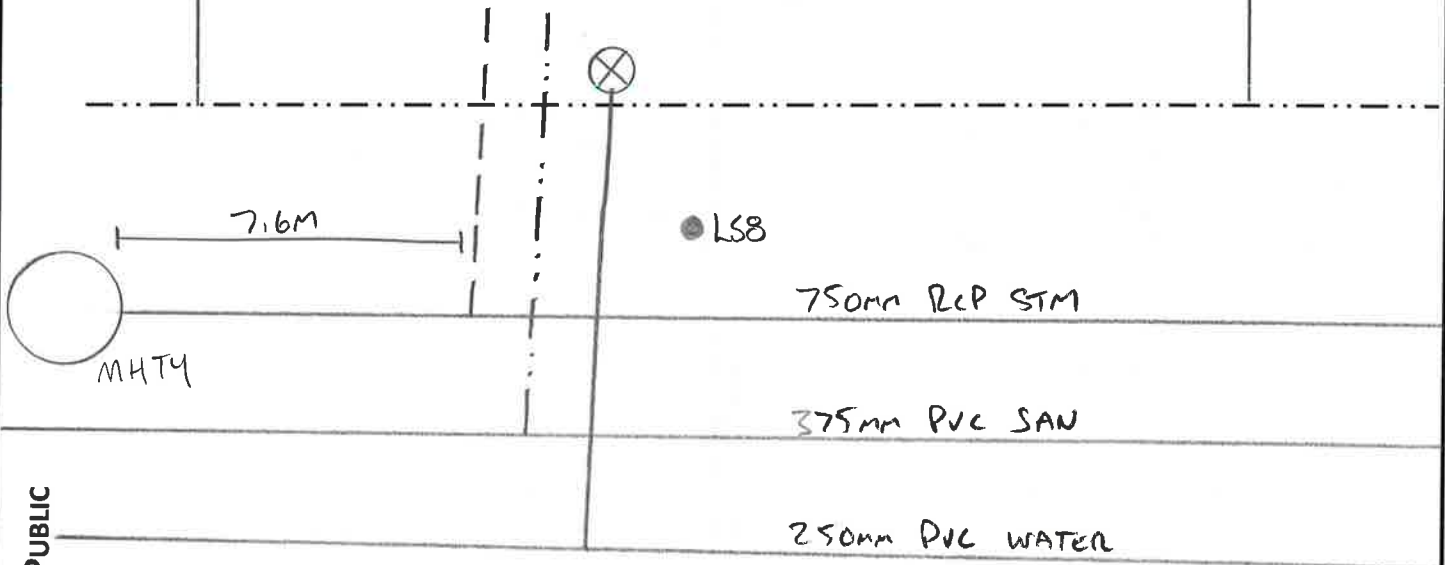

PUBLIC

CURB STOP TO LS8 = 3.8m
 CURB STOP TO LS9 = 25.4m
 CORP. STOP TO LS8 = 6.3m
 CORP. STOP TO LS9 = 23.9m

● LS9



SEE REVERSE FOR DETAILS →



HALIFAX REGIONAL WATER COMMISSION
SERVICE CONNECTION CARD

STREET BRWELLO BLVD


LOT 224 CIVIC _____

LOT 223

LOT 224

LOT 225

PRIVATE

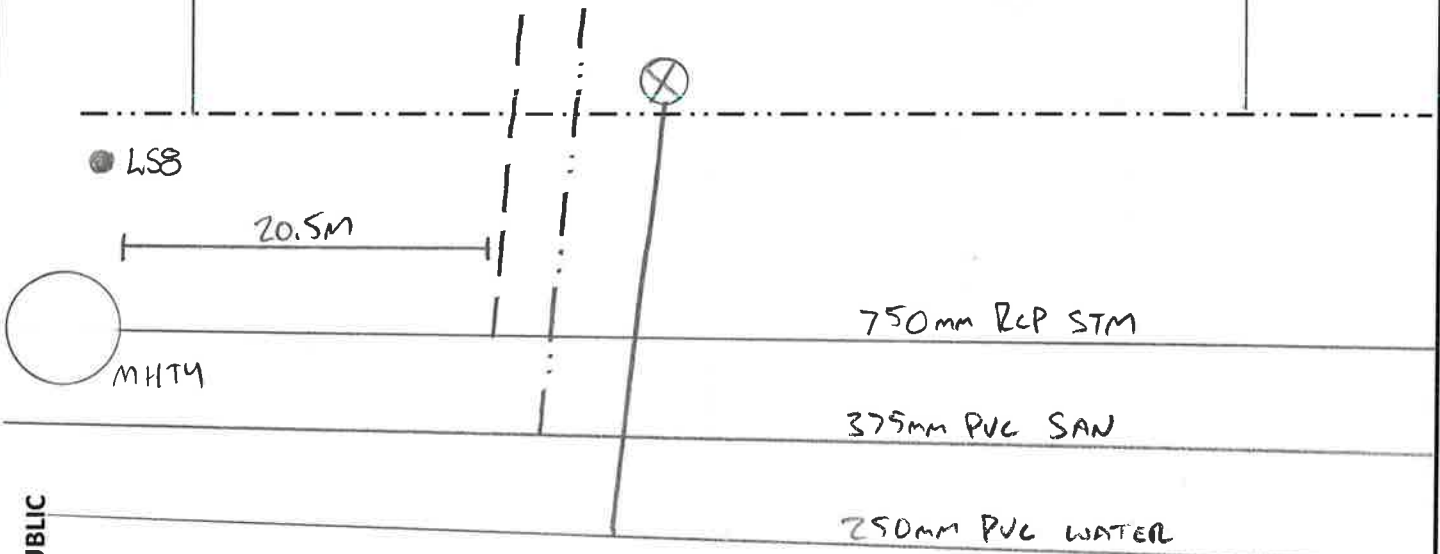

PUBLIC

CURB STOP TO LST = 16.9m
 CURB STOP TO LSS = 12.4m
 CORP. STOP TO LST = 9.6m
 CORP. STOP TO LSS = 14.2m

● LST



SEE REVERSE FOR DETAILS →



HALIFAX REGIONAL WATER COMMISSION

SERVICE CONNECTION CARD

STREET Brunswick Blvd
 LOT 225 CIVIC _____

HRM SUBDIVISION #: _____

PERMIT #: _____

SLID _____

PUBLIC

	WATER	SANITARY	STORM
LENGTH:	9.42m	8.20m	6.47m
MATERIAL:	MUNICIPAL	PVC DR28	PVC DR35
SIZE:	25mm	125mm	100mm
COLOUR:	Blue	White	Green
DEPTH @ MAIN:	1.73m	2.5m	2.6m
DEPTH @ ST. LINE:	1.85m	2.27m	2.26m
T.O.P. ELEV. @ MAIN:	90.7m	89.9m	89.8m
T.O.P. ELEV. @ ST. LINE:	90.75m	90.33m	90.34m
MAIN SIZE:	250mm	375mm	750mm
CURB STOP TO ST. LINE*:	0.56m		
ST. LINE TO STUB*:		2.35m	2.41m

*IF APPLICABLE

CONTRACTOR: DEATER CONSTRUCTION
 INSPECTED BY: WSP
 DATE: APRIL 2018
 RECORD DWG. #: 121-24187 SHEET 2

INSULATION:

<input checked="" type="checkbox"/>	YES	<input type="checkbox"/>	NO
<input checked="" type="checkbox"/>	YES	<input type="checkbox"/>	NO
<input type="checkbox"/>	YES	<input checked="" type="checkbox"/>	NO
<input checked="" type="checkbox"/>	YES	<input type="checkbox"/>	NO
<input checked="" type="checkbox"/>	YES	<input type="checkbox"/>	NO
<input type="checkbox"/>	YES	<input checked="" type="checkbox"/>	NO
<input type="checkbox"/>	YES	<input checked="" type="checkbox"/>	NO

DRIVEWAY CULVERT

SIZE
MATERIAL

ADDITIONAL NOTES & COMMENTS:

PRIVATE

WATER	SANITARY	STORM

LENGTH:

MATERIAL:

SIZE:

COLOUR:

DEPTH @ BLDG:

CONTRACTOR:

INSPECTED BY:

DATE:

INSULATION:

ROCK:

CLAY PLUG:

TRACE WIRE:

SOUND CHECK:

FOUNDATION DRAIN CONNECTED:

RAIN LEADERS CONNECTED:

SANITARY TYPE:

PRIVATE LIFT STATION INFO:

<input type="checkbox"/>	YES	<input type="checkbox"/>	NO
<input type="checkbox"/>	YES	<input type="checkbox"/>	NO
<input type="checkbox"/>	PRESSURE	<input type="checkbox"/>	GRAVITY

LIFT: _____
 DISTANCE: _____

ADDITIONAL NOTES & COMMENTS:



HALIFAX REGIONAL WATER COMMISSION
SERVICE CONNECTION CARD

STREET BRINELLO BLVD

LOT 225 CIVIC _____


LOT 224

LOT 225

LOT 226

PRIVATE

PUBLIC

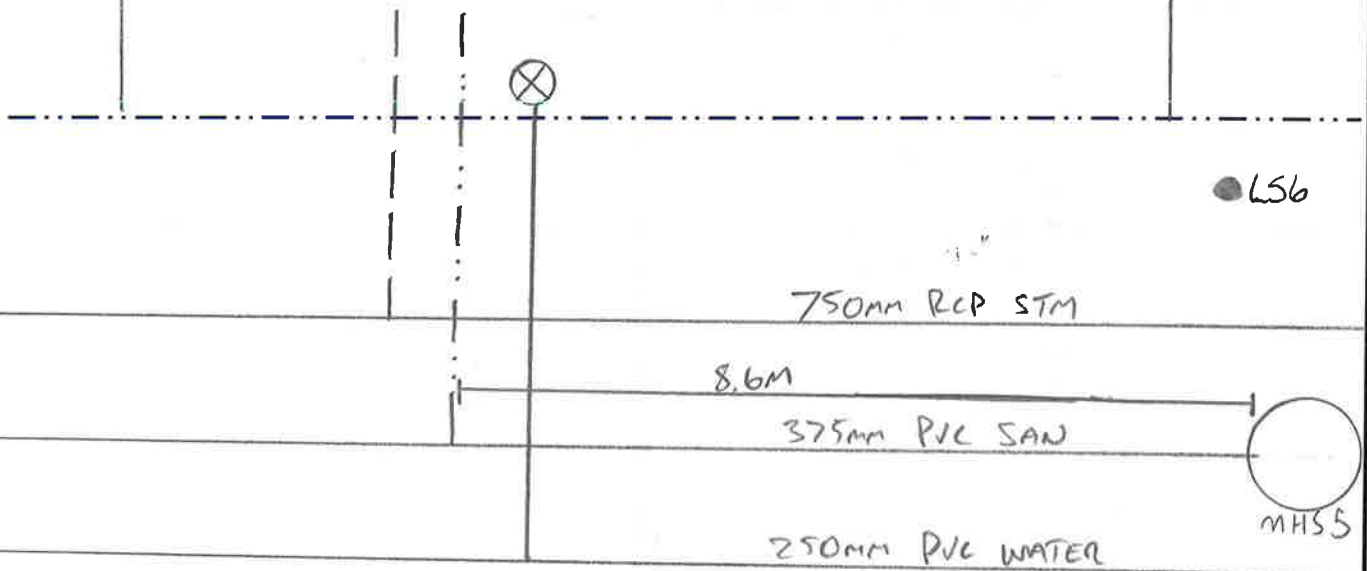

CURB STOP TO LS6 = 23.8m
 CURB STOP TO L57 = 14.4m
 CORP. STOP TO LS6 = 24.6m
 CORP. STOP TO L57 = 4.9m

● L57



SEE REVERSE FOR DETAILS →



HALIFAX REGIONAL WATER COMMISSION

SERVICE CONNECTION CARD

STREET BRUNELLO BLVDLOT 226 CIVIC _____

HRM SUBDIVISION #: _____

PERMIT #: _____

SLID _____

PUBLIC

	WATER	SANITARY	STORM
LENGTH:	9.50M	8.31M	6.65M
MATERIAL:	MUNICIPAL	DOC DAZ8	MCDR35
SIZE:	250mm	125mm	100mm
COLOUR:	BLUE	WHITE	GREEN
DEPTH @ MAIN:	1.7M	2.6M	2.8M
DEPTH @ ST. LINE:	1.72M	2.22M	2.22M
T.O.P. ELEV. @ MAIN:	91.7M	90.8M	90.6M
T.O.P. ELEV. @ ST. LINE:	91.98M	91.48M	91.48M
MAIN SIZE:	250mm	375mm	750mm
CURB STOP TO ST. LINE*:	0.73M		
ST. LINE TO STUB*:		2.54M	2.57M

*IF APPLICABLE

CONTRACTOR: DEATER CONSTRUCTION
 INSPECTED BY: WSP
 DATE: APRIL 2018
 RECORD DWG. #: 121-24187 SHEET 2

INSULATION: YES NO
 ROCK: YES NO
 CLAY PLUG: YES NO
 TRACE WIRE: YES NO
 ANODE: YES NO
 DRIVEWAY CULVERT: YES NO
 PRE-CAST HEADWALLS: YES NO

DRIVEWAY CULVERT SIZE
 MATERIAL

ADDITIONAL NOTES & COMMENTS:

PRIVATE

	WATER	SANITARY	STORM
LENGTH:			
MATERIAL:			
SIZE:			
COLOUR:			
DEPTH @ BLDG:			

CONTRACTOR: _____
 INSPECTED BY: _____
 DATE: _____

INSULATION: YES NO
 ROCK: YES NO
 CLAY PLUG: YES NO
 TRACE WIRE: YES NO
 SOUND CHECK: YES NO

FOUNDATION DRAIN CONNECTED: YES NO
 RAIN LEADERS CONNECTED: YES NO
 SANITARY TYPE: PRESSURE GRAVITY

PRIVATE LIFT STATION INFO: LIFT: _____
 DISTANCE: _____

ADDITIONAL NOTES & COMMENTS:



HALIFAX REGIONAL WATER COMMISSION
SERVICE CONNECTION CARD

STREET BRUNELLO BLVD


LOT 226 CIVIC _____

LOT 225

LOT 226

LOT 227

PRIVATE

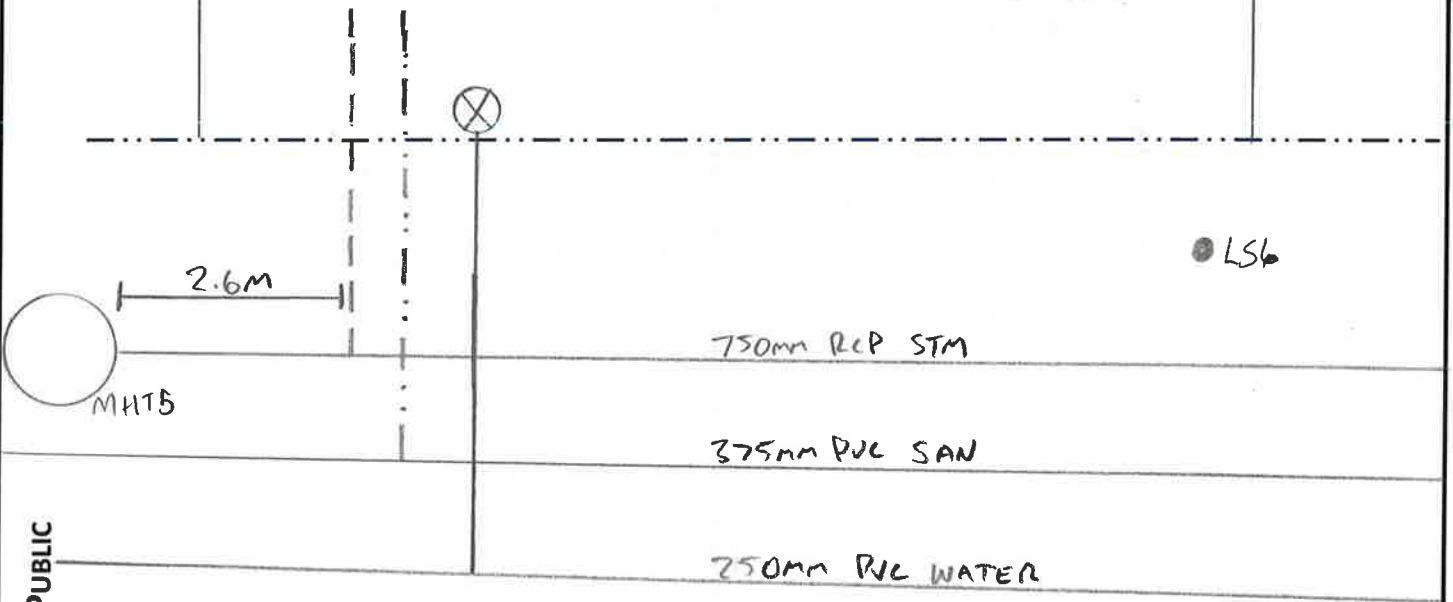

PUBLIC

CURB STOP TO LST6 = 9.7m
 CURB STOP TO LST7 = 22.6m
 CORP. STOP TO LST6 = 11.1m
 CORP. STOP TO LST7 = 18.1m

● LST



SEE REVERSE FOR DETAILS →



HALIFAX REGIONAL WATER COMMISSION
SERVICE CONNECTION CARD

STREET BRUNELLO BLVD


LOT 227 CIVIC _____

LOT 226

LOT 227

LOT 228

PRIVATE

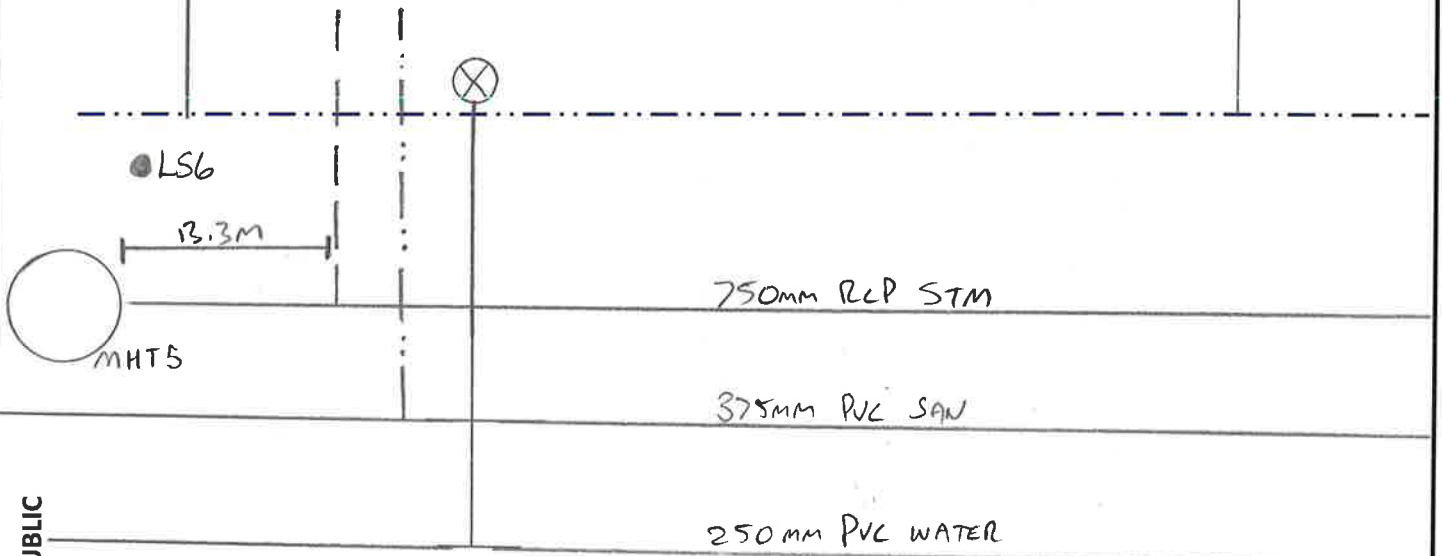

PUBLIC

CURB STOP TO L55 = 22.6m
 CURB STOP TO L56 = 4.3m
 CORP. STOP TO L55 = 18.0m
 CORP. STOP TO L56 = 6.7m



SEE REVERSE FOR DETAILS →



HALIFAX REGIONAL WATER COMMISSION

SERVICE CONNECTION CARD

STREET BURNELL BLVD
 LOT 228 CIVIC _____

HRM SUBDIVISION #: _____

PERMIT #: _____

SLID _____

PUBLIC

	WATER	SANITARY	STORM
LENGTH:	9.53M	8.30M	6.75M
MATERIAL:	Municipal	PVC DR 28	PVC DR 35
SIZE:	25mm	125mm	100mm
COLOUR:	Blue	White	Green
DEPTH @ MAIN:	1.7M	2.6M	2.7M
DEPTH @ ST. LINE:	1.67M	2.14M	2.17M
T.O.P. ELEV. @ MAIN:	93.4M	92.5M	92.4M
T.O.P. ELEV. @ ST. LINE:	93.59M	93.11M	93.08M
MAIN SIZE:	250mm	375mm	750mm
CURB STOP TO ST. LINE*:	0.57M		
ST. LINE TO STUB*:		2.47M	2.48M

*IF APPLICABLE

CONTRACTOR: DEXTER CONSTRUCTION
 INSPECTED BY: WSP
 DATE: APRIL 2018
 RECORD DWG. #: 121-24187 SHEET 2

- INSULATION: YES NO
- ROCK: YES NO
- CLAY PLUG: YES NO
- TRACE WIRE: YES NO
- ANODE: YES NO
- DRIVEWAY CULVERT: YES NO
- PRE-CAST HEADWALLS: YES NO

DRIVEWAY CULVERT SIZE MATERIAL

ADDITIONAL NOTES & COMMENTS:

PRIVATE

WATER	SANITARY	STORM

LENGTH: _____
 MATERIAL: _____
 SIZE: _____
 COLOUR: _____
 DEPTH @ BLDG: _____
 CONTRACTOR: _____
 INSPECTED BY: _____
 DATE: _____

- INSULATION: YES NO
- ROCK: YES NO
- CLAY PLUG: YES NO
- TRACE WIRE: YES NO
- SOUND CHECK: YES NO

- FOUNDATION DRAIN CONNECTED: YES NO
- RAIN LEADERS CONNECTED: YES NO
- SANITARY TYPE: PRESSURE GRAVITY

PRIVATE LIFT STATION INFO: LIFT: _____
 DISTANCE: _____

ADDITIONAL NOTES & COMMENTS:



HALIFAX REGIONAL WATER COMMISSION
SERVICE CONNECTION CARD

STREET BUNNELL BLVD
 LOT 228 CIVIC _____

LOT 227

LOT 228

LOT 229

PRIVATE

PUBLIC

● L56



750mm RCP STM

20.6m

375mm PVC SAN

250mm PVC WATER



MHS6

CURB STOP TO L55 = 14.7m

CURB STOP TO L56 = 15.9m

CORP. STOP TO L55 = 5.7m

CORP. STOP TO L56 = 16.9m

● L55



SEE REVERSE FOR DETAILS →



HALIFAX REGIONAL WATER COMMISSION

SERVICE CONNECTION CARD

STREET BROUEN BLVD
 LOT 229 CIVIC _____

HRM SUBDIVISION #: _____

PERMIT #: _____

SLID _____

PUBLIC

	WATER	SANITARY	STORM
LENGTH:	9.57M	8.37M	6.84M
MATERIAL:	MUNICIPAL	PVC DR 28	PVC DR 35
SIZE:	25mm	125mm	100mm
COLOUR:	Blue	White	Green
DEPTH @ MAIN:	1.8m	2.7m	2.8m
DEPTH @ ST. LINE:	1.72m	2.2m	2.2m
T.O.P. ELEV. @ MAIN:	94.3m	93.4m	93.3m
T.O.P. ELEV. @ ST. LINE:	94.48m	94.01m	94.00m
MAIN SIZE:	250mm	375mm	750mm
CURB STOP TO ST. LINE*:	0.54M		
ST. LINE TO STUB*:		2.40	2.47M

*IF APPLICABLE

CONTRACTOR: DEXTER CONSTRUCTION
 INSPECTED BY: WSP
 DATE: APRIL 2018
 RECORD DWG. #: 121-24197 SHEET 2

INSULATION:	<input checked="" type="checkbox"/> YES	<input type="checkbox"/> NO
ROCK:	<input checked="" type="checkbox"/> YES	<input type="checkbox"/> NO
CLAY PLUG:	<input type="checkbox"/> YES	<input checked="" type="checkbox"/> NO
TRACE WIRE:	<input checked="" type="checkbox"/> YES	<input type="checkbox"/> NO
ANODE:	<input checked="" type="checkbox"/> YES	<input type="checkbox"/> NO
DRIVEWAY CULVERT	<input type="checkbox"/> YES	<input checked="" type="checkbox"/> NO
PRE-CAST HEADWALLS	<input type="checkbox"/> YES	<input checked="" type="checkbox"/> NO

DRIVEWAY CULVERT SIZE _____
 MATERIAL _____

ADDITIONAL NOTES & COMMENTS:

PRIVATE

WATER	SANITARY	STORM

LENGTH: _____
 MATERIAL: _____
 SIZE: _____
 COLOUR: _____
 DEPTH @ BLDG: _____
 CONTRACTOR: _____
 INSPECTED BY: _____
 DATE: _____

INSULATION:	<input type="checkbox"/> YES	<input type="checkbox"/> NO
ROCK:	<input type="checkbox"/> YES	<input type="checkbox"/> NO
CLAY PLUG:	<input type="checkbox"/> YES	<input type="checkbox"/> NO
TRACE WIRE:	<input type="checkbox"/> YES	<input type="checkbox"/> NO
SOUND CHECK:	<input type="checkbox"/> YES	<input type="checkbox"/> NO

FOUNDATION DRAIN CONNECTED:	<input type="checkbox"/> YES	<input type="checkbox"/> NO
RAIN LEADERS CONNECTED:	<input type="checkbox"/> YES	<input type="checkbox"/> NO
SANITARY TYPE:	<input type="checkbox"/> PRESSURE	<input type="checkbox"/> GRAVITY

PRIVATE LIFT STATION INFO: LIFT: _____
 DISTANCE: _____

ADDITIONAL NOTES & COMMENTS:



HALIFAX REGIONAL WATER COMMISSION
SERVICE CONNECTION CARD

STREET BROWNELL BLVD

LOT 229 CIVIC _____


LOT 228

LOT 229

LOT 230

PRIVATE

PUBLIC

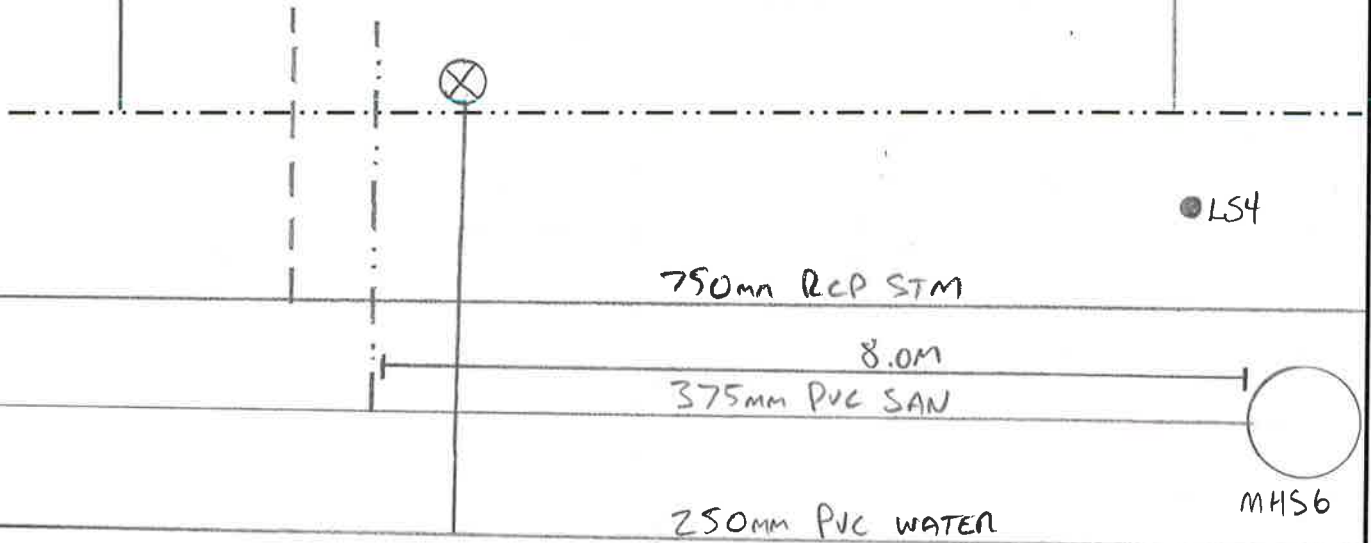

CURB STOP TO LS4 = 17.3m
CURB STOP TO LSS = 16.4m
CORP. STOP TO LS4 = 17.9m
CORP. STOP TO LSS = 9.4m



SEE REVERSE FOR DETAILS →



HALIFAX REGIONAL WATER COMMISSION

SERVICE CONNECTION CARD

STREET BRUNSWICK BLVD

LOT 230 CIVIC _____

HRM SUBDIVISION #: _____

PERMIT #: _____

SLID _____

PUBLIC

	WATER	SANITARY	STORM
LENGTH:	10.06M	7.80M	6.94M
MATERIAL:	Municipal	INC DN 28	INC DN 35
SIZE:	25mm	125mm	100mm
COLOUR:	BLUE	WHITE	GREEN
DEPTH @ MAIN:	1.9m	2.5m	2.9m
DEPTH @ ST. LINE:	1.74M	2.13M	2.15M
T.O.P. ELEV. @ MAIN:	94.9m	94.3m	93.9m
T.O.P. ELEV. @ ST. LINE:	95.12M	94.72M	94.70M
MAIN SIZE:	250mm	375mm	750mm
CURB STOP TO ST. LINE*:	0.51M		
ST. LINE TO STUB*:		2.41M	2.51M

*IF APPLICABLE

CONTRACTOR: Dexter Construction
 INSPECTED BY: WSP
 DATE: APRIL 2018
 RECORD DWG. #: 171-24187 SMOCT 2

INSULATION:	<input checked="" type="checkbox"/> YES	<input type="checkbox"/> NO
ROCK:	<input checked="" type="checkbox"/> YES	<input type="checkbox"/> NO
CLAY PLUG:	<input type="checkbox"/> YES	<input checked="" type="checkbox"/> NO
TRACE WIRE:	<input checked="" type="checkbox"/> YES	<input type="checkbox"/> NO
ANODE:	<input checked="" type="checkbox"/> YES	<input type="checkbox"/> NO
DRIVEWAY CULVERT	<input type="checkbox"/> YES	<input checked="" type="checkbox"/> NO
PRE-CAST HEADWALLS	<input type="checkbox"/> YES	<input checked="" type="checkbox"/> NO

DRIVEWAY CULVERT SIZE _____
 MATERIAL _____

ADDITIONAL NOTES & COMMENTS:

PRIVATE

WATER	SANITARY	STORM

LENGTH: _____
 MATERIAL: _____
 SIZE: _____
 COLOUR: _____
 DEPTH @ BLDG: _____
 CONTRACTOR: _____
 INSPECTED BY: _____
 DATE: _____

INSULATION:	<input type="checkbox"/> YES	<input type="checkbox"/> NO
ROCK:	<input type="checkbox"/> YES	<input type="checkbox"/> NO
CLAY PLUG:	<input type="checkbox"/> YES	<input type="checkbox"/> NO
TRACE WIRE:	<input type="checkbox"/> YES	<input type="checkbox"/> NO
SOUND CHECK:	<input type="checkbox"/> YES	<input type="checkbox"/> NO

FOUNDATION DRAIN CONNECTED:	<input type="checkbox"/> YES	<input type="checkbox"/> NO
RAIN LEADERS CONNECTED:	<input type="checkbox"/> YES	<input type="checkbox"/> NO
SANITARY TYPE:	<input type="checkbox"/> PRESSURE	<input type="checkbox"/> GRAVITY

PRIVATE LIFT STATION INFO: LIFT: _____
 DISTANCE: _____

ADDITIONAL NOTES & COMMENTS:



HALIFAX REGIONAL WATER COMMISSION
SERVICE CONNECTION CARD

STREET BROUVELLO BLVD

LOT 230 CIVIC


LOT 229

LOT 230

LOT 231

PRIVATE

PUBLIC

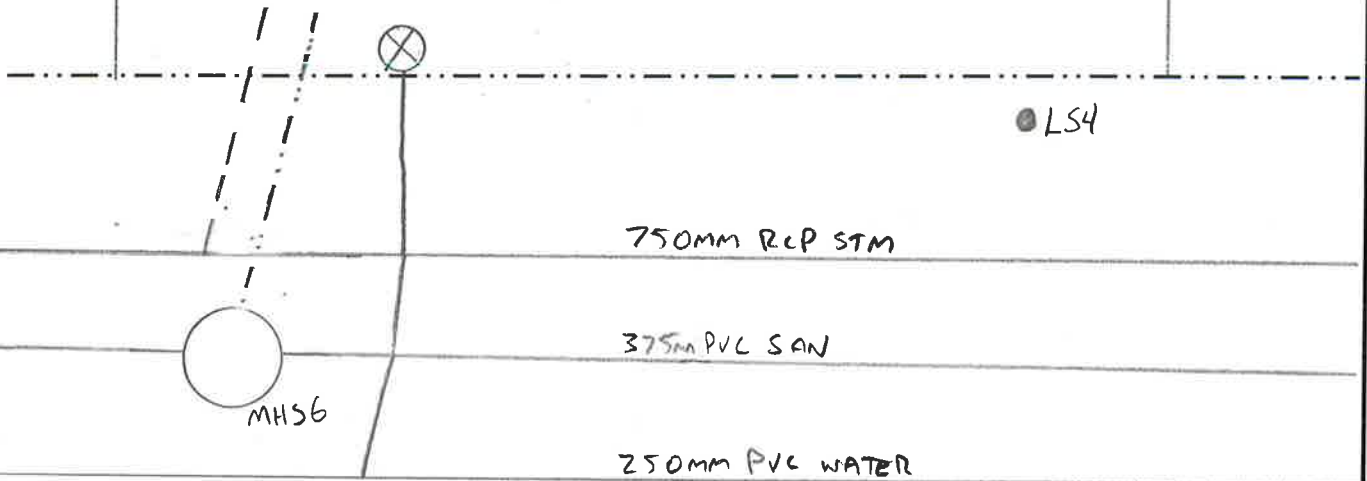

CURBSTOP TO LS4 = 7.1m
 CURBSTOP TO L55 = 23.8m
 CORP. STOP TO LS4 = 9.0m
 CORP. STOP TO L55 = 19.3m

LS5



SEE REVERSE FOR DETAILS →



HALIFAX REGIONAL WATER COMMISSION

SERVICE CONNECTION CARD

STREET BROWNELL BLVDLOT 231 CIVIC _____

HRM SUBDIVISION #: _____

PERMIT #: _____

SLID _____

PUBLIC

	WATER	SANITARY	STORM
LENGTH:	10.76m	9.61m	7.86m
MATERIAL:	Munic 1820	PVC DN 28	PVC DN 35
SIZE:	25mm	125mm	160mm
COLOUR:	Blue	White	Green
DEPTH @ MAIN:	1.8m	2.7m	2.9m
DEPTH @ ST. LINE:	1.74m	2.29m	2.38m
T.O.P. ELEV. @ MAIN:	95.6m	94.7m	94.5m
T.O.P. ELEV. @ ST. LINE:	95.86m	95.31m	95.22m
MAIN SIZE:	250mm	375mm	750mm
CURB STOP TO ST. LINE*:	0.52m		
ST. LINE TO STUB*:		2.39m	2.46m

*IF APPLICABLE

CONTRACTOR:

DEXTER CONSTRUCTION

INSPECTED BY:

WSP

DATE:

APRIL 2018

RECORD DWG. #:

121-24187 SHEET 2

INSULATION:

 YES NO

ROCK:

 YES NO

CLAY PLUG:

 YES NO

TRACE WIRE:

 YES NO

ANODE:

 YES NO

DRIVEWAY CULVERT

 YES NO

PRE-CAST HEADWALLS

 YES NO

DRIVEWAY CULVERT

SIZE

MATERIAL

ADDITIONAL NOTES & COMMENTS:

PRIVATE

WATER	SANITARY	STORM

LENGTH:

MATERIAL:

SIZE:

COLOUR:

DEPTH @ BLDG:

CONTRACTOR:

INSPECTED BY:

DATE:

INSULATION:

YES

NO

ROCK:

YES

NO

CLAY PLUG:

YES

NO

TRACE WIRE:

YES

NO

SOUND CHECK:

YES

NO

FOUNDATION DRAIN CONNECTED:

YES

NO

RAIN LEADERS CONNECTED:

YES

NO

SANITARY TYPE:

PRESSURE

GRAVITY

PRIVATE LIFT STATION INFO:

LIFT:

DISTANCE:

ADDITIONAL NOTES & COMMENTS:



HALIFAX REGIONAL WATER COMMISSION
SERVICE CONNECTION CARD

STREET Brunello Blvd

LOT 231 CIVIC _____

LOT 230

LOT 231

LOT 232

PRIVATE

← MMS6

PUBLIC

● LS4

750mm RCP STM

12.5m

375mm PVC SAN

250mm PVC WATER



CURB STOP TO LS3 = 23.3m
 CURB STOP TO LS4 = 7.0m
 CORP. STOP TO LS3 = 18.7m
 CORP. STOP TO LS4 = 9.4m

● LS3



SEE REVERSE FOR DETAILS →



HALIFAX REGIONAL WATER COMMISSION

SERVICE CONNECTION CARD

STREET Brunello Blvd


LOT 232 CIVIC _____

LOT
231

LOT 232

PRIVATE

PUBLIC

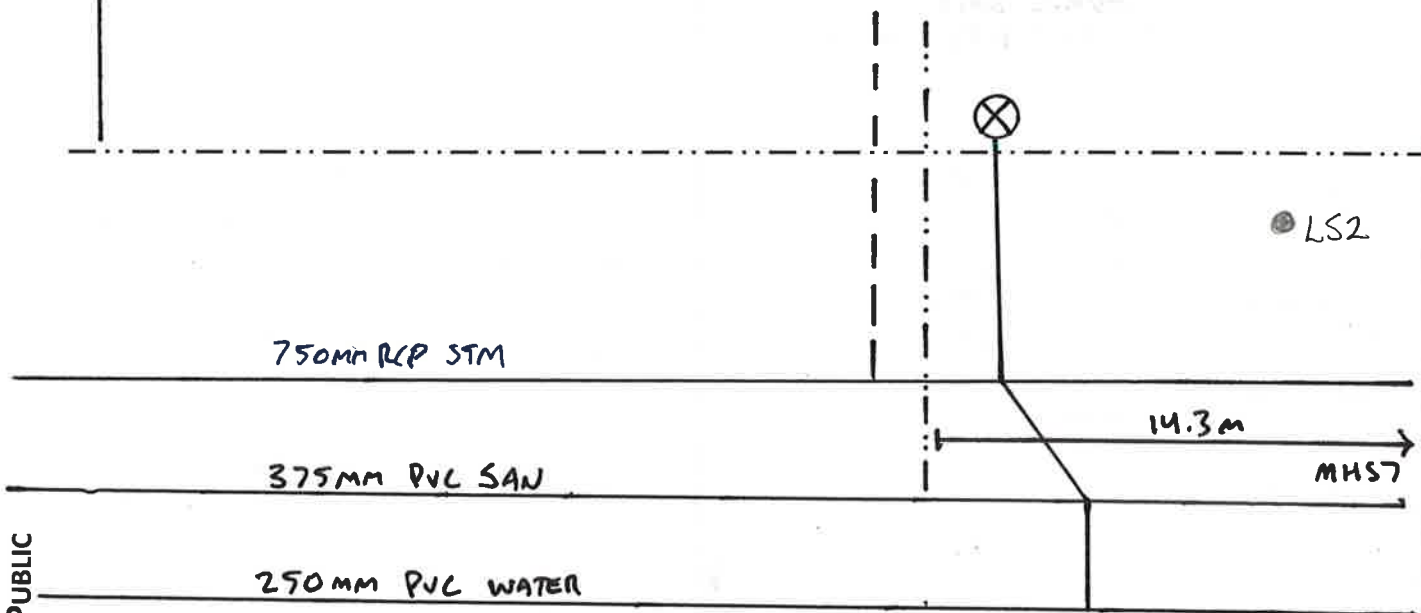

750mm RCP STM

375mm PVC SAN

250mm PVC WATER

● LS2

14.3m

MHS7

- CURB STOP TO LS2 = 8.5m
- CURB STOP TO LS3 = 14.4m
- CORP. STOP TO LS2 = 13.8m
- CORP. STOP TO LS3 = 2.9m

● LS3



SEE REVERSE FOR DETAILS →



HALIFAX REGIONAL WATER COMMISSION

SERVICE CONNECTION CARD

STREET TIMBERLEA VILLAGE PARKWAY

LOT BLOCK 6 CIVIC _____

PRIVATE

BRUNELLO BVD.

BLOCK 6

200mm WATER

250mm WATERMAIN

RIGHT OF WAY

EASEMENT

750mm STORM

MH

MH


STU

STORM WATER STORAGE AREA

200mm SANITARY

MH

RIGHT OF WAY

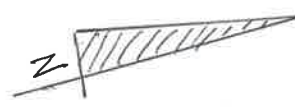

200mm SANITARY

375mm SANITARY

PUBLIC

TIMBERLEA VILLAGE PARKWAY

SEE REVERSE FOR DETAILS →